

## ADDENDUM #01

TO

INVITATION TO BID #01

---

ALTERATIONS TO

ACES at CHASE

565 CHASE PARKWAY, WATERBURY, CT

STATE PROJECT NO. 244-0044 MAG

DECEMBER 11, 2025

---

DECEMBER 18, 2025

Bids are modified and/or supplemented as follows and should be included in the Subcontractor's lump sum bid as it relates to their Bid Package Scope of Work:

---

### GENERAL INFORMATION

All Bid Package Scopes of Work:

1. **ALL BIDS FOR ALL BID PACKAGES ARE TO BE SUBMITTED** in duplicate at the **ACES Staff Development Building located 205 Skiff Street, Hamden, Connecticut 06517, Attention: Downes Construction Company, LLC.** on **January 13, 2026 by 2:00pm** with the date and time indicated, after which time no further bids will be accepted. All bidders must include the Project Name and Bid Package Number & Description in the subject line of their email, for example, 'ACES at Chase – BP# 32.1 – Exterior Improvements'. Bids received will subsequently be opened publicly.
2. It is the responsibility of all bidders to review the drawings received against the Drawing List. If any drawings are missing from the bidding documents notify the Construction Manager immediately.
3. ALL Bidding Requirements listed in the original bidding documents remain as is, unless revised by the contents of this Addendum.
4. **ALL Bidders** should note that any unanswered pre-bid RFI's up to this point will be answered in forthcoming addendum.
5. **ALL Bidders** shall reference and incorporate the **attached** CHRO Good Faith Efforts Short Form Plan (GFE) which was formerly known as the Affirmative Action Plan (AAP)/ Set Aside Plan into the bid documents.
6. **ALL Bidders** should review and incorporate the **attached Bulletin #1 dated December 16, 2025** prepared by **S/P+A** and their consultants. This Addendum includes:
  - Changes to Drawings & Specifications
  - New drawings & New Specifications.Refer to the Bulletin for complete contents and how it may affect your Bid Package Scope.

ATTACHMENTS AS INDICATED ABOVE

END ADDENDUM #01 – INVITATION TO BID #01

**Good Faith Efforts Plan  
Short Form**

**Effective 10/1/2025**

**COVER PAGE**

Company Name: \_\_\_\_\_

Company Address: \_\_\_\_\_

Telephone No.: \_\_\_\_\_

Facsimile No.: \_\_\_\_\_

Email Address: \_\_\_\_\_

Web Site Address: \_\_\_\_\_

Date Submitted: \_\_\_\_\_

GFE Plan Prepared by: \_\_\_\_\_

Name and Title of Head of  
Company: \_\_\_\_\_

This Good Faith Efforts Plan is  
submitted for (Name of  
project): \_\_\_\_\_

State Contract/Project No.: \_\_\_\_\_

Awarding Authority: \_\_\_\_\_

Total Contract Value: \_\_\_\_\_

M/W/DisBE Value as Assigned  
by the Awarding Authority: \_\_\_\_\_ %      \$ \_\_\_\_\_

SBE Value as Assigned by the  
Awarding Authority: \_\_\_\_\_ %      \$ \_\_\_\_\_

## Table of Contents

---

**Note:** A Good Faith Efforts Plan (GFEP) meeting all the requirements of the following sections must be filed for each state-funded project

**Note:** A submission that does not adhere to this formatting may be rejected before it is reviewed. Any section that does not include a response to said section and/or its subsections herein will not be in compliance.

Section Number and Title	Page Number
Section 1: Affirmative Action/Equal Employment Policy Statement.....	3
Section 2: Internal Communications .....	3
Section 3: External Communications .....	3
Documentation Requirements.....	3
Section 4: Project Description, Timeline, and Trades Involved.....	4
Section 5: Subcontractor Availability Analysis .....	6
Section 6: Minority Business Enterprise Goals and Timetables .....	9
Attachment III .....	10
Section 7: Close Out Documentation Notice.....	12
Section 8: Concluding Statement.....	13

## **Note For All Plans Filed and Reviewed After October 1, 2025:**

---

The Good Faith Efforts Plan (GFEP) is an updated version reflective of recent Connecticut legislation that will be effective as of October 1, 2025. Any GFEP filed after that date will no longer require submissions for the following sections:

### **Section 1: Affirmative Action/Equal Employment Policy Statement**

### **Section 2: Internal Communications**

### **Section 3: External Communications**

Any plan filed prior to October 1<sup>st</sup> that is still under review by the CHRO at that time will not receive a disapproval on account of any deficiencies in these sections.

## **Documentation Requirements**

---

The following documentation is required to accompany this plan submission for all plans. Additional documentation requests may be made during the course of the review process in order to determine whether good faith efforts were made to comply with the statutory requirements:

- **A copy of the bid document for the public works contract**  
Please attach a copy of the contract's bid document (project manual, ITB, etc.) that specifies all the trades-related work, non-trades related work, and all materials required for the work on this project. Only include the portions necessary to verify your company's responses. *Please do not provide the full document.*
- **DAS Supplier Diversity Certifications**  
Please provide a copy of the Dept. of Administrative Services (DAS) Supplier Diversity Certificate for any subcontractor hired by you to work on this project.
- **Bid Tabulations**  
Please provide bid tabulations for all trade/service/material subcontracts awarded by your company on this project using the [form available on our website](#).



## Section 4: Project Description, Timeline, and Trades Involved

---

This section of the GFEP must detail everything that will be needed to perform the work of this specific project. If the question is not relevant to the project, a response of “N/A” is acceptable.

1. In 1–3 sentences, briefly describe the project and the work involved.
2. Estimate (mm/dd/yyyy) when construction will commence. If the project has already begun, provide the actual project mobilization date (mm/dd/yyyy). Specify whether the date provided is actual or estimated.
3. Estimate (mm/dd/yyyy) when construction will be completed. If the project is complete, provide the project end date (mm/dd/yyyy). Specify whether the date provided is actual or estimated.
4. List all of the types of trades-related for which your company will be hiring a subcontractor(s). Do not provide the name of the subcontractor(s). Only identify the specific work, not the type of worker.
5. List all specific types of materials to be used for this project that your company will be purchasing. Do not provide the name of the vendor(s).
6. List all specific types of non-trades-related services to be used for this project that your company will hire a service company to provide. Do not provide the name of the company.  

**Ex:   Portable toilets**  
**Trucking, Driver Only – No labor involved**
7. List all trades-related services that will be self-performed by your company's employees. Only identify the specific work, not the type of worker.

8. List all supplies that will be manufactured by your company for use on this project.

## Section 5: Subcontractor Availability Analysis

---

**PART A:** Before filling out the rest of this section, please check the DAS Supplier Diversity Program Database to confirm that every Small Business Enterprise (SBE), Minority-Business Enterprise (MBE), Women-Owned Business Enterprise (WBE), and Disabled Person-Owned Business Enterprise (DisBE) has an active certificate.

[Follow this link to access the DAS Supplier Diversity Program Database.](#)

**PART B:** List every SBE/MBE/WBE/DisBE subcontractor and/or vendor that your company solicited to bid on **this** contract, as shown in the example below.

For each subcontractor, indicate the trades-related work for which it was solicited. For each vendor, indicate the non-trades-related work or the materials for which it was solicited.

For example:

Company Name	DAS-Certification Type	Type of Trade/Vendor
ABC Construction	SBE	Rough Carpentry
Carpenter's LLC	DisBE	Rough Carpentry
Hard Knocks Woodwork	MBE	Rough Carpentry
Rumor Mill	MBE	Mill Work
The Mill Worm	MBE	Mill Work
Piece Mill	WBE	Mill Work
XYZ Material Suppliers	WBE	Hardwood Supplier
Best Floor Co.	DisBE	Hardwood Supplier
Got 2 Go	SBE	Portable toilets
Number 1	MBE	Portable toilets
When Nature Call	SBE	Portable toilets

Company Name	DAS-Certification Type	Type of Trade/Vendor


**PART C:** Indicate the bid outcome for each company listed in Part B. Your company must be able to explain and document to the CHRO the reason(s) why your company did not award a subcontract to each of the companies solicited in Part B. An overly vague response, such as “Bid Received,” “Called/Left Message,” “Said Will Bid” etc., is insufficient. For those companies that you will utilize for this project, use “Awarded” as the bid result.

For example:

Company Name	DAS Certification Type	Reason for Awarding/Not Awarding
ABC Construction	Rough Carpentry	Bid Incomplete
Carpenter's LLC	Rough Carpentry	Bid Too High
Hard Knocks Woodwork	Rough Carpentry	Bid Too High
Rumor Mill	Mill Work	Awarded
The Mill Worm	Mill Work	Bid Too High
XYZ Material Suppliers	Hardwood Supplier	Bid Too High
Best Floor Co.	Hardwood Supplier	Declined To Bid
Got 2 Go	Portable toilets	Declined To Bid
Number 1	Portable toilets	Bid Too High
When Nature Call	Portable toilets	Scheduling Conflict

Company Name	DAS Certification Type	Reason for Awarding/Not Awarding

**PART D:** List all non-S/M/W/DisBE companies (i.e., companies not already accounted for in Part B & Part C) that your company will use on this project. This list must inform CHRO of all trade-related work, materials, and/or non-trades-related services that the companies listed will provide. Any company performing a specialized trade or supplying specialized materials/services must be indicated and accompanied by a letter attesting to such from (i.e., signed) by the awarding agency. See the example below.

For example:

Company Name	Type of Trade/Vendor
Color Coded Painting, LLC	Rough Carpentry
Pristine Port-a-lets	Portable toilets
Boltz, Inc.	High and Low Voltage Installation*

\*The electrical portion of this project is specialized and can only be performed by Boltz, Inc. Please see the attached letter verifying such, in detail, from the project manager at the awarding agency.

Company Name	Type of Trade/Vendor

## Section 6: Minority Business Enterprise Goals and Timetables

---

On Attachment III:

- Provide all the information requested in the Attachment III.
- List all the MBEs, WBEs, and DisBEs you designated in Section 5–Part C as “Awarded” in the top portion (“A”) of Attachment III.
- List all the SBEs you designated in Section 5–Part C as “Awarded” in the bottom portion (“B”) of Attachment III.
- Input all percentages requested in the Attachment III.

Once your company’s Plan is approved, your company may not add or delete any of the companies nor alter any of the contract values as listed on the Attachment III of your company’s approved Plan, except as follows. After your company’s Plan is approved, Attachment III may be altered only if your company submits the following items:

- I) A cover letter that
  - A) Requests acknowledgement of the change and
  - B) Details the reason(s) why the CHRO should grant the change.
- II) Documentation that verifies the reason(s) for removal or addition
  - A) For removal: confirmation that the business is closed, a change order from the owner that eliminates a subcontractor’s portion of the project, etc.
  - B) For addition: a copy of the company’s current DAS S/M/W/DisBE certification;
- II) A Revised Attachment III listing the date of the revision (in mm/dd/yyyy format) and incorporating the requested change.

**NOTE:** Upon a project’s completion, only those companies that are listed on the latest approved Attachment III, and who have maintained a current DAS Supplier Diversity certification throughout the duration of the project, will be utilized in the CHRO’s final calculations of actual goal achievement upon the project’s completion.

The CHRO encourages your company to not just meet its spending allocation goals, but to surpass them in order to ensure project circumstances (e.g., delays, change orders, decrease between estimate amount and contract amount) do not cause your company to fall below the spending allocation goals as projected in its approved Good Faith Efforts Plan.

A current copy of the DAS certificate must be attached to this section for each subcontractor/vendor listed on Attachment III. ***Without a current copy of each company’s valid DAS Supplier Diversity certification, the value of the contract will not be taken into account for the determination of whether your company has met its spending allocation goals.***

### Attachment III

Total Project Contract Value \$ \_\_\_\_\_.

State-funded Portion of the Contract Value \$ \_\_\_\_\_.

- A. Please identify MBE/WBE/DisBE subcontractors/vendors who will participate on the project.

Company Name	Address	DAS Certification Type (MBE/WBE/DisBE)	DAS Certification Expiration Date	Contract Value
			Total amount of MBE, WBE, & DisBE contract values: \$	(Total amount of MBE, WBE, & DisBE contract values ÷ project value x 100) %

- B. Please identify SBE contractors/vendors who will participate on the project.

Company Name	Address	DAS Certification Type (SBE)	DAS Certification Expiration Date	Contract Value
			Total amount of SBE contract values: \$	Total amount of SBE contract values ÷ project value x 100= %
Total amount of all contract values listed in A & B =			\$	Total amount of all contract values listed in A & B ÷ project value x 100 = %

- C. Please identify all non-DAS certified contractors/vendors who will participate on the project.

Company Name	Address	Contract Value
		Total amount of non-certified companies contract values ÷ project value x 100=
		%
Total amount of all contract values listed in A & B & C ÷ project value x 100 =		
		%

*Please use additional sheets if necessary*

\*\*Please use the **State-funded Portion** of the Contract Value to calculate the achieved goal **percentages**.

\*\*The sum of all contract values listed in A, B and C should equal the **Total Project Contract Value**.

---

## Section 7: Close Out Documentation Notice



Please note that this section no longer requires monthly compliance forms to be filed. This is a change from the previous plan format.

Contractors are required to provide the following documentation within forty-five (45) days from the date of substantial completion. Failure to submit this documentation may result in an enforcement action being brought.

Within 45 days of substantial completion, please provide:

- Notice of Substantial Completion from the project owner.
- A full and complete list of all subcontractors/vendors/service providers awarded for the project.
- Lien waivers for all of the awarded subcontractors/vendors/service providers awarded for the project.

If you have any questions, please contact the Contract Compliance unit for assistance.

☐

**I understand my obligations to provide the above documentation within forty-five (45) days of my company's substantial completion date.**

## Section 8: Concluding Statement

---

I have read and pledge my full support to all sections of this Good Faith Efforts Plan, and that the commitments therein, are true and correct to the best of my knowledge. I pledge my “best good faith efforts” to achieve the objectives of the Plan within the established time frames.

Furthermore, this company will comply with any request by the Commission for records and documents. It understands that failure to do so may subject this company to enforcement action by the Commission.

Click or tap to enter a date.

---

Date

---

Head of Company's Signature

---

Printed Name and Title

## ALTERATIONS

**ACES at CHASE  
565 CHASE PARKWAY  
WATERBURY, CT 06708  
STATE PROJECT #244-0044 MAG**

S/P+A PROJECT #22.050

**DATE: December 16, 2025**

The following changes to the Drawings and Project Specifications shall become a part of the Drawings and Project Specifications; superseding previously issued Drawings and Project Specifications to the extent modified by Bulletin #1.

**New Specifications:**

- SECTION 090561.13, MOISTURE VAPOR EMISSION CONTROL has been added and is attached as part of this bulletin. (4) *(Per Owner Request)*

**Changes to the Specifications:**

- TABLE OF CONTENTS, Page 3, Division 09 – Finishes, add the following:

“Section 090561.13          Moisture Vapor Emission Control          4” *(Per Owner Request)*

- DRAWING LIST, Page 4, Plumbing Drawings:

- Revise “P051-1-P109-1” to read “P051-1-P108-1”.
- Add the following:

“P109-1          BUILDING 1 – UNDER SLAB PLAN – PLUMBING” *(Per Internal Review)*

- SECTION 035416, HYDRAULIC CEMENT UNDERLAYMENT:

- Page 2:

- Article 2.2.A., after “1/4-inch” add “(per coat).”
- Article 2.2.A.1.a., revise “**K 520**” to read “**K 15**”.
- Article 2.2.A.4., revise “6000” to read “5500”. *(Per Internal Review)*

- SECTION 088000, GLAZING:

- Page 12:

- Article 3.12.B., revise to read as follows:

“Glass Type **GL-10**: Low-e coated, clear, tempered insulating glass.

1. Overall Unit Thickness: 1-inch.
2. Thickness of Each Glass Lite: 1/4-inch.
3. Outdoor Lite: Fully tempered float glass.
4. Interspace Content: Argon.

5. Indoor Lite: Fully tempered float glass.
6. Low-E Coating: Pyrolitic on second surface.
7. Provide safety glazing labeling.”

- Articles 3.12.D. and .G., delete in their entirety.

- Page 13, Article 3.13.H., delete in its entirety.
- Page 14, Article 3.14.A., revise to read as follows:

“Glass Type **GL-6**: Fire-rated glazing with 450 deg F temperature rise limitation; laminated glass with intumescent interlayers.” *(Per Internal Review)*

- SECTION 096516, RESILIENT SHEET FLOORING, Page 4, Article 3.2.C., add to the end the following:

“Comply with requirements in Section 035416, “Hydraulic Cement Underlayment”. *(Per Internal Review)*

- SECTION 096519, RESILIENT TILE FLOORING, Page 4, Article 3.2.C., add to the end the following:

“Comply with requirements in Section 035416, “Hydraulic Cement Underlayment”. *(Per Internal Review)*

- SECTION 096813, TILE CARPETING, Page 4, Article 3.2.B., add to the end the following:

“Comply with requirements in Section 035416, “Hydraulic Cement Underlayment”. *(Per Internal Review)*

#### **New Drawings:**

- Building 1, DRAWING P109-1, BUILDING 1 – UNDER SLAB PLAN - PLUMBING has been added and is attached as part of this bulletin.\* *(Per Internal Review)*

#### **Changes to the Drawings:**

- Building 1:
  - DRAWING G001-1, BUILDING 1 – GENERAL INFORMATION & DRAWING LIST, delete in its entirety. A new DRAWING G001-1 has been added and is attached as part of this bulletin.\* *(Per Internal Review)*
  - The following STRUCTURAL drawings have been deleted in their entirety. New drawings (2) have been added and are attached as part of this bulletin\*:
    - S150-1 BUILDING 1 – ROOF FRAMING PLAN – OVERALL *(Per Internal Review)*
    - S400-1 FLOOR SECTIONS *(Per Internal Review)*
  - DRAWING P001-1, BUILDING 1 – COVER SHEET – PLUMBING, delete in its entirety. A new DRAWING P001-1 has been added and is attached as part of this bulletin.\* *(Per Internal Review)*
  - The following MECHANICAL drawings have been deleted in their entirety. New drawings (3) have been added and are attached as part of this bulletin\*:

- 
- M111-1 BUILDING 1 – MAIN LEVEL PLAN – DUCTWORK *(Per Cx)*
  - M211-1 BUILDING 1 – MAIN LEVEL PLAN – PIPING *(Per Cx)*
  - M402-1 BUILDING 1 – SCHEDULES - MECHANICAL *(Per Cx)*
  - The following ELECTRICAL drawings have been deleted in their entirety. New drawings (5) have been added and are attached as part of this bulletin\*:
    - E200-1 BUILDING 1 – BASEMENT LEVEL POWER PLAN *(Per Internal Review)*
    - E210-1 BUILDING 1 – MAIN LEVEL POWER PLAN *(Per Internal Review)*
    - E220-1 BUILDING 1 – SECOND LEVEL POWER PLAN *(Per Internal Review)*
    - E230-1 BUILDING 1 – THIRD LEVEL POWER PLAN *(Per Internal Review)*
    - E400-1 BUILDING 1 – DETAILS *(Per Cx)*
  - Building 2:
    - The following ELECTRICAL drawings have been deleted in their entirety. New drawings (4) have been added and are attached as part of this bulletin\*:
      - E200-2 BUILDING 2 – LOWER LEVEL POWER PLAN – PART 'A' *(Per Internal Review)*
      - E210-2 BUILDING 2 – MAIN LEVEL POWER PLAN – PART 'A' *(Per Internal Review)*
      - E220-2 BUILDING 2 – MEZZANINE LEVEL POWER PLAN – PART 'A' *(Per Internal Review)*
      - E400-2 BUILDING 2 – DETAILS *(Per Cx)*
  - Building 4:
    - The following ELECTRICAL drawings have been deleted in their entirety. New drawings (3) have been added and are attached as part of this bulletin\*:
      - E200-4 BUILDING 4 – MAIN LEVEL POWER PLAN *(Per Internal Review)*
      - E210-4 BUILDING 4 – UPPER LEVEL POWER PLAN *(Per Internal Review)*
      - E400-4 BUILDING 4 – DETAILS *(Per Cx)*
  - Building 5, DRAWING E400-5, BUILDING 5 – DETAILS, delete in its entirety. A new DRAWING E400-5 has been added and is attached as part of this bulletin.\* *(Per Cx)*
  - Building 6, DRAWING E400-6, BUILDING 6 – DETAILS, delete in its entirety. A new DRAWING E400-6 has been added and is attached as part of this bulletin.\* *(Per Cx)*

The bulletin consists of seven (7) pages of 8½" x 11" text and twenty-two (22) 30" x 42" drawings\*.  
End of Bulletin #1

## SECTION 090561.13 - MOISTURE VAPOR EMISSION CONTROL

## PART 1 - GENERAL

## 1.1 RELATED DOCUMENTS

- A. Drawings and general provisions of the Contract, including General and Supplementary Conditions and Division 01 Specification Sections, apply to this Section.

## 1.2 SUMMARY

## A. Section Includes:

- 1. Fluid-applied, resin-based, membrane-forming systems that control the moisture-vapor-emission rate of high-moisture, interior concrete to prepare it for floor covering installation.

## B. Related Sections:

- 1. Section 012100 "Allowances" for work of this Section included in allowances.
- 2. Section 035416 "Hydraulic Cement Underlayment" for underlayment installed over moisture vapor control system.

## 1.3 DEFINITIONS

## A. MVE: Moisture vapor emission.

## B. MVER: Moisture vapor emission rate.

## 1.4 ACTION SUBMITTALS

- A. Product Data: For each type of product, including installation instructions.

## 1.5 INFORMATIONAL SUBMITTALS

## A. Qualification Data: For Installer and manufacturer.

## B. Product Test Reports: For each MVE-control system, for tests performed by manufacturer and witnessed by a qualified testing agency.

## C. Sample Warranties: For special warranties.

## 1.6 QUALITY ASSURANCE

## A. Manufacturer Qualifications:

- 1. Produces moisture vapor control systems for not less than ten (10) years.
- 2. Employs factory-trained personnel who are available for consultation and Project-site inspection.

## B. Installer Qualifications: An authorized representative who is trained and approved by manufacturer.

## 1.7 DELIVERY, STORAGE, AND HANDLING

- A. Deliver materials in original packages and containers, with seals unbroken, bearing manufacturer's labels indicating directions for storage and mixing with other components. Each container shall be marked with batch or lot code traceable to manufacturing information.
- B. Store products in an approved ventilated dry area; protect from dampness, freezing, and direct sunlight.
- C. Handle products using methods that prevent breakage or damage of containers and prevent contamination of products.

## 1.8 FIELD CONDITIONS

- A. Environmental Limitations: Comply with MVE-control system manufacturer's written instructions for substrate and ambient temperatures, humidity, ventilation, and other conditions affecting system installation.
  - 1. Store system components in a temperature-controlled environment and protected from weather and at ambient temperature of not less than 50 deg F and not more than 85 deg F at least 48 hours before use.
  - 2. Maintain ambient temperature and relative humidity in installation areas within range recommended in writing by MVE-control system manufacturer, but not less than 50 deg F or more than 85 deg F and not less than forty percent (40%) or more than sixty percent (60%) relative humidity, for 48 hours before installation, during installation, and for 48 hours after installation unless longer period is recommended in writing by manufacturer.
  - 3. Install MVE-control systems where concrete surface temperatures will remain a minimum of 5 deg F higher than the dew point for ambient temperature and relative humidity conditions in installation areas for 48 hours before installation, during installation, and for 48 hours after installation unless longer period is recommended in writing by manufacturer.

## 1.9 WARRANTY

- A. Special Warranties:
  - 1. Manufacturer's standard fifteen (15) year warranty.
  - 2. Installer's standard workmanship warranty, a minimum of one (1) year.

## PART 2 - PRODUCTS

### 2.1 PERFORMANCE REQUIREMENTS

- A. MVE-Control System Capabilities: Capable of suppressing MVE without failure where installed on concrete that exhibits the following conditions:
  - 1. MVER: 25 lb. of water/1000 sq. ft. when tested according to ASTM F 1869.
  - 2. Relative Humidity: Maximum one hundred percent (100%) when tested according to ASTM F 2170 using in situ probes.
- B. Water-Vapor Transmission: Through MVE-control system, maximum 0.10 perm when tested according to ASTM E 96.

## 2.2 MVE-CONTROL SYSTEM

- A. Basis-of-Design:
  - 1. Ardex Engineered Cements; **MC RAPID**
- B. Manufacturers: Subject to compliance with requirements, available manufacturers offering products that may be incorporated into the Work include, but are not limited to, the following:
  - 1. KOSTER American Corporation
  - 2. Laticrete International, Inc.
  - 3. Maxxon Corporation
- C. MVE-Control System: ASTM F 3010-qualified, fluid-applied, two-component, epoxy-resin, membrane-forming system; formulated for application on concrete substrates to reduce MVER to level required for installation of floor coverings indicated and acceptable to manufacturers of floor covering products indicated, including adhesives.
  - 1. Substrate Primer: Provide MVE-control system manufacturer's concrete-substrate primer if required for system indicated by substrate conditions.
  - 2. Cementitious Underlayment Primer: If required for subsequent installation of cementitious underlayment products, provide MVE-control system manufacturer's primer to ensure adhesion of products to MVE-control system.

## 2.3 ACCESSORIES

- A. Patching and Leveling Material: Moisture-, mildew-, and alkali-resistant product recommended in writing by MVE-control system manufacturer and with minimum of 3000-psi compressive strength after twenty-eight (28) days when tested according to ASTM C 109.
- B. Crack-Filling Material: Resin-based material recommended in writing by MVE-control system manufacturer for sealing concrete substrate crack repair.
- C. Cementitious Underlayment: If required to maintain manufacturer's warranty, provide MVE-control system manufacturer's hydraulic cement-based underlayment. Comply with requirements in Section 035416 "Hydraulic Cement Underlayment".

## PART 3 - EXECUTION

### 3.1 EXAMINATION

- A. Examine substrates and conditions, with Installer present, for compliance with requirements for maximum moisture content, installation tolerances, and other conditions affecting performance of the Work.
- B. Proceed with installation only after unsatisfactory conditions have been corrected.
  - 1. Installation of system indicates acceptance of surfaces and conditions.

### 3.2 PREPARATION

- A. Concrete Substrates: Prepare and clean substrates according to MVE-control system manufacturer's written instructions to ensure adhesion of system to concrete.



1. Remove coatings and other substances that are incompatible with MVE-control system and that contain soap, wax, oil, or silicone, using mechanical methods recommended in writing by MVE-control system manufacturer. Do not use solvents.
  2. Provide concrete surface profile complying with ICRI 310.2R CSP 3 by shot blasting using apparatus that abrades the concrete surface with shot, contains the dispensed shot within the apparatus, and recirculates the shot by vacuum pickup.
  3. After shot blasting, repair damaged and deteriorated concrete according to MVE-control system manufacturer's written instructions.
  4. Protect substrate voids and joints to prevent resins from flowing into or leaking through them.
  5. Fill surface depressions and irregularities with patching and leveling material.
  6. Fill surface cracks, grooves, control joints, and other non-moving joints with crack-filling material.
  7. Allow concrete to dry, undisturbed, for period recommended in writing by MVE-control system manufacturer after surface preparation, but not less than 24 hours.
  8. Before installing MVE-control systems, broom sweep and vacuum prepared concrete.
- B. Protect walls, floor openings, electrical openings, door frames, and other obstructions during installation.


### 3.3 INSTALLATION

- A. Install MVE-control system according to ASTM F 3010 and manufacturer's written instructions to produce a uniform, monolithic surface free of surface deficiencies such as pin holes, fish eyes, and voids.
1. Install primers as required to comply with manufacturer's written instructions.
- B. Do not apply MVE-control system across substrate expansion, isolation, and other moving joints.
- C. Apply system, including component coats if any, in thickness recommended in writing by MVE-control system manufacturer.
- D. Cure MVE-control system components according to manufacturer's written instructions. Prevent contamination or other damage during installation and curing processes.
- E. After curing, examine MVE-control system for surface deficiencies. Repair surface deficiencies according to manufacturer's written instructions.

### 3.4 PROTECTION

- A. Protect MVE-control system from damage, wear, dirt, dust, and other contaminants before floor covering installation. Use protective methods and materials, including temporary coverings, recommended in writing by MVE-control system manufacturer.
- B. Do not allow subsequent pre-installation examination and testing for floor covering installation to damage, puncture, or otherwise compromise the MVE-control system membrane.

END OF SECTION 090561.13

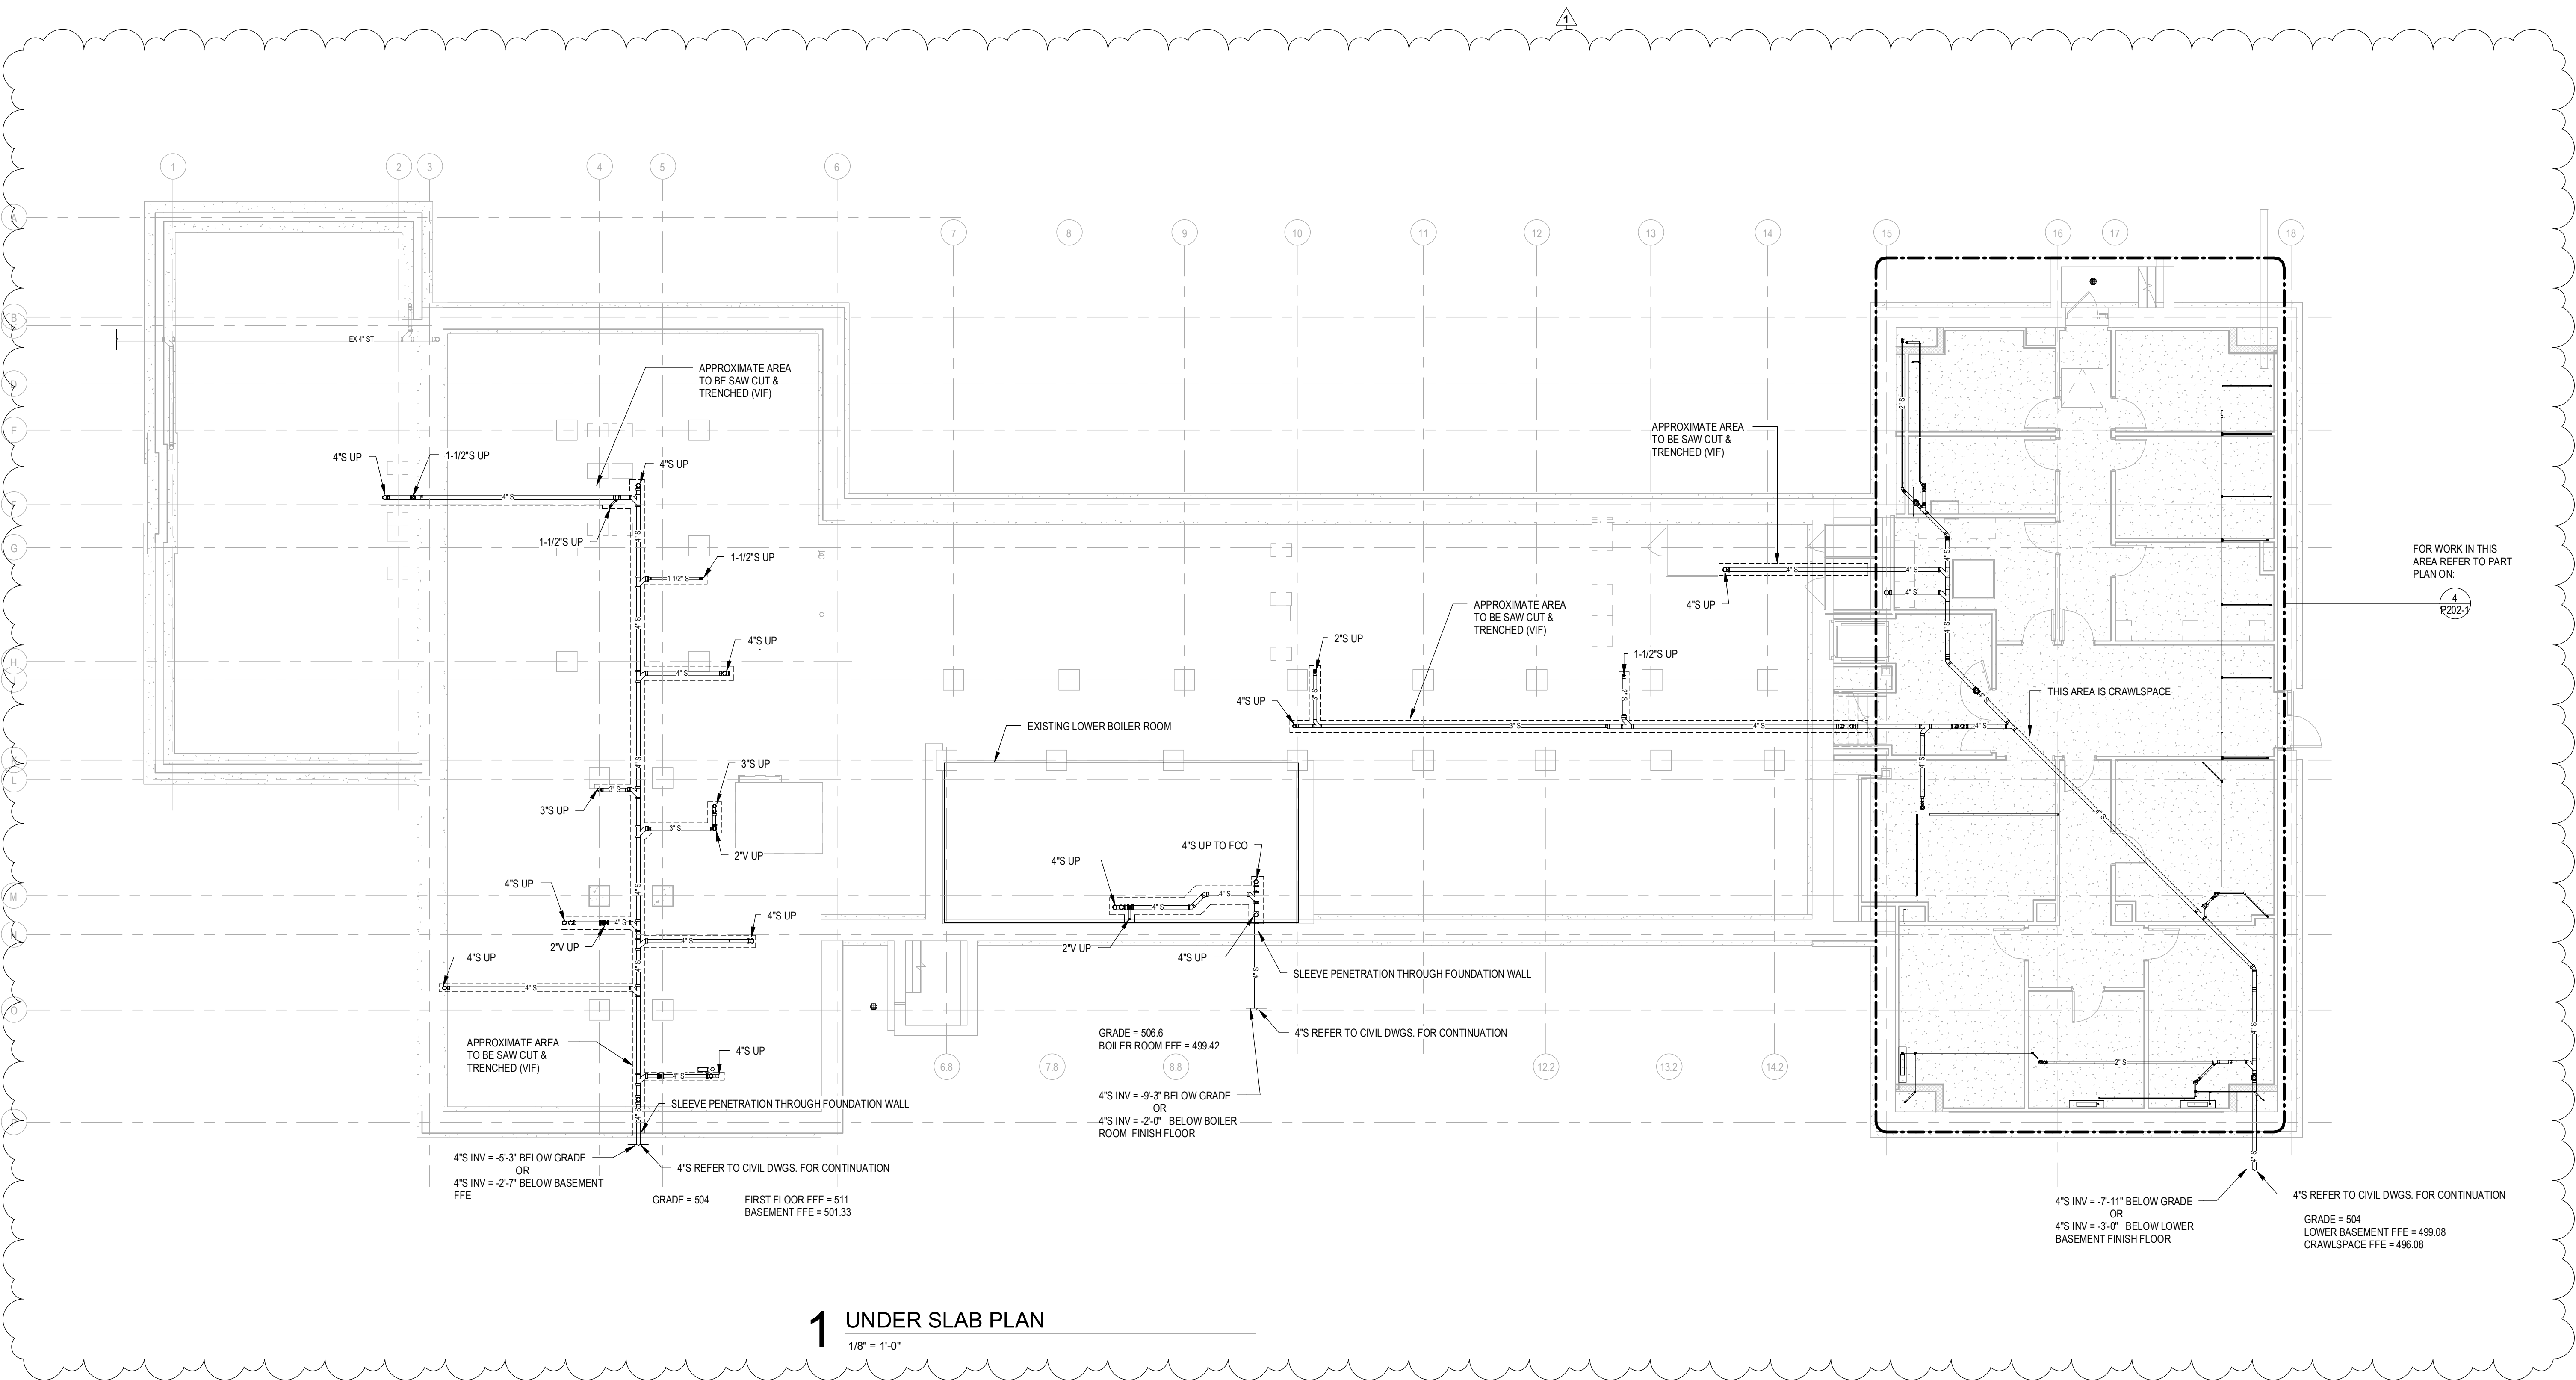

**1 UNDER SLAB PLAN**

1/8" = 1'-0"

Project Title:  
**ALTERATIONS TO:  
ACES at Chase**  
565 Chase Parkway  
Waterbury, Connecticut 06708



**SILVER PETRUCCELLI + ASSOCIATES**  
3190 WHITNEY AVENUE HAMDEN CT 06518  
311 STATE STREET NEW LONDON CT 06320  
203 230 9007 silverpetrucci.com

Revision:	Description:	Date:	Revised By:
1	Bulletin #1	12/16/25	MPB

Drawing Title:  
**BUILDING 1 - UNDER SLAB PLAN -  
PLUMBING**  
Project Phase:  
**ISSUED FOR BID - 11/03/2025**  
State Project Number:  
**#244-0044 MAG**

Date:  
AUGUST 12, 2025  
Scale:  
1/8" = 1'-0"  
Drawn By:  
MPB  
Project Number:  
22.050

Drawing Number:

**P109-1**

12/15/2025 3:10:56 PM

ABBREVIATIONS

A.C.T.	ACOUSTICAL CEILING TILE
ADJ.	ADJUSTABLE
ALUM.	ALUMINUM
A.B.	ANCHOR BOLT
APPROX.	APPROXIMATE
ARCH.	ARCHITECTURAL
A.C.P.	ASBESTOS CEMENT PIPE
ASPH.	ASPHALT
AVG.	AVERAGE
BSMT.	BASEMENT
BRG.	BEARING
BT	BITUMINOUS
BLK.	BLOCK
BO.	BOARD
B.S.	BOTH SIDES
BRK.	BRICK
BLDG.	BUILDING
C.I.	CAST IRON
C.I.P.	CAST IN PLACE CONCRETE
C.B.	CATCH BASIN
C.B.R.	CATCH BASIN TO BE REMOVED
CLG.	CEILING
C.	CENTER LINE
C.BD.	CHALK BOARD
C.O.	CLEAN OUT
COL.	COLUMN
CONC.	CONCRETE
C.M.U.	CONCRETE MASONRY UNIT
CONF.	CONFERENCE
CONT.	CONTINUOUS, CONTINUE
CONTR.	CONTRACTOR
C.J.	CONTROL JOINT
C.C.	CURB CUT
DET.	DETAIL
DIA.	DIAMETER
DIM.	DIMENSION
DR.	DOOR
DN.	DOWN
DWG.	DRAWING
EA.	EACH
E.F. / E.W.	EACH FACE / EACH WAY
ED.	EDUCATION
E / ELEC.	ELECTRICAL
EL / ELEV.	ELEVATION
EMER.	EMERGENCY
ENCL.	ENCLOSURE
ENTR.	ENTRANCE
EP.	EPOXY PAINT
EQ.	EQUAL
EXAM.	EXAMINATION
EXIST.	EXISTING
EXP.	EXPANSION
E.J.	EXPANSION JOINT
EXT.	EXTERIOR
F.S.	FAR SIDE
FIN.	FINISH, FINISHED
FF.	FINISHED FLOOR
FKT.	FIXTURE
FL.	FLOOR
F.P.	FOLDING PARTITION
FT.	FOOT
FTG.	FOOTING
FDN.	FOUNDATION
G.	GAS
GA.	GAUZE
GEN.	GENERAL
G.C.	GENERAL CONTRACTOR
GYP.	GYPSUM
CYP. BO.	GYPSUM BOARD
H.C.	HANDICAPPED
HWIE.	HARDWARE
HD.	HEADED
HGT.	HEIGHT
H.P.	HIGH POINT
H.M.	HOLLOW METAL
HORIZ.	HORIZONTAL, HORIZONTALLY
H.B.	HOSE BIB
HR.	HOUR
HYD.	HYDRANT
INSUL.	INSULATION, INSULATED
INT.	INTERIOR
INV.	INVERTED
JAN.	JANITOR
K.P.	KICK PLATE
LAM.	LAMINATE
L.F.	LINEAR FOOT
L.G.	LONG
LOC.	LOCATION
L.P.	LOW POINT
LGT.	LIGHTING
M.H.	MANHOLE
MAS.	MASONRY
M.O.	MASONRY OPENING
MAX.	MAXIMUM
MECH.	MECHANICAL
MIN.	MINIMUM
M.	MINUTE
MISC.	MISCELLANEOUS
MTD.	MOUNTED
N.S.	NEAR SIDE
NOM.	NOMINAL
N.A.	NOT APPLICABLE
N.I.C.	NOT IN CONTRACT
N.T.S.	NOT TO SCALE
NO.	NUMBER
OCC.	OCCUPANT
O.C.	ON CENTER
OPNG.	OPENING
O.D.	OUTSIDE DIMENSION
PTD.	PAINTED
P.C.B.	PAINTED CONCRETE BLOCK
P.G.B.	PAINTED GYPSUM BOARD
PL.	PLATE
PLUMB.	PLUMBING
PREP.	PREPARATION, PREPARE
P.T.	PRESSURE TREATED
PROJ. MAN.	PROJECT MANUAL
P.V.C.	POLYVINYL CHLORIDE
RAD.	RADIUS
R.C.P.	REINFORCED CONCRETE PIPE
RCF.	REFLECTED CEILING PLAN
REINF.	REINFORCEMENT
REQD.	REQUIRED
R.	RISER
R.D.	ROOF DRAIN
R.H.	ROOF HATCH
RL.	ROOF LEADER
RM.	ROOM
SAN.	SANITARY
SCHED.	SCHEDULE
S.C.	SEALED CONCRETE
SECT.	SECTION
S.W.	SHEAR WALL
S.W.F.	SHEAR WALL FOOTING
S.M.	SIMILAR

GRAPHIC LEGEND

	CONCRETE		FINISHED WOOD
	CONCRETE MASONRY UNITS		BATT INSULATION
	BRICK		RIGID INSULATION
	STONE		GYPSUM BOARD
	METALS		NEW SINGLE DOOR
	COMPACTED GRAVEL		NEW DOUBLE DOOR
	EARTH		EXISTING DOOR TO REMAIN
	PLYWOOD		- REMOVE EXISTING DOOR
	WOOD FRAMING - THROUGH MEMBER		
	WOOD FRAMING - INTERRUPTED MEMBER		

GENERAL NOTES

- CONTRACTOR SHALL FIELD VERIFY ALL EXISTING CONDITIONS & DIMENSIONS PRIOR TO FABRICATION, FURNISHING AND INSTALLATION OF ANY MATERIALS, EQUIPMENT AND WORK.
- ALL MATERIALS & EQUIPMENT SHOWN ARE NEW TO BE PROVIDED BY CONTRACTOR UNLESS OTHERWISE NOTED.
- ALL EXISTING UTILITIES & EQUIPMENT LOCATIONS ARE APPROXIMATE - CONTRACTOR SHALL FIELD VERIFY AND/OR COORDINATE EXACT LOCATIONS.
- CONTRACTOR ASSUMES ALL RESPONSIBILITY DURING CONSTRUCTION TO PROTECT MATERIALS AND EQUIPMENT. ANY & ALL DAMAGED ITEMS & EQUIPMENT DURING CONSTRUCTION SHALL BE REPLACED AT NO ADDITIONAL COST TO THE OWNER.
- ALL RATED DOORS & DOORS FRONTING A CORRIDOR SHALL HAVE POSITIVE LATCHING LOCKSETS UNLESS OTHERWISE INDICATED ON THE DOOR SCHEDULE.
- ALL DOORS LEADING TO HAZARDOUS AREAS SHALL HAVE TACTILE WARNING.
- ALL DOORS EXITING 50 PERSONS OR MORE SHALL HAVE PANIC EXIT DEVICES.
- ALL HANDICAP ACCESSIBLE DOOR HARDWARE SHALL BE PROVIDED TO COMPLY WITH ADA, ANSI AND ALL OTHER APPLICABLE CODES.
- ALL NEW EXPOSED/VISIBLE DECKING, BEAMS, COLUMNS, JOISTS AND OTHER STRUCTURAL COMPONENTS SHALL BE PAINTED UNLESS OTHERWISE NOTED.
- IF A NOTE IS FOUND ON ARCHITECTURAL DRAWINGS READING - "SEE STRUCTURAL DRAWINGS" - AND SIZE AND DETAILING OF MEMBERS IS NOT FOUND, THE CONTRACTOR SHALL CONTACT THE ARCHITECT TO REQUEST MISSING INFORMATION. THESE ITEMS SHALL BE PART OF THE BASE BID AND STEEL SUBCONTRACTOR SHALL REVIEW STRUCTURAL AS WELL AS ARCHITECTURAL DRAWINGS PRIOR TO BIDDING.
- ALL CONTRACTORS SHALL REVIEW DRAWINGS AND PROJECT MANUAL. IF THERE IS A DISCREPANCY BETWEEN THE TWO OR ANY OTHER PARTS OF THE DOCUMENTS, THE HIGHER VALUE (IN DOLLARS) SHALL PREVAIL AS THE SCOPE OF WORK THAT WILL BE PRICED UNLESS OTHERWISE DIRECTED IN WRITING BY THE ARCHITECT DURING THE BIDDING PERIOD.
- PATCH ALL EXISTING WALLS AND OTHER SURFACES AFFECTED BY DEMOLITION AND REMOVAL WITH MATERIALS TO MATCH EXISTING.
- SAW CUT AND REMOVE PORTIONS OF CONCRETE SLAB AS REQUIRED TO ACCOMMODATE NEW PLUMBING, ELECTRICAL, MECHANICAL, AND OTHER TRADES. COORDINATE WIDTH AND DEPTH OF TRENCHING WITH M.E.P. DRAWINGS FOR SCOPE OF NEW WORK REQUIRED.
- WALL OPENINGS RESULTING FROM REMOVAL OF DUCTS, PIPES, CONDUITS, ETC. SHALL BE FILLED WITH MATERIALS TO MATCH THE WALL. SEE M.E.P. DRAWINGS FOR LOCATIONS OF REMOVAL.
- WHERE NEW DUCTS, PIPES, AND CONDUIT PASS THROUGH EXISTING WALLS, PROVIDE OPENING AND HEADER AS REQUIRED AND SEAL THE PERIMETER OF THE PENETRATIONS FOR SOUND TRANSMISSION RESISTANCE AND FIRE RATING WHERE INDICATED ON CODE PLANS AND OTHER DRAWINGS. ALSO SEE MEP DRAWINGS.

SYMBOL LEGEND

	- DOOR NUMBER
	- WINDOW TYPE
	- ROOM NAME
	- ROOM NUMBER
	- PARTITION TYPE
	- CONSTRUCTION NOTE
	- GLAZING TYPE
	- EXTERIOR ELEVATION NUMBER
	- SHEET NUMBER
	- INTERIOR ELEVATION NUMBER
	- BUILDING SECTION NUMBER
	- SHEET NUMBER
	- WALL SECTION NUMBER
	- SHEET NUMBER
	- REFERENCE POINT
	- REVISION MARK

LIST OF DRAWINGS

VOLUME 1

GENERAL DRAWINGS

G001-1	BUILDING 1 - GENERAL INFORMATION AND DRAWING LIST
G002-1	BUILDING 1 - CODE PLANS & INFORMATION
G003-1	BUILDING 1 - CODE PLANS
G004-1	BUILDING 1 - CODE PLANS

ENVIRONMENTAL DRAWINGS

HM-1	BUILDING 1 - CRAWL SPACE, LOWER LEVEL & MAIN LEVEL ABATEMENT PLAN
HM-2	BUILDING 1 - SECOND LEVEL, THIRD LEVEL & ROOF ABATEMENT PLAN

STRUCTURAL DRAWINGS

S000-1	GENERAL NOTES
S110-1	BUILDING 1 - BASEMENT / FOUNDATION PLAN
S120-1	BUILDING 1 - MAIN FLOOR FRAMING PLAN
S130-1	BUILDING 1 - SECOND LEVEL FLOOR FRAMING PLAN
S140-1	BUILDING 1 - THIRD LEVEL FLOOR FRAMING PLAN
S150-1	BUILDING 1 - ROOF FRAMING PLAN - OVERALL
S300-1	FOUNDATION SECTIONS
S400-1	FLOOR SECTIONS
S600-1	TYPICAL DETAILS
S801-1	TYPICAL DETAILS

ARCHITECTURAL DRAWINGS

A001-1	BUILDING 1 - BASEMENT LEVEL EXISTING PLAN
A002-1	BUILDING 1 - MAIN LEVEL EXISTING PLAN
A003-1	BUILDING 1 - SECOND LEVEL EXISTING PLAN
A004-1	BUILDING 1 - THIRD LEVEL EXISTING PLAN
A005-1	BUILDING 1 - EXISTING ROOF / PENTHOUSE PLAN
A010-1	BUILDING 1 - BASEMENT LEVEL CRAWL SPACE DEMOLITION PLANS
A011-1	BUILDING 1 - BASEMENT LEVEL DEMOLITION RCP
A020-1	BUILDING 1 - MAIN LEVEL DEMOLITION PLANS
A030-1	BUILDING 1 - SECOND LEVEL DEMOLITION PLANS
A040-1	BUILDING 1 - THIRD LEVEL DEMOLITION PLANS
A050-1	BUILDING 1 - ROOF / PENTHOUSE DEMOLITION PLAN
A110-1	BUILDING 1 - BASEMENT LEVEL AND CRAWL SPACE FLOOR PLANS
A120-1	BUILDING 1 - MAIN LEVEL FLOOR PLAN
A130-1	BUILDING 1 - SECOND LEVEL FLOOR PLAN
A140-1	BUILDING 1 - THIRD LEVEL FLOOR PLAN
A150-1	BUILDING 1 - ROOF / PENTHOUSE PLANS
A151-1	BUILDING 1 - 3D REFERENCE VIEWS - ROOF
A230-1	MAIN BUILDING - BASEMENT AND MAIN LEVEL FURNITURE PLAN
A231-1	MAIN BUILDING - SECOND AND THIRD LEVEL FURNITURE PLAN
A250-1	BUILDING 1 - BASEMENT LEVEL RCP
A251-1	BUILDING 1 - MAIN LEVEL RCP
A252-1	BUILDING 1 - SECOND LEVEL RCP
A253-1	BUILDING 1 - THIRD LEVEL AND PENTHOUSE RCP
A254-1	BUILDING 1 - CEILING DETAILS
A260-1	BUILDING 1 - BASEMENT LEVEL FLOOR PATTERN & FINISH PLAN
A261-1	BUILDING 1 - MAIN LEVEL FLOOR PATTERN & FINISH PLAN
A262-1	BUILDING 1 - SECOND LEVEL FLOOR PATTERN & FINISH PLAN
A263-1	BUILDING 1 - THIRD LEVEL FLOOR PATTERN & FINISH PLAN
A300-1	BUILDING 1 - OVERALL EXTERIOR ELEVATIONS
A301-1	BUILDING 1 - OVERALL EXTERIOR ELEVATIONS
A400-1	BUILDING 1 - BUILDING SECTIONS
A401-1	BUILDING 1 - BUILDING SECTIONS
A440-1	BUILDING 1 - ELEVATOR PLANS AND SECTIONS
A441-1	BUILDING 1 - ELEVATOR DETAILS
A442-1	BUILDING 1 - ENLARGED STAIR / LIFT PLAN AND DETAILS
A443-1	BUILDING 1 - LIFT PLANS AND DETAILS
A460-1	BUILDING 1 - EXTERIOR STAIR PLANS AND DETAILS
A470-1	BUILDING 1 - INTERIOR PERSPECTIVE VIEWS FOR REFERENCE
A471-1	BUILDING 1 - INTERIOR PERSPECTIVE VIEWS FOR REFERENCE
A472-1	BUILDING 1 - INTERIOR PERSPECTIVE VIEWS FOR REFERENCE
A500-1	BUILDING 1 - PLAN DETAILS
A530-1	BUILDING 1 - TYPICAL ROOF DETAILS - LOW SLOPE
A550-1	BUILDING 1 - SECTION DETAILS
A551-1	BUILDING 1 - PLAN AND SECTION DETAILS
A560-1	BUILDING 1 - SPECIAL DETAILS
A561-1	BUILDING 1 - SPECIAL DETAILS
A600-1	BUILDING 1 - INTERIOR WINDOW ELEVATIONS AND DETAIL
A700-1	BUILDING 1 - ENLARGED PLANS
A701-1	BUILDING 1 - ENLARGED PLANS
A710-1	BUILDING 1 - INTERIOR TOILET ELEVATIONS
A730-1	BUILDING 1 - INTERIOR ELEVATIONS
A731-1	BUILDING 1 - INTERIOR ELEVATIONS
A732-1	BUILDING 1 - INTERIOR ELEVATIONS
A733-1	BUILDING 1 - INTERIOR ELEVATIONS
A734-1	BUILDING 1 - INTERIOR ELEVATIONS
A735-1	BUILDING 1 - INTERIOR ELEVATIONS
A736-1	BUILDING 1 - INTERIOR ELEVATIONS
A800-1	BUILDING 1 - CASEWORK DETAILS
A801-1	BUILDING 1 - CASEWORK DETAILS
A900-1	BUILDING 1 - PARTITION TYPES
A910-1	BUILDING 1 - DOOR SCHEDULE
A915-1	BUILDING 1 - DOOR AND FRAME ELEVATIONS AND DETAILS
A920-1	BUILDING 1 - SIGNAGE DETAILS
A940-1	BUILDING 1 - FINISH SCHEDULE

FIRE PROTECTION DRAWINGS

FP001-1	FP - BUILDING 1 - GENERAL NOTES, ABBREVIATIONS AND LEGENDS
FP110-1	FP - BUILDING 1 - LOWER LEVEL PLAN
FP120-1	FP - BUILDING 1 - MAIN LEVEL FLOOR PLAN
FP130-1	FP - BUILDING 1 - SECOND LEVEL FLOOR PLAN
FP140-1	FP - BUILDING 1 - THIRD LEVEL FLOOR PLAN
FP600-1	FP - BUILDING 1 - SCHEDULES
FP601-1	FP - BUILDING 1 - DETAILS
FP601-1	FP - BUILDING 1 - DETAILS

PLUMBING DRAWINGS

P001-1	BUILDING 1 - COVER SHEET - PLUMBING
P010-1	BUILDING 1 - LOWER LEVEL DEMOLITION PLAN - PLUMBING
P020-1	BUILDING 1 - MAIN LEVEL DEMOLITION PLAN - PLUMBING
P030-1	BUILDING 1 - SECOND LEVEL FLOOR DEMOLITION PLAN - PLUMBING
P040-1	BUILDING 1 - THIRD LEVEL FLOOR DEMOLITION PLAN - PLUMBING
P050-1	BUILDING 1 - ROOF DEMOLITION PLAN - PLUMBING
P100-1	BUILDING 1 - UNDER SLAB PLAN - PLUMBING
P110-1	BUILDING 1 - LOWER LEVEL PLAN - PLUMBING
P120-1	BUILDING 1 - MAIN LEVEL PLAN - PLUMBING
P130-1	BUILDING 1 - SECOND LEVEL FLOOR PLAN - PLUMBING
P140-1	BUILDING 1 - THIRD LEVEL FLOOR PLAN - PLUMBING
P150-1	BUILDING 1 - ROOF PLAN - PLUMBING
P200-1	BUILDING 1 - ENLARGED KITCHEN PLAN - PLUMBING
P201-1	BUILDING 1 - LOWER LEVEL PART PLANS - PLUMBING
P202-1	BUILDING 1 - LOWER LEVEL PARTIAL PLANS - PLUMBING
P203-1	BUILDING 1 - PARTIAL PLANS - PLUMBING
P204-1	BUILDING 1 - PARTIAL PLANS - PLUMBING
P205-1	BUILDING 1 - PARTIAL PLANS - PLUMBING
P300-1	BUILDING 1 - DETAILS - PLUMBING
P301-1	BUILDING 1 - DETAILS - PLUMBING
P400-1	BUILDING 1 - SCHEDULES - PLUMBING

MECHANICAL DRAWINGS

M001-1	BUILDING 1 - SYMBOLS, NOTES & ABBREVIATIONS - MECHANICAL
M010-1	BUILDING 1 - BASEMENT LEVEL AND CRAWL SPACE DEMOLITION PLAN
M011-1	BUILDING 1 - MAIN LEVEL DEMOLITION PLAN - MECHANICAL
M012-1	BUILDING 1 - SECOND LEVEL DEMOLITION PLAN - MECHANICAL
M013-1	BUILDING 1 - THIRD LEVEL DEMOLITION PLAN - MECHANICAL
M014-1	BUILDING 1 - ROOF DEMOLITION PLAN - MECHANICAL
M110-1	BUILDING 1 - BASEMENT LEVEL AND CRAWL SPACE PLAN - DUCTWORK
M111-1	BUILDING 1 - MAIN LEVEL PLAN - DUCTWORK
M112-1	BUILDING 1 - SECOND LEVEL PLAN - DUCTWORK
M113-1	BUILDING 1 - THIRD LEVEL PLAN - DUCTWORK
M210-1	BUILDING 1 - BASEMENT LEVEL AND CRAWL SPACE PLAN - PIPING
M211-1	BUILDING 1 - MAIN LEVEL PLAN - PIPING
M212-1	BUILDING 1 - SECOND LEVEL PLAN - PIPING
M213-1	BUILDING 1 - THIRD LEVEL PLAN - PIPING
M214-1	BUILDING 1 - ROOF PLAN - PIPING
M300-1	BUILDING 1 - DETAILS - MECHANICAL
M301-1	BUILDING 1 - DETAILS - MECHANICAL
M302-1	BUILDING 1 - DETAILS - MECHANICAL
M400-1	BUILDING 1 - SCHEDULES - MECHANICAL
M401-1	BUILDING 1 - SCHEDULES - MECHANICAL
M402-1	BUILDING 1 - SCHEDULES - MECHANICAL
M403-1	BUILDING 1 - SCHEDULES - MECHANICAL
M404-1	BUILDING 1 - SCHEDULES - MECHANICAL
M405-1	BUILDING 1 - SCHEDULES - MECHANICAL
M500-1	BUILDING 1 - VRF SYSTEM DIAGRAMS - MECHANICAL
M501-1	BUILDING 1 - VRF SYSTEM DIAGRAMS - MECHANICAL
M502-1	BUILDING 1 - VRF SYSTEM DIAGRAMS - MECHANICAL
M503-1	BUILDING 1 - VRF SYSTEM DIAGRAMS - MECHANICAL

ELECTRICAL DRAWINGS

E001-1	BUILDING 1 - GENERAL NOTES, SYMBOLS & ABBREVIATIONS
E002-1	BUILDING 1 - LIGHTING FIXTURE SCHEDULE
E010-1	BUILDING 1 - BASEMENT LEVEL LIGHTING DEMO PLAN
E020-1	BUILDING 1 - MAIN LEVEL LIGHTING DEMO PLAN
E030-1	BUILDING 1 - SECOND LEVEL LIGHTING DEMO PLAN
E040-1	BUILDING 1 - THIRD LEVEL LIGHTING DEMO PLAN
E050-1	BUILDING 1 - BASEMENT LEVEL POWER DEMO PLAN
E060-1	BUILDING 1 - MAIN LEVEL POWER DEMO PLAN
E070-1	BUILDING 1 - SECOND LEVEL POWER DEMO PLAN
E080-1	BUILDING 1 - THIRD LEVEL POWER DEMO PLAN
E090-1	BUILDING 1 - ROOF POWER DEMO PLAN
E100-1	BUILDING 1 - BASEMENT LEVEL LIGHTING PLAN
E110-1	BUILDING 1 - MAIN LEVEL LIGHTING PLAN
E120-1	BUILDING 1 - SECOND LEVEL LIGHTING PLAN
E130-1	BUILDING 1 - THIRD LEVEL LIGHTING PLAN
E200-1	BUILDING 1 - BASEMENT LEVEL POWER PLAN
E210-1	BUILDING 1 - MAIN LEVEL POWER PLAN
E220-1	BUILDING 1 - SECOND LEVEL POWER PLAN
E230-1	BUILDING 1 - THIRD LEVEL POWER PLAN
E240-1	BUILDING 1 - ROOF POWER PLAN
E300-1	BUILDING 1 - ONE LINE DIAGRAM & FIRE ALARM RISER DIAGRAM
E400-1	BUILDING 1 - DETAILS
E401-1	BUILDING 1 - DETAILS
E500-1	BUILDING 1 - PANEL SCHEDULES
E501-1	BUILDING 1 - PANEL SCHEDULES

TECHNOLOGY DRAWINGS

T001-1	TECH - AV - SEC. BUILDING 1 - KEY LEGEND & GENERAL NOTES
T110-1	TECH - AV - SEC. BUILDING 1 - LOWER LEVEL FLOOR PLAN
T120-1	TECH - AV - SEC. BUILDING 1 - MAIN LEVEL FLOOR PLAN
T130-1	TECH - AV - SEC. BUILDING 1 - SECOND LEVEL FLOOR PLAN
T140-1	TECH - AV - SEC. BUILDING 1 - THIRD LEVEL FLOOR PLAN
T200-1	BUILDING 1 - MER B01-1 DETAILS
T300-1	TECH - AV - SEC. BUILDING 1 - DETAILS
T301-1	TECH - AV - SEC. BUILDING 1 - DETAILS
T302-1	TECH - AV - SEC. BUILDING 1 - DETAILS
T303-1	SECURITY DOOR BUILDING 1 - DETAILS
T304-1	TECH - AV - SEC. BUILDING 1 - DETAILS
T400-1	TECH - SEC. BUILDING 1 - WIRING DIAGRAMS

FOOD SERVICE EQUIPMENT DRAWINGS

FS-0	SHEET LIST
FS-G1	GENERAL NOTES
FS-M1	MECHANICAL NOTES
FS-E1	ELECTRICAL NOTES
FS-P1	PLUMBING NOTES
FS-1.1.1	FOODSERVICE EQUIPMENT SCHEDULE
FS-1.2.1	FOODSERVICE EQUIPMENT PLAN & SCHEDULE
FS-1.3.1	FOODSERVICE EQUIPMENT ROUGH-IN ELECTRICAL PLAN & SCHEDULE
FS-1.4.1	FOODSERVICE EQUIPMENT ROUGH-IN PLUMBING PLAN & SCHEDULE
FS-1.6.1	FOODSERVICE EQUIPMENT ELEVATIONS REFERENCE PLAN
FS-1.6.2	FOODSERVICE EQUIPMENT ELEVATIONS
FS-1.7.1	FOODSERVICE EQUIPMENT SPECIAL CONDITIONS PLAN
FS-1.7.2	FOODSERVICE EQUIPMENT SLAB PENETRATIONS PLAN
FS-1.8.1	HOOD DETAILS
FS-1.9.1	WALK-IN DETAILS
FS-1.9.2	WALK-IN DETAILS
FS-1.13.1	MULTITERIA DETAILS
FS-2.2.1	FOODSERVICE EQUIPMENT PLAN & SCHEDULE - BASEMENT
FS-2.3.1	FOODSERVICE EQUIPMENT ROUGH-IN ELECTRICAL PLAN & SCHEDULE - BASEMENT
FS-2.4.1	FOODSERVICE EQUIPMENT ROUGH-IN PLUMBING PLAN & SCHEDULE - BASEMENT
FS-2.7.2	FOODSERVICE EQUIPMENT SLAB PENETRATIONS PLAN - BASEMENT

ALTERATIONS TO:  
ACES at Chase  
565 Chase Parkway  
Waterbury, Connecticut 06708

SILVER PETRUCELLI + ASSOCIATES

3190 WHITNEY AVENUE HAMDEN CT 06518  
311 STATE STREET NEW LONDON CT 06320  
203 230 9007 silverpetrucelli.com

Date:  
12/16/2025 10:08:17 AM

Drawing Title:  
BUILDING 1 - GENERAL INFORMATION  
AND DRAWING LIST

Project Phase:  
ISSUED FOR BID - 11/03/2025

State Project Number:  
#244-0044 MAG


Date:  
AUGUST 12, 2025

Scale:  
1/2" = 1'-0"

Drawn By:  
BJV

Project Number:  
22.050

G001-1

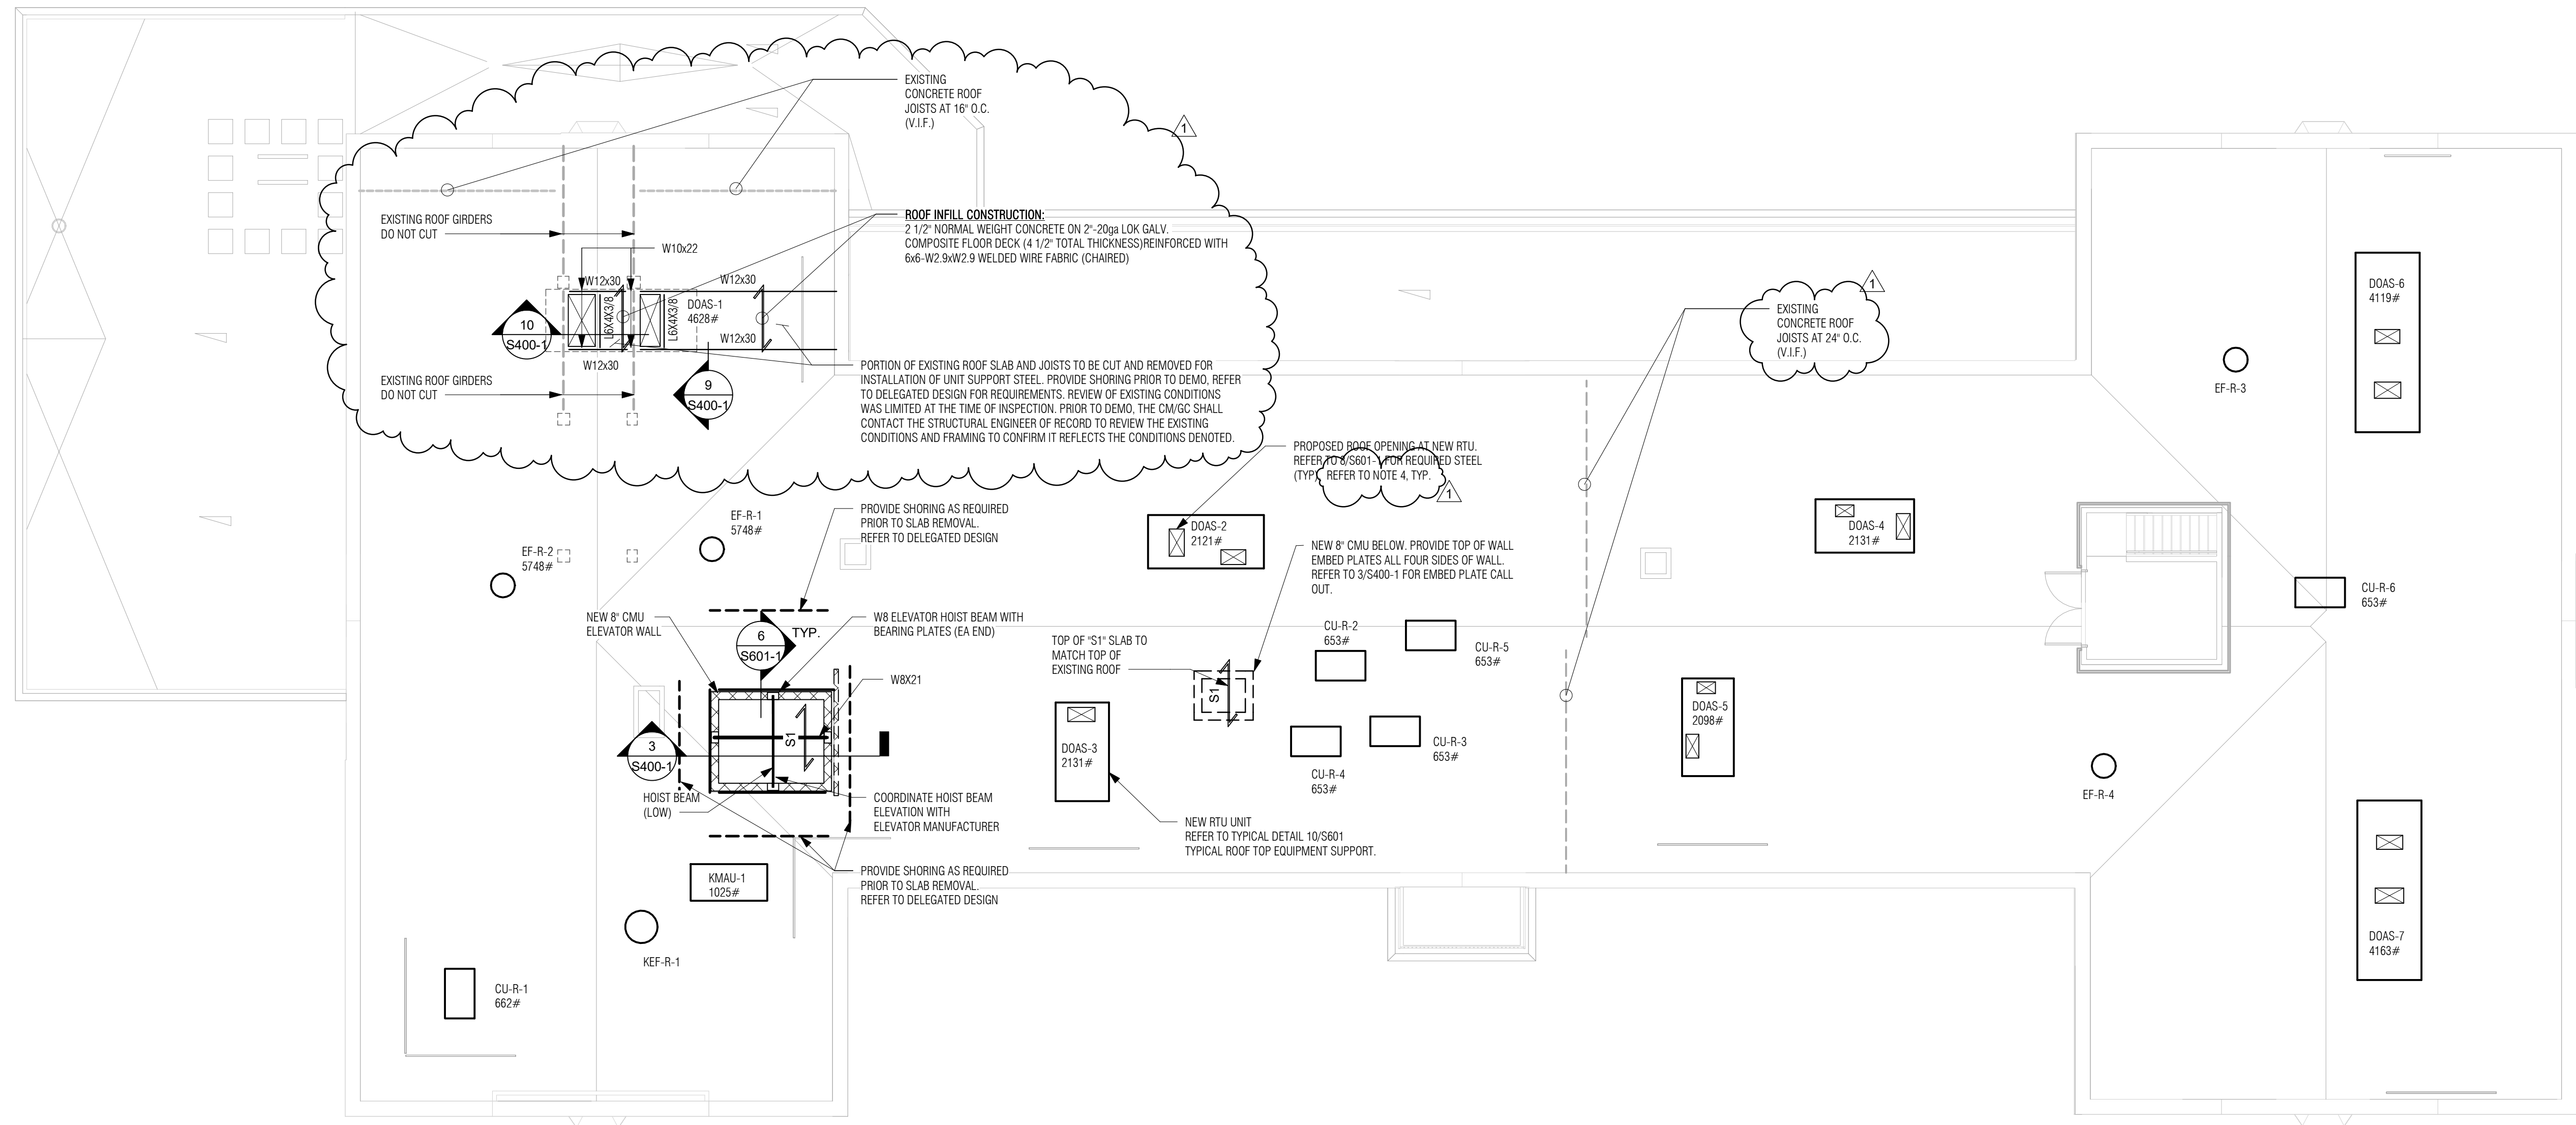

# 1 ROOF FRAMING PLAN - OVERALL

1/8" = 1'-0"


## ROOF CONSTRUCTION NOTES:

- CONTRACTOR TO FIELD VERIFY ALL EXISTING FRAMING SIZES, SPACING AND LOCATIONS PRIOR TO SUBMITTING SHOP DRAWINGS.
- REFER TO DRAWING S-601-1 FOR ALL ROOF FRAMES AT OPENINGS. COORDINATE ALL OPENING LOCATIONS WITH ARCHITECTURAL AND MECHANICAL DRAWINGS.
- WHERE ROOF EQUIPMENT WEIGHT IS NOT DENOTED, EQUIPMENT SPECIFICATION MUST BE SUBMITTED PRIOR TO CONSTRUCTION TO CONFIRM EQUIPMENT WEIGHT ADEQUACY ON EXISTING STRUCTURE.
- WHERE POSSIBLE, ROOF PENETRATIONS SHALL BE CONFIGURED OR ADJUSTED TO AVOID CUTTING EXISTING CONCRETE ROOF JOISTS. IF EQUIPMENT OPENING IS LARGER THAN EXISTING CONCRETE JOIST SPACING, PROVIDE SUBSEQUENT STRUCTURAL STEEL AS DETAILED AT DOAS-1. FIELD REVIEW AND VERIFICATION OF ALL PENETRATION LOCATIONS IS REQUIRED AFTER REMOVAL OF FINISHES IN THE AREA FOR THE SETS TO REVIEW WITH THE CM AND ARCHITECT.

INDICATES FLOOR/ROOF OPENING WITHIN EXISTING STRUCTURE. COORDINATE ALL OPENING SIZES, CONFIGURATIONS, QUANTITIES, AND LOCATIONS WITH ARCHITECTURAL AND MECHANICAL DRAWINGS PRIOR TO WORK. REFER TO 12/S600-1 FOR 'TYPICAL OPENING IN EXISTING CONCRETE SLAB' DETAIL.

INDICATES CMU WALL. REFER TO GENERAL NOTES, TYPICAL DETAILS AND SCHEDULES FOR WALL REQUIREMENTS.

S1 ROOF CONSTRUCTION: 4 1/2" NORMAL WEIGHT CONCRETE ON 2"-18ga LOK GALV. COMPOSITE FLOOR DECK (4 1/2" TOTAL THICKNESS) REINFORCED WITH 6x6-W2.3W2.9 WELDED WIRE FABRIC (CHAINED). (2 HOUR RATED ASSEMBLY)

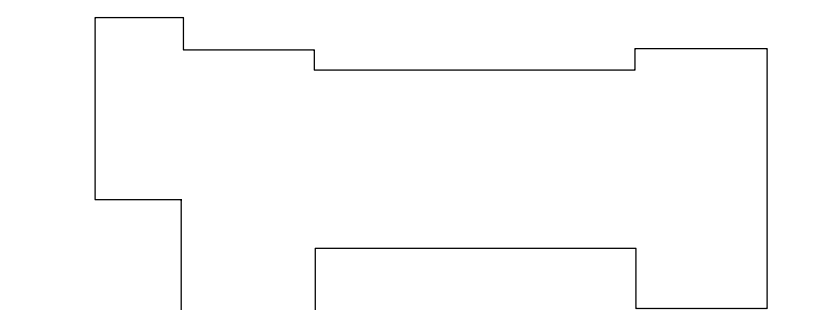

KEY PLAN  
SCALE: NTS

Project Title:  
**ALTERATIONS TO:  
ACES at Chase**  
565 Chase Parkway  
Waterbury, Connecticut 06708



**SILVER PETRUCCELLI + ASSOCIATES**  
3190 WHITNEY AVENUE HAMDEN CT 06518  
311 STATE STREET NEW LONDON CT 06320  
203 230 9007 silverpetrucci.com

Revision:	Description:	Date:	Reviewed By:
1	Bulletin #1	12/16/25	LVP

**MHAI**  
Michael Horton  
Associates Inc.  
Consulting Structural Engineers  
700 East Main Street  
Branford, Connecticut 06405  
203-481-8600 mhai-eng.com


Drawing Title:  
**BUILDING 1 - ROOF FRAMING PLAN -  
OVERALL**  
Project Phase:  
**ISSUED FOR BID - 11/03/2025**  
State Project Number:  
**#244-0044 MAG**

Date:  
AUGUST 12, 2025  
Scale:  
1/8" = 1'-0"  
Drawn By:  
AC  
Project Number:  
22.050


Drawing Number:

**S150-1**




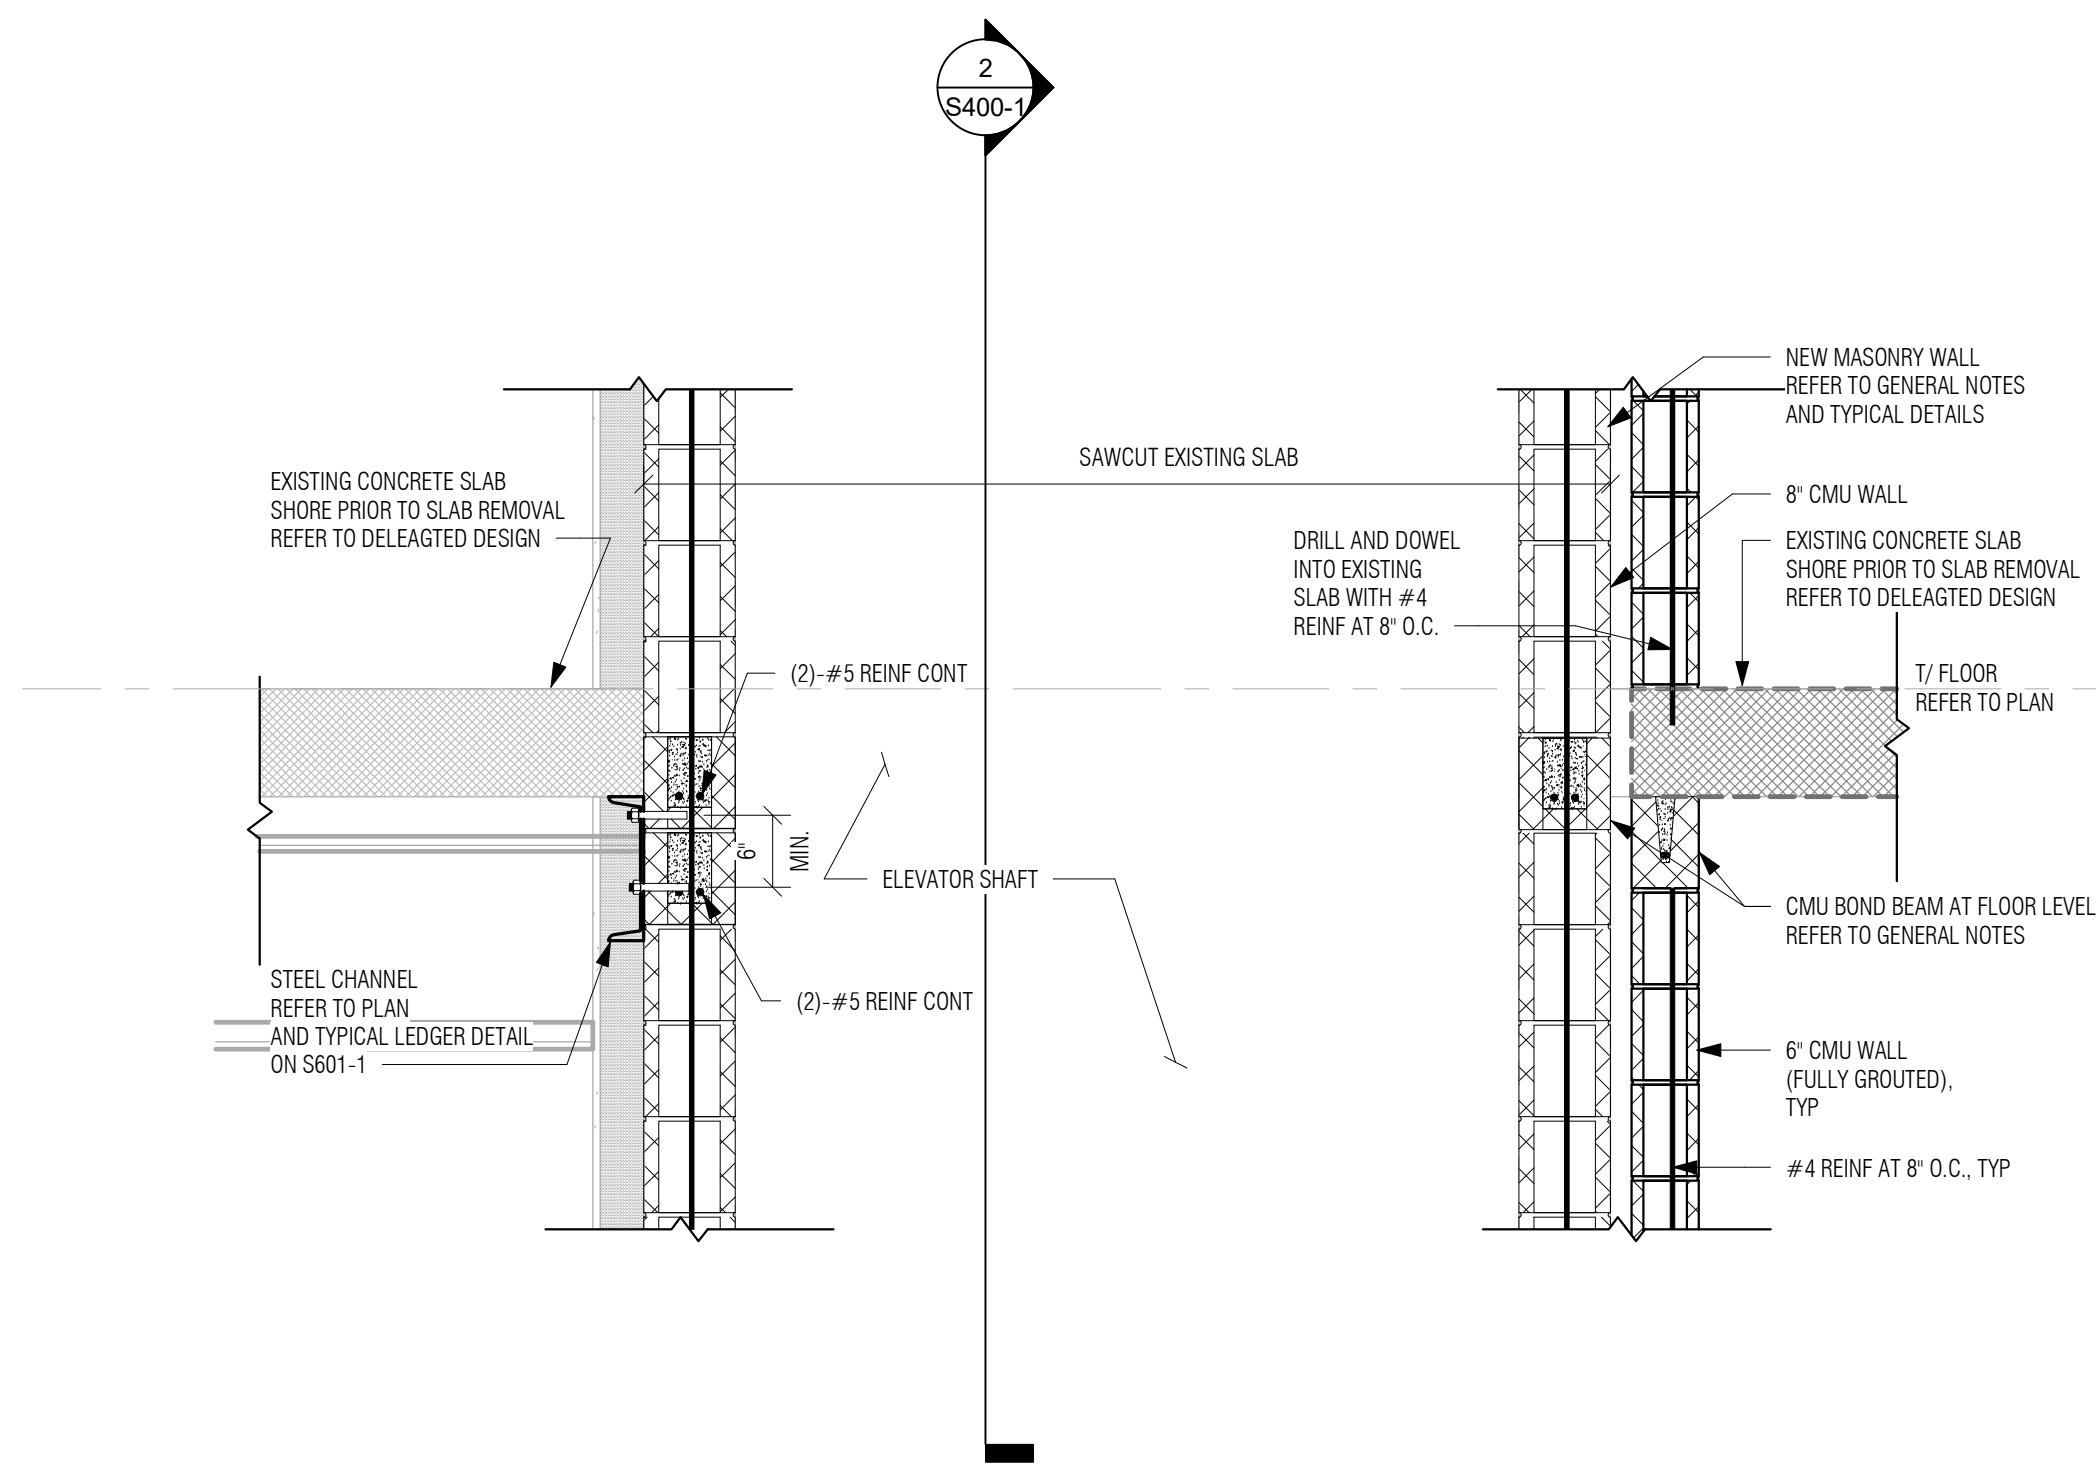


**1 SECTION**  
3/4" = 1'-0" REFERENCE: 1/ S120-1

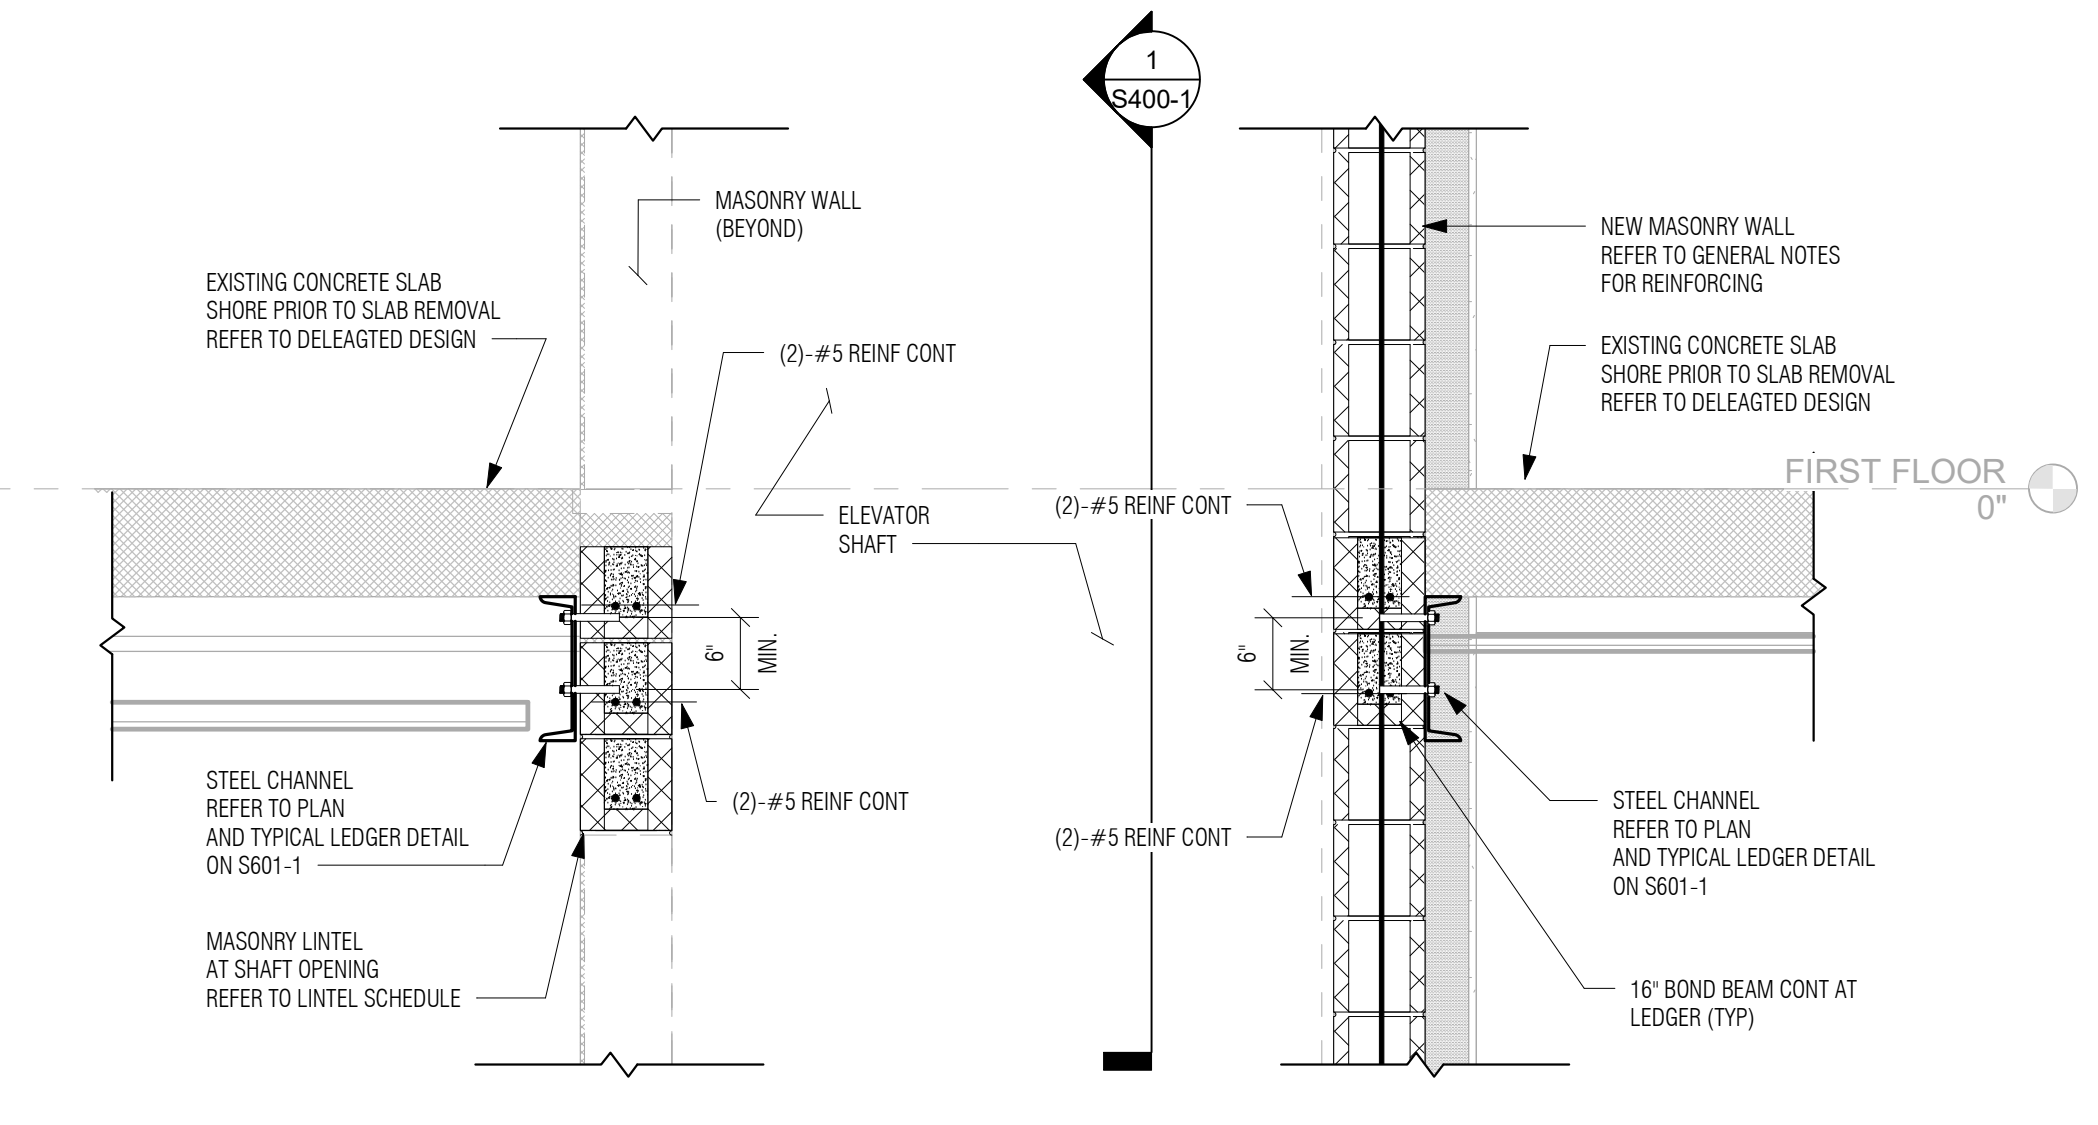


**2 SECTION**  
3/4" = 1'-0" REFERENCE: 1/ S120-1

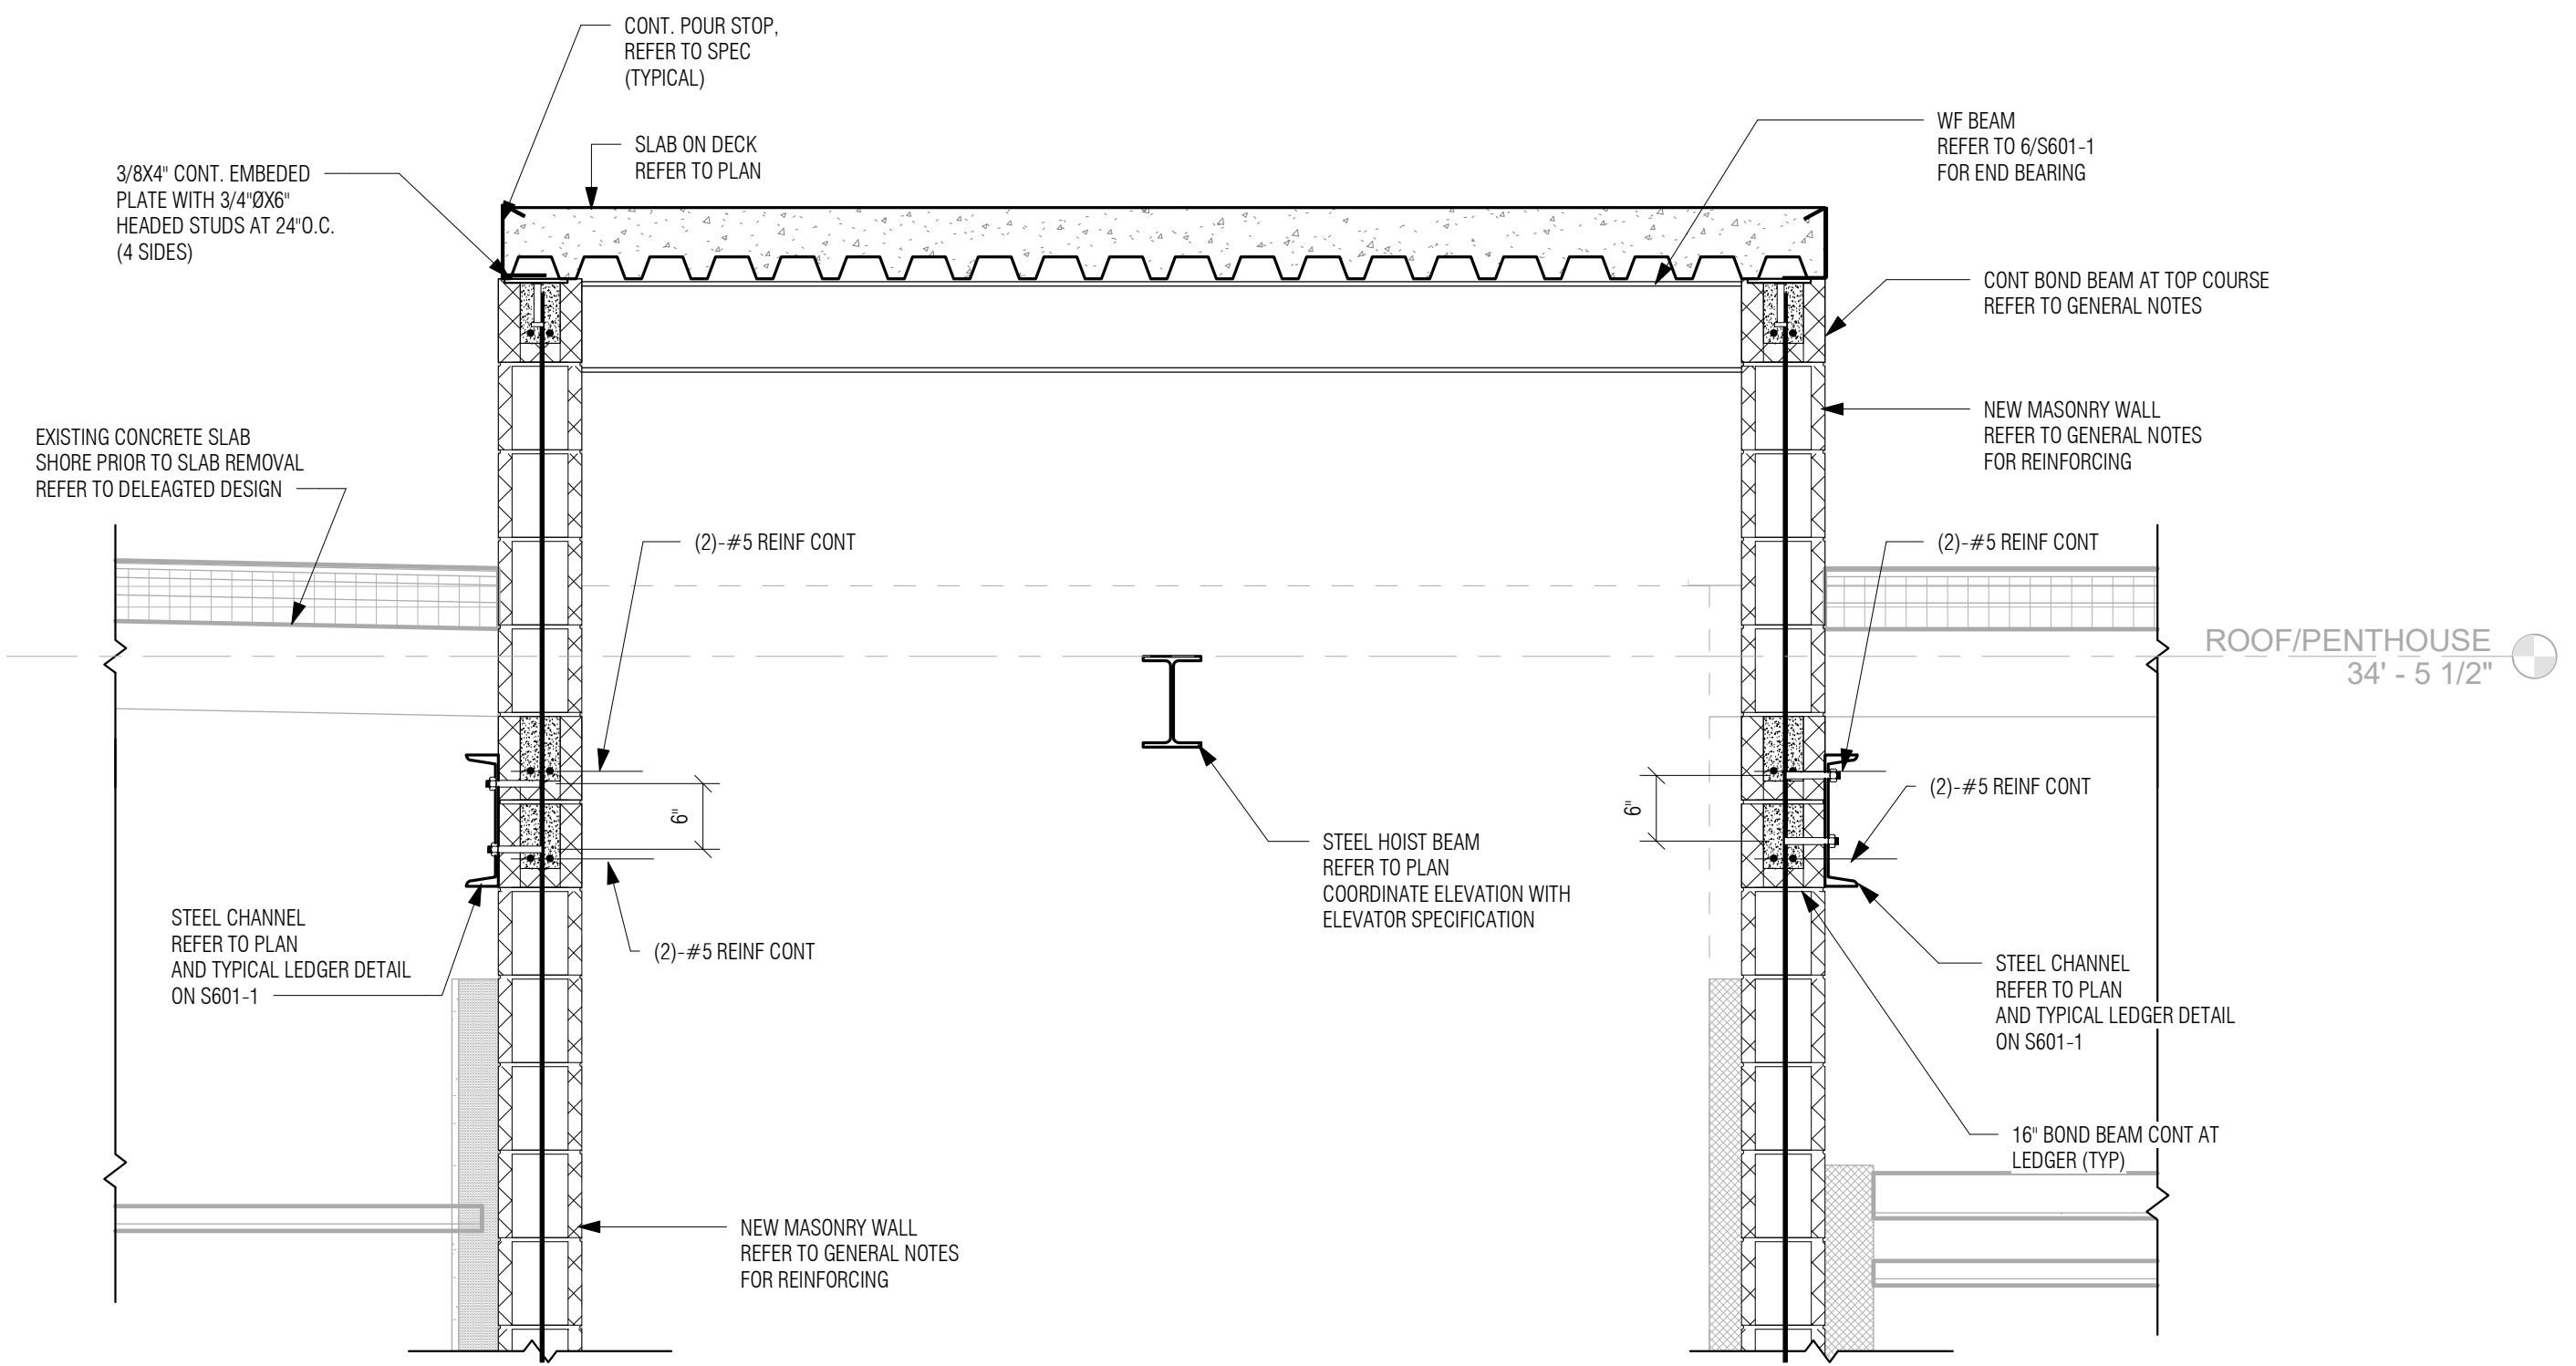


**3 Section 16**  
3/4" = 1'-0" REFERENCE: 1/ S150-1

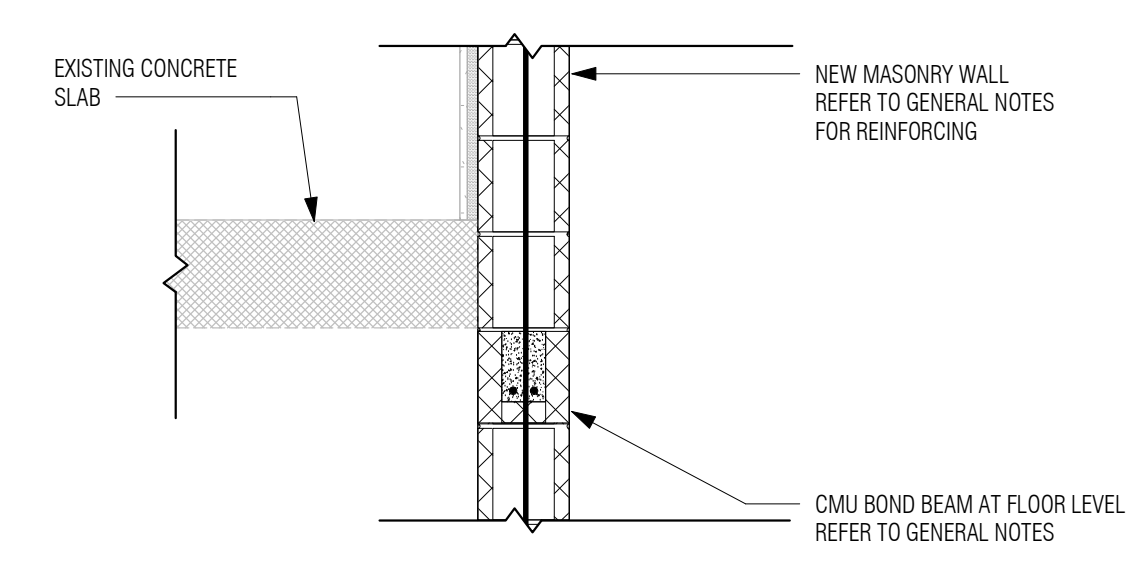


**4 SECTION**  
3/4" = 1'-0" REFERENCE: 1/ S120-1

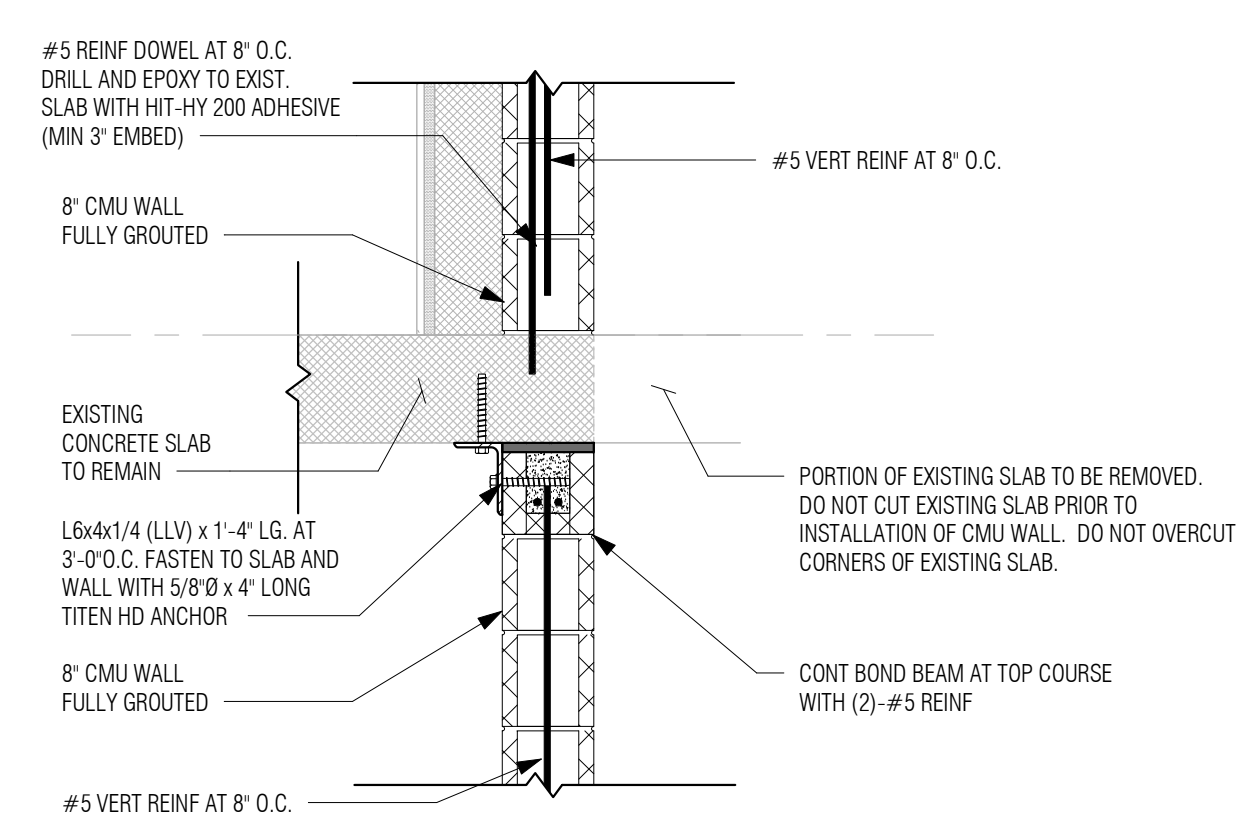


**5 SECTION**  
3/4" = 1'-0" REFERENCE: 1/ S120-1

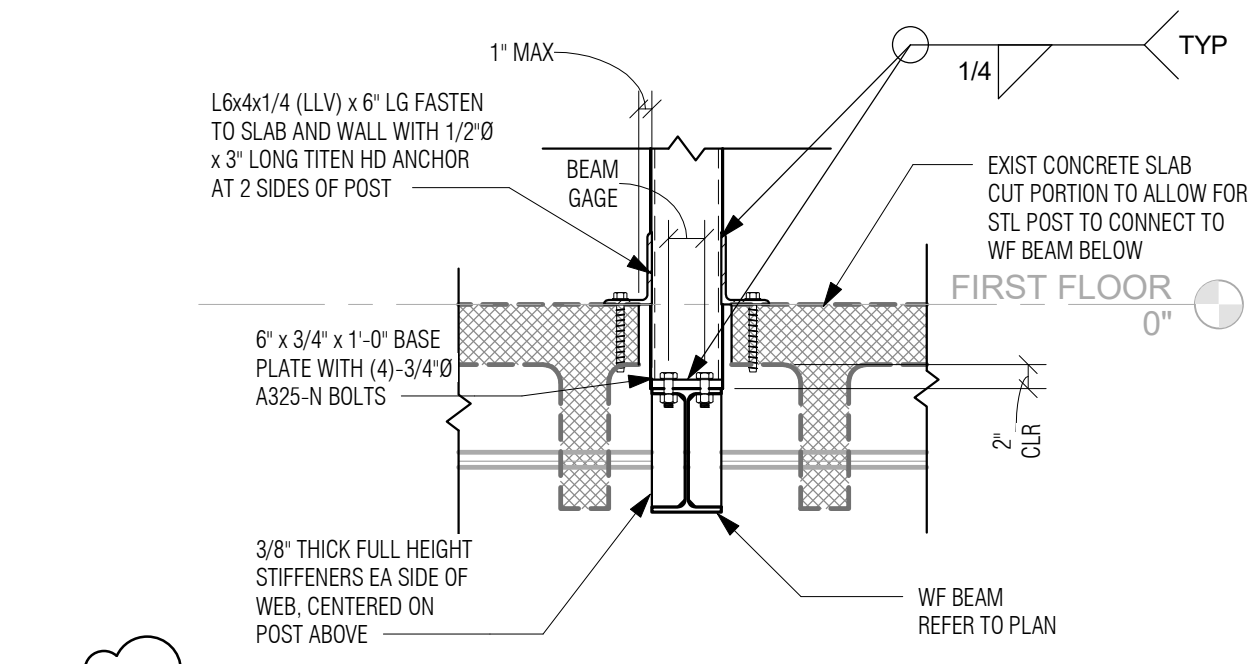


**6 SECTION**  
3/4" = 1'-0" REFERENCE: 1/ S120-1

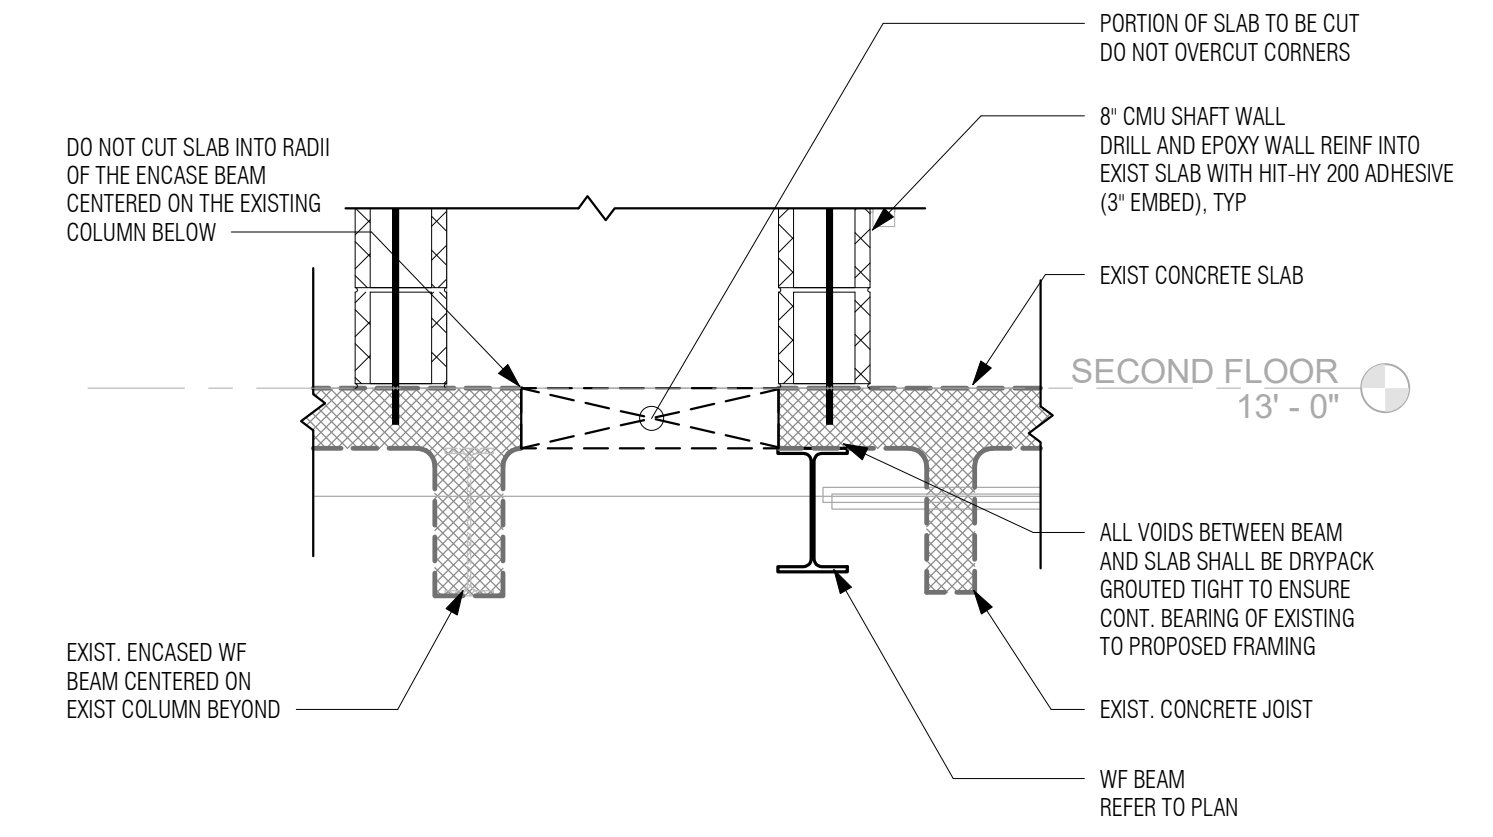


**7 SECTION**  
3/4" = 1'-0" REFERENCE: 1/ S130-1

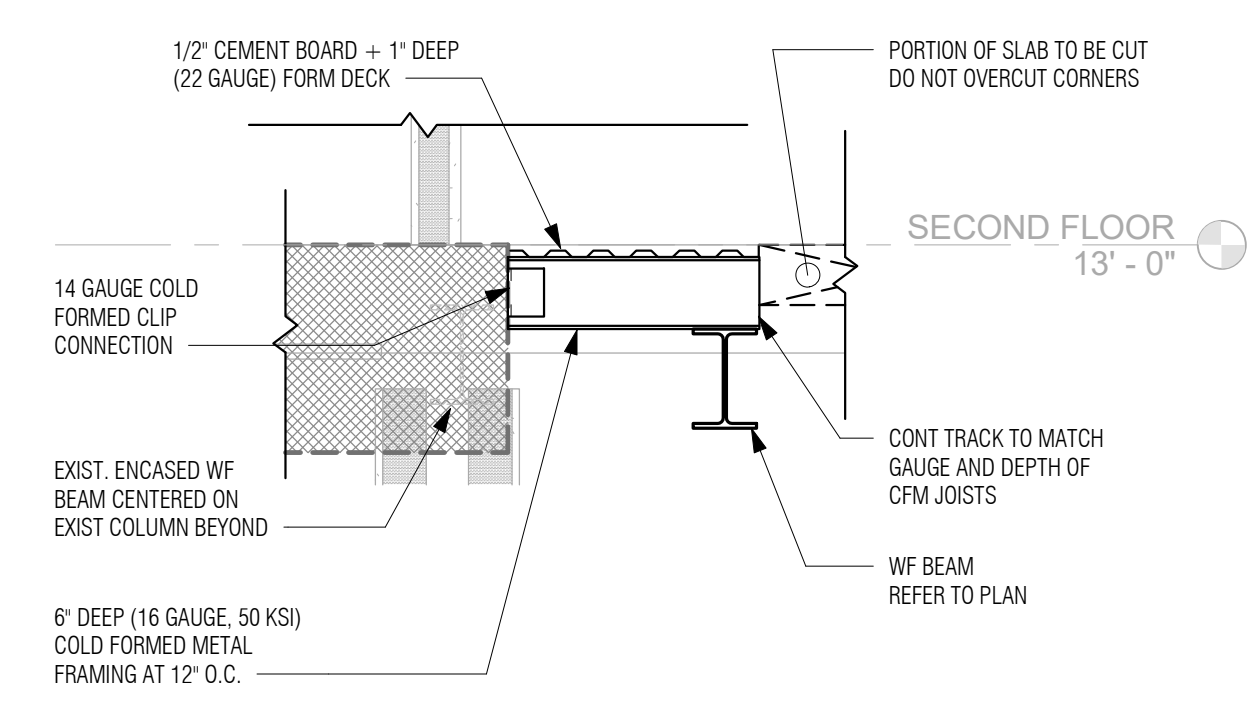


**8 SECTION**  
3/4" = 1'-0" REFERENCE: 1/ S130-1

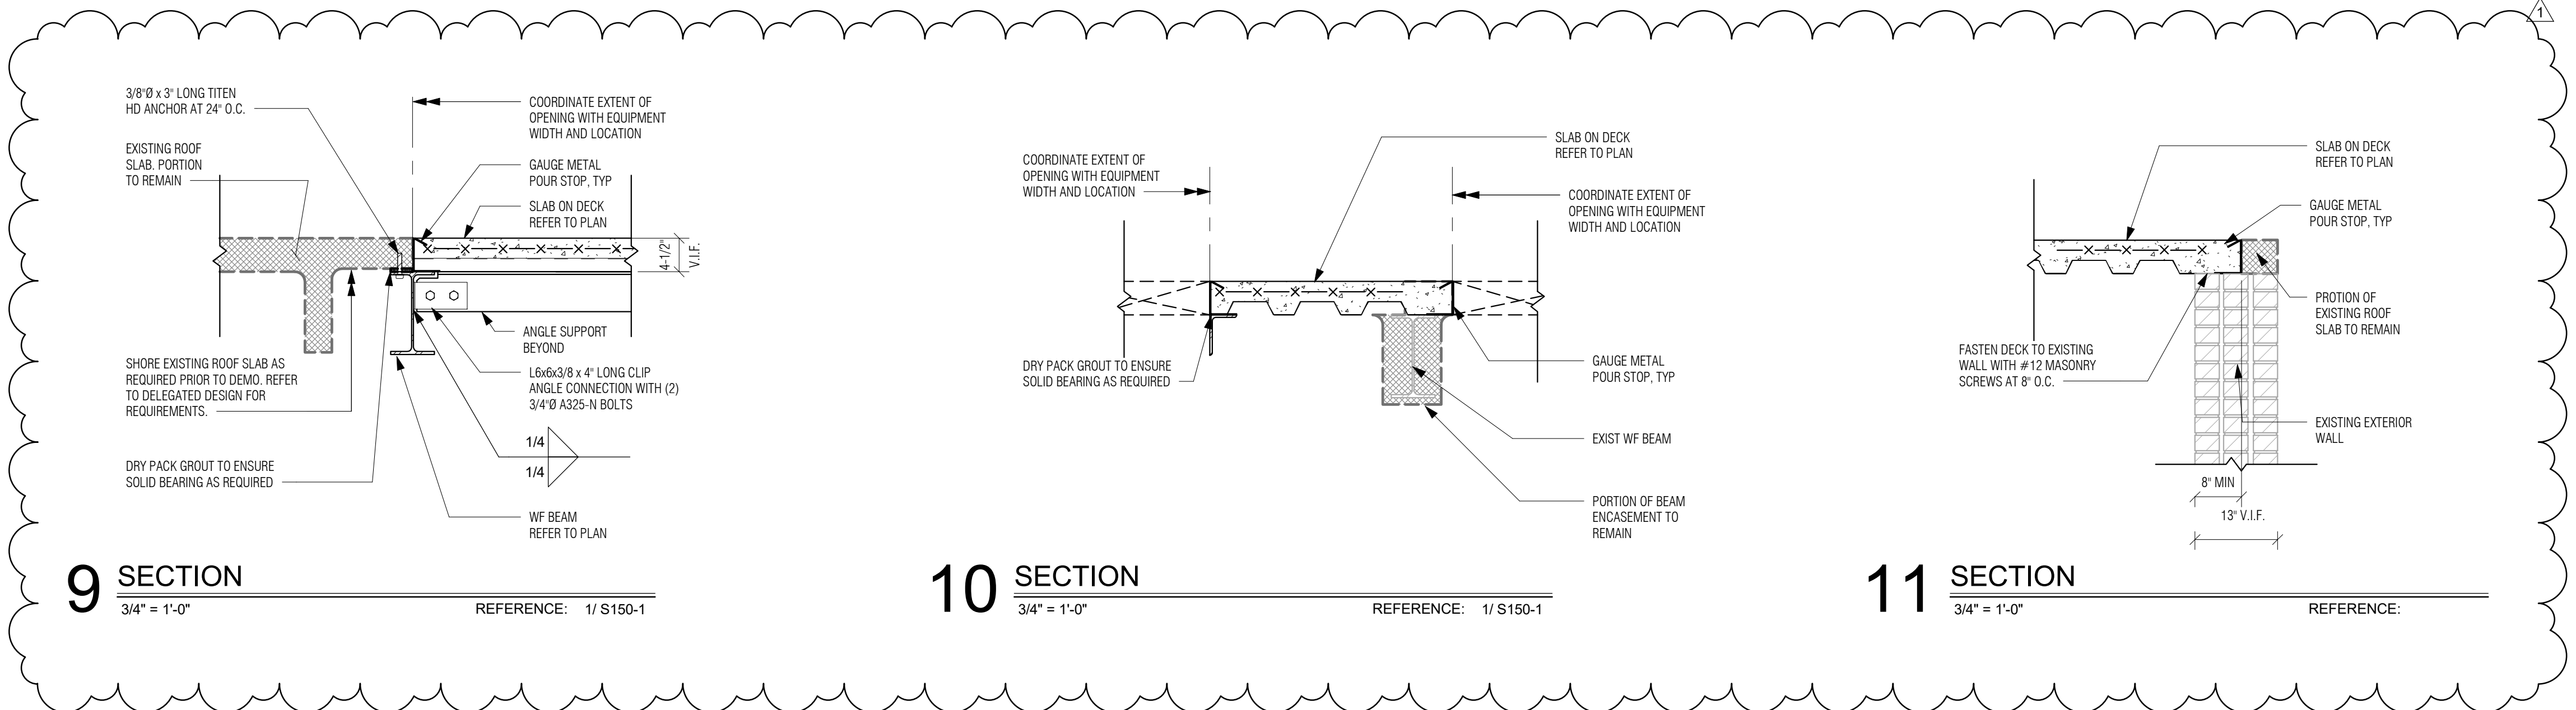

**9 SECTION**  
3/4" = 1'-0" REFERENCE: 1/ S150-1

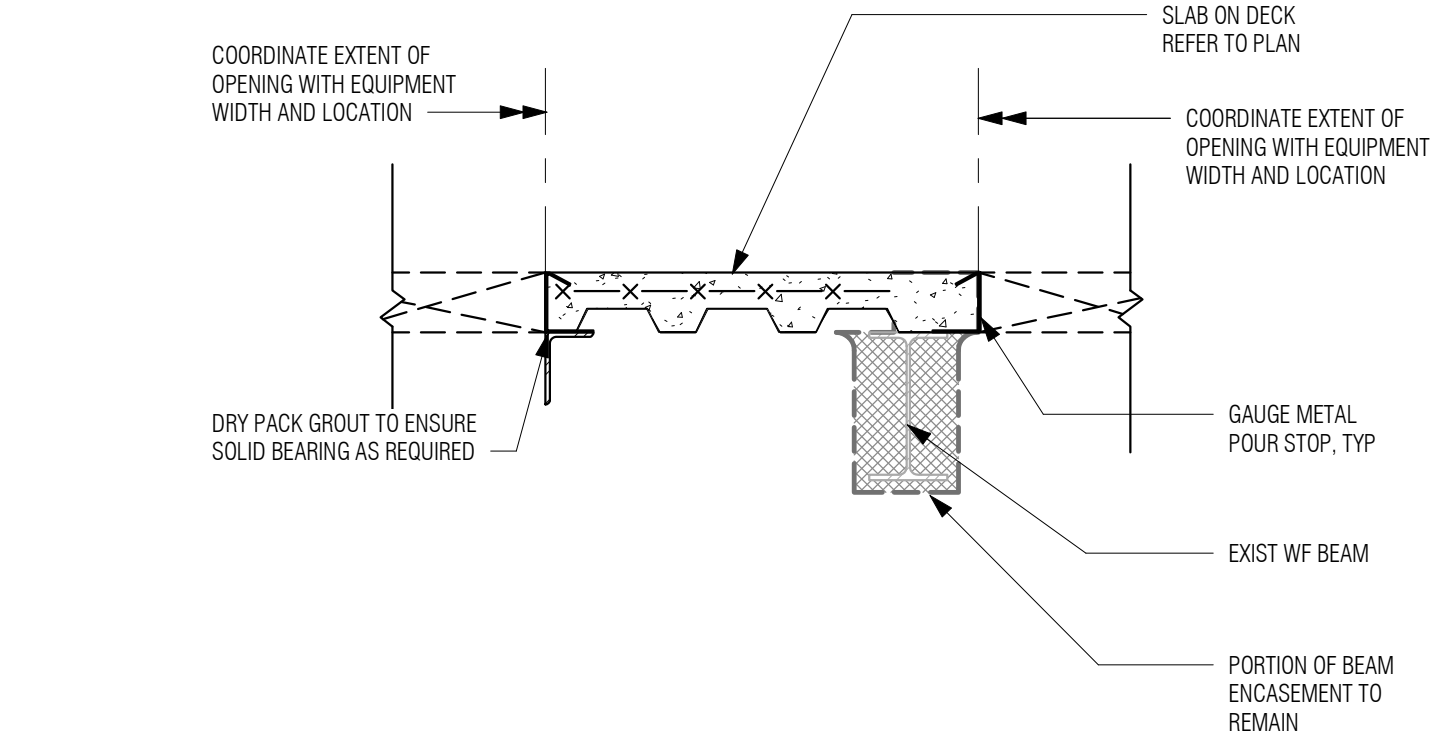

**10 SECTION**  
3/4" = 1'-0" REFERENCE: 1/ S150-1

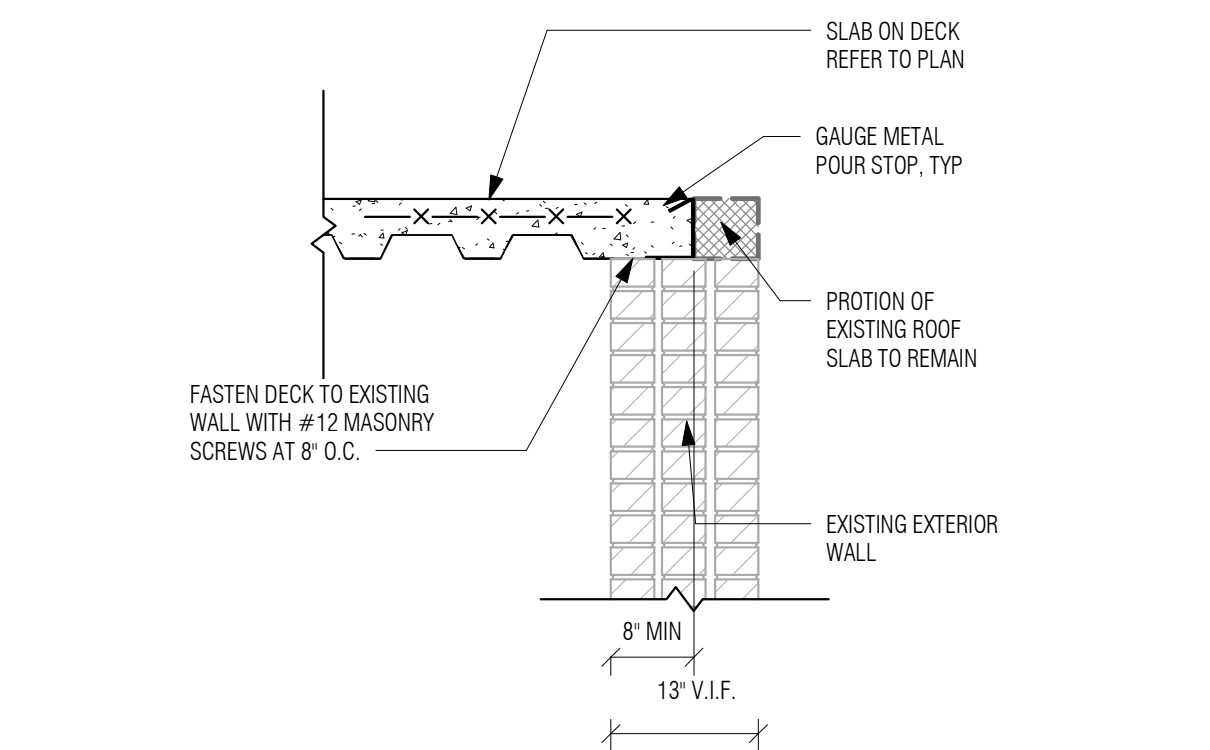

**11 SECTION**  
3/4" = 1'-0" REFERENCE:

Project Title:  
**ALTERATIONS TO:  
ACES at Chase**  
565 Chase Parkway  
Waterbury, Connecticut 06708

**SILVER PETRUCELLI + ASSOCIATES**  
3190 WHITNEY AVENUE HAMDEN CT 06518  
311 STATE STREET NEW LONDON CT 06320  
203 230 9007 silverpetrucelli.com

Revision:	Description:	Date:	Reviewed By:
1	Bulletin #1	12/16/25	LVP

**MHAI**  
Michael Horton  
Associates Inc.  
Consulting Structural Engineers  
780 East Main Street  
Branford, Connecticut 06405  
203-481-8600 mhai-cng.com

Drawing Title:  
**FLOOR SECTIONS**  
Project Phase:  
**ISSUED FOR BID - 11/03/2025**  
State Project Number:  
**#244-0044 MAG**

Date:  
AUGUST 12, 2025  
Scale:  
3/4" = 1'-0"  
Drawn By:  
LVP  
Project Number:  
22 050

**S400-1**








 

 



















 
 



12/16/2025 12:00:07 PM




PLUMBING GENERAL NOTES			
<p><b>GENERAL</b></p> <p>THE INTENT OF THESE CONTRACT DOCUMENTS (SPECIFICATIONS AND DRAWINGS) IS FOR THE CONTRACTOR TO FURNISH AND INSTALL COMPLETE PLUMBING SYSTEMS. ALL SYSTEMS SHALL BE COMPLETE IN ALL RESPECTS, OPERATING, TESTED, ADJUSTED, APPROVED BY THE AUTHORITIES HAVING JURISDICTION AND READY FOR BENEFICIAL USE BY THE OWNER.</p> <p>WHEN A CONFLICT BETWEEN THE DRAWINGS, NOTES AND/OR SPECIFICATIONS OCCUR, THE MORE STRINGENT, AND/OR LARGER QUANTITY AND/OR MORE EXPENSIVE SHALL APPLY. THE REQUIREMENTS LISTED WITHIN NOTES OR SPECIFICATIONS SHALL BE REQUIRED, PROVIDED AND INSTALLED WHETHER SPECIFICALLY INDICATED ON THE DRAWINGS OR NOT.</p> <p>ITEMS AND SERVICES NOT SHOWN ON DRAWINGS OR SPECIFICATIONS BUT REQUIRED TO RENDER THE WORK COMPLETE AND READY FOR OPERATION, SHALL BE PROVIDED WITHOUT ADDITIONAL COST.</p> <p>WORK OF THIS SECTION SHALL BE GOVERNED BY THE CONTRACT DOCUMENTS. PROVIDE MATERIALS, LABOR, EQUIPMENT AND SERVICES NECESSARY TO FURNISH, DELIVER AND INSTALL ALL WORK AS SPECIFIED AND AS REQUIRED BY JOB CONDITIONS. WHERE A CONFLICT EXISTS BETWEEN THESE NOTES, THE DRAWINGS AND THE SPECIFICATIONS, THE MORE STRINGENT REQUIREMENT SHALL APPLY.</p> <p>DRAWINGS ARE DIAGRAMMATIC AND INDICATE A GENERAL ARRANGEMENT OF WORK AND ARE NOT TO BE CONSIDERED SUB-CONTRACTOR DOCUMENTS. IT IS THE INTENT OF THESE DOCUMENTS TO INCLUDE THE PROVISION AND INSTALLATION OF ALL NECESSARY WORK AND MATERIALS FOR COMPLETE, OPERATIONAL, AND CODE COMPLAINT SYSTEMS BY THE CONTRACTOR. GENERAL DESIGN CONCEPTS INDICATED MUST BE FOLLOWED OR BETTERED. THE BID SHALL INCLUDE OFFSETS, ADDITIONAL PIPING, VALVES AND EQUIPMENT AND COMPONENTS AS REQUIRED TO MEET CONSTRUCTION CONDITIONS FOR PROPER OPERATION. DO NOT SCALE DRAWINGS. CONSULT ARCHITECTURAL AND STRUCTURAL DRAWINGS FOR SPACE CONDITIONS AND ADDITIONAL REQUIREMENTS.</p> <p>PERFORM THE WORK IN ACCORDANCE WITH THE REQUIREMENTS OF THE CONTRACT GENERAL CONDITIONS AND WITH THE PROVISIONS OF ALL APPLICABLE LOCAL, STATE, AND FEDERAL CODES AND LAWS.</p> <p>WORK SHALL INCLUDE ALL INCIDENTALS, LABOR, MATERIAL, EQUIPMENT, APPLIANCES, SERVICES, HOISTING, SCAFFOLDING, SUPPORTS, TOOLS, CONSUMABLE ITEMS, FEES, LICENSES, AND ADMINISTRATIVE TASKS REQUIRED TO COMPLETE AND MAKE OPERABLE WORK SHOWN ON THE DRAWINGS, SPECIFIED HEREIN AND AS REQUIRED FOR A COMPLETE AND OPERATIONAL SYSTEM. INSTALLATION. COORDINATE REQUIREMENTS.</p> <p>ALL EQUIPMENT, MATERIALS AND RELATED SYSTEMS COMPONENTS SHALL BE NEW UNLESS SPECIFICALLY NOTED OTHERWISE.</p> <p>STORE MATERIALS INSIDE AND PROTECTED FROM DEBRIS, WEATHER AND MOISTURE.</p> <p>THIS CONTRACTOR SHALL COORDINATE ALL POWER AND CONTROL WIRING REQUIRED FOR EQUIPMENT OPERATION REQUIRED FOR A COMPLETE AND OPERATIONAL SYSTEM WITH ELECTRICAL CONTRACTOR. THIS CONTRACTOR SHALL PROVIDE MOTOR STARTERS FOR INSTALLATION. COORDINATE REQUIREMENTS.</p> <p>PROVIDE AND INSTALL ALL MAKE-UP WATER DISTRIBUTION TO HVAC EQUIPMENT INCLUDING BACKFLOW PREVENTER.</p> <p>REMOVE AND INSTALL INDIRECT CONDENSATE WASTE PIPING AND TRAP TO FLOOR DRAIN OR DRAIN RECEPTOR FROM ALL A/C MAKE-UP EQUIPMENT. PROVIDE ADDITIONAL FLOOR DRAINS WITH TRAP PRIMERS OR DRAIN RECEPTORS AS REQUIRED.</p> <p>PLUMBING DEVICES, FAUCETS, VALVES AND FITTINGS REQUIRED FOR SPECIALTY SERVICE EQUIPMENT (IE: KITCHEN, LAB ETC.) SHALL BE PROVIDED BY THIS CONTRACTOR UNLESS OTHERWISE SPECIFIED. THIS CONTRACTOR SHALL PROVIDE AND INSTALL PIPING, CONNECTIONS, DEVICES, VALVES AND EQUIPMENT REQUIRED FOR PROPER OPERATION. COORDINATE REQUIREMENTS.</p> <p>KITCHENS, LABS AND SIMILAR SPECIALTY AREAS: ALL EXPOSED PIPING, STOPS, COCKS, AND WASTES WHICH ARE VISIBLE SHALL BE CHROME PLATED.</p> <p>REPAIR AND/OR REPLACE AT NO COST TO OWNER ALL EQUIPMENT AND MATERIALS DAMAGED DURING CONSTRUCTION.</p> <p><b>ALTERATION WORK AND DEMOLITION</b></p> <p>ALL EQUIPMENT, FIXTURES, PIPING, ETC. TO BE REMOVED, SHALL BE DISPOSED OF, TURNED OVER TO THE OWNER, OR SALVAGED AS DIRECTED BY THE OWNER. EQUIPMENT, FIXTURES, PIPING, DEVICES, ETC. SHALL NOT BE REMOVED FROM THE PREMISES WITHOUT THE OWNER'S APPROVAL.</p> <p>UPON COMPLETION OF REMOVALS AND MODIFICATIONS, ALL PIPING TO REMAIN SHALL BE PROPERLY PLUGGED, VALVED, CAPPED AND/OR BY PASSED SUCH THAT UPON COMPLETION OF WORK ALL SYSTEMS TO REMAIN, REMAIN OPERATIONAL.</p> <p>NO DEAD ENDS SHALL BE LEFT ON ANY PIPING SYSTEMS UPON COMPLETION OF WORK.</p> <p>EXISTING EXPOSED PIPING SYSTEMS NOT TO BE REUSED, AND NOT SPECIFICALLY NOTED FOR REMOVAL SHALL BE COMPLETELY REMOVED.</p> <p>ALL SYSTEMS SHALL BE LEFT IN WORKING ORDER TO THE SATISFACTION OF THE OWNER UPON COMPLETION OF ALL NEW WORK.</p> <p>ALL EXISTING EXPOSED, UNNECESSARY PIPING RELATED TO NEW WORK SHALL BE COMPLETELY REMOVED.</p> <p>RE-ROUTE OR REMOVE ALL EXISTING PIPING AND SYSTEMS WHERE NECESSARY TO AVOID NEW EQUIPMENT, STRUCTURAL, OR MASONRY WORK AS REQUIRED BY THE PROPOSED ALTERATIONS.</p> <p><b>COORDINATION</b></p> <p>THE CONTRACTOR SHALL OBTAIN AND REVIEW ALL CONTRACT DOCUMENTS, INCLUDING PROJECT MANUAL, PLANS AND SPECIFICATIONS OF ALL TRADES BEFORE SUBMITTING BID. REFER TO SPECIFICATIONS, PROJECT MANUAL, AND PLANS INCLUDING ALL EQUIPMENT SCHEDULES FOR INFORMATION. CONTRACTOR SHALL WALK THROUGH BUILDING PRIOR TO SUBMITTING BID WHEN AVAILABLE.</p> <p>ALL OF THE CONTRACT DRAWINGS AND SPECIFICATIONS ARE COMPLIMENTARY TO FORM A TOTAL DESIGN PACKAGE. IT IS THE RESPONSIBILITY OF THE GENERAL CONTRACTOR/CONSTRUCTION MANAGER TO DETERMINE WHICH TRADE CONTRACTOR IS RESPONSIBLE FOR VARIOUS PORTIONS OF THE WORK.</p> <p>ALL WORK AND ACTION DEPICTED AND DESCRIBED SHALL BE PERFORMED BY THE CONTRACTOR UNLESS SPECIFICALLY NOTED OTHERWISE.</p> <p>THE PLUMBING CONTRACTOR SHALL VERIFY THESE DRAWINGS WITH EXISTING FIELD CONDITIONS AND SHALL COORDINATE WITH CIVIL ENGINEER LOCATIONS AND ELEVATIONS OF PLUMBING SERVICE LINES BEFORE PROCEEDING WITH CONSTRUCTION. THE UTILITY SERVICE LINES SHOWN ON THE DRAWINGS ARE FOR REFERENCE &amp; BUILDING PERMITS ONLY. REFER TO CIVIL ENGINEERS DRAWINGS FOR UTILITY SERVICE LINES LAYOUT &amp; DETAILS.</p> <p>CONTRACTORS SHALL COORDINATE THEIR WORK WITH ALL OWNER-FURNISHED EQUIPMENT, INCLUDING REQUIRED SERVICE CONNECTIONS, RECEIPTS/LAHS, ETC. BEFORE INSTALLATION.</p> <p>THE DRAWINGS ARE DIAGRAMMATIC AND INDICATE THE GENERAL ARRANGEMENT OF SYSTEMS AND WORK INCLUDED IN THE CONTRACT. THE CONTRACTOR SHALL COORDINATE LOCATIONS OF EQUIPMENT WITH ALL TRADES BEFORE STARTING CONSTRUCTION. ANY MODIFICATIONS TO THE EQUIPMENT LAYOUT REQUIRED FOR INSTALLATION ARE TO BE PERFORMED AT NO ADDITIONAL COST TO THE OWNER.</p> <p>COORDINATE ALL PIPING AND CONDUITS LEAVING THE BUILDING WITH THE SITE CONTRACTOR BEFORE INSTALLATION.</p> <p>LOCATION AND SIZES OF ALL FLOOR, WALL AND ROOF PENETRATIONS SHALL BE COORDINATED WITH ALL OTHER TRADES INVOLVED.</p> <p>DEVELOP AND SUBMIT COORDINATION DRAWINGS AS OUTLINED.</p> <p>SHEET METAL, PLUMBING AND FIRE PROTECTION SHOP DRAWINGS THAT HAVE BEEN COORDINATED WITH ARCHITECTURAL AND STRUCTURAL DRAWINGS SHALL BE SUBMITTED TO ENGINEERS FOR REVIEW. DRAWINGS MUST BE RETURNED FROM ENGINEER EITHER "REVIEWED" OR "FURNISH AS CORRECTED" PRIOR TO BEING USED AS BASIS FOR COORDINATION DRAWINGS.</p> <p>AFTER SHEET METAL AND PIPING DRAWINGS HAVE BEEN REVISED PER ENGINEERS COMMENTS, REPRODUCIBLE COPIES SHALL BE SENT TO THE TRADES IN THE FOLLOWING SEQUENCE FOR THE INCLUSION OF THEIR WORK:</p>	<p>-MECHANICAL SHEET METAL -PLUMBING PIPING -ELECTRICAL WORK</p> <p>AFTER ALL TRADES HAVE INCLUDED THEIR WORK ON THE COORDINATION DRAWING AND NOTED CONFLICTS, ALL TRADES SHALL MEET TO RESOLVE CONFLICTS AND AGREE TO ACCEPTABLE SOLUTIONS. EACH TRADE SHALL SIGN COORDINATION DRAWINGS. ITEMS NOT SHOWN ON COORDINATION DRAWINGS IS RESPONSIBILITY OF OMITTING CONTRACTOR AND CONTRACTOR IS SUBJECT TO ADDITIONAL COSTS INCURRED BY OTHER TRADES.</p> <p>THE ARCHITECT AND ENGINEER ARE NOT PART OF THE COORDINATION DRAWING PROCESS. THE ENGINEER WILL PROVIDE ASSISTANCE FOR NOTED CONFLICTS ONLY. COORDINATION DRAWINGS ARE NOT TO BE CONSIDERED PIPING OR DUCT SHOP DRAWINGS. THE CONTRACTOR IS REQUIRED TO SUBMIT INDIVIDUAL PIPING AND DUCTWORK SHOP DRAWINGS FOR REVIEW BY THE ENGINEER. PIPING AND DUCTWORK SHOP DRAWINGS SHALL FOLLOW THE DESIGN INTENT OF THE CONTRACT DOCUMENTS.</p> <p>SUBMIT FINAL SIGNED COORDINATION DRAWING TO ENGINEER FOR REVIEW. ENGINEER WILL REVIEW COORDINATION DRAWINGS FOR GENERAL ARRANGEMENT AND FOR NOTED CONFLICTS ONLY. SPECIFIC INSTALLATION REQUIREMENTS WILL BE REVIEWED ONLY IN INDIVIDUAL TRADE SHOP DRAWINGS.</p> <p>ANY WORK FABRICATED OR INSTALLED PRIOR TO SIGN OFF BY ALL TRADES WHICH IS DEEMED TO BE IN CONFLICT WITH COORDINATION DRAWINGS SHALL BE REMOVED AND RE-INSTALLED IN CONFORMANCE WITH COORDINATION DRAWINGS.</p> <p>EACH CONTRACTOR (MENTIONED ABOVE) IS RESPONSIBLE FOR THE COORDINATION OF HIS SUB-CONTRACTORS.</p> <p>THE OVERALL COORDINATION OF THE COORDINATION PROCESS IS THE RESPONSIBILITY OF THE CONTRACTOR. THE ENGINEER IS NOT RESPONSIBLE FOR THE COORDINATION PROCESS. THE ENGINEER WILL RESPOND TO QUESTIONS THAT ARISE FROM THE COORDINATION PROCESS. DRAWINGS SUBMITTED WILL BE REVIEWED FOR CLEARLY IDENTIFIED CONFLICTS ONLY. SOLUTIONS TO CONFLICTS WILL NOT BEAR ADDITIONAL COST.</p> <p><b>SHOP DRAWINGS</b></p> <p>CONTRACTOR SHALL SUBMIT SHOP DRAWINGS TO BE APPROVED, REVISED, OR RESUBMITTED AS PER THE ENGINEERS COMMENTS, PRIOR TO CONSTRUCTION. INCLUDING BUT NOT LIMITED TO THE FOLLOWING:</p> <p>-PLUMBING FIXTURES -PIPING -FITTINGS -INSULATION -PUMPS</p> <p>-CLEAN OUTS -PIPE SEALS -BRACINGS -EXPANSION TANKS -VALVES</p> <p>-DRAINS -COMPRESSORS -HANGERS/SUPPORTS -WATER HEATERS -THERMOSTATIC MIXING VALVES</p> <p><b>AS BUILT DRAWINGS</b></p> <p>PROVIDE A COMPLETE SET OF AS-BUILT DRAWINGS REFLECTING AS INSTALLED CONDITIONS. AS BUILT DRAWINGS SHALL BE PROVIDED TO THE UPSTREAM ENTRANCE OF THE CLEANOUT. FOR BUILDING DISCIPLINE, DRAWINGS SHALL BE OF SIMILAR SCALE AS THE CONSTRUCTION DOCUMENTS AND INCLUDE DETAILS AS NECESSARY TO CLEARLY REFLECT THE INSTALLED CONDITION. DRAWINGS SHALL BE PROVIDED TO THE OWNER AND ARCHITECT. THE CONTRACTOR SHALL PROVIDE AND MAINTAIN A SET OF PAPERWORK WILL NOT BE ACCEPTABLE AND WILL BE RETURNED FOR REVISION. THE CONTRACTOR SHALL COMPLY WITH THE ENGINEERS COMMENTS TO PRODUCE A CLEAR AND CONCISE SET OF DRAWINGS. DRAWINGS SHALL BE SUBMITTED IN BOTH HARD COPY AND ELECTRONIC (AUTO-CAD VERSION AS REQUIRED BY THE OWNER) VERSION. NUMBER OF COPIES OF EACH AS REQUESTED BY THE OWNER.</p> <p>PROVIDE "AS-BUILT DRAWINGS" INDICATING IN A NEAT AND ACCURATE MANNER A COMPLETE RECORD OF ALL REVISIONS OF THE ORIGINAL DESIGN OF THE WORK. INDICATE THE FOLLOWING INSTALLED CONDITIONS:</p> <p>INCLUDE ALL CHANGES AND AN ACCURATE RECORD, ON REPRODUCTIONS OF THE CONTRACT DRAWINGS OR APPROPRIATE SHOP DRAWINGS, OF ALL DEVIATIONS, BETWEEN THE WORK SHOWN AND WORK INSTALLED.</p> <p>MAINS AND BRANCHES OF PIPING SYSTEMS, WITH VALVES AND CONTROL DEVICES LOCATED AND NUMBERED; CONCEALED UNIONS LOCATED; AND WITH ITEMS REQUIRING MAINTENANCE LOCATED (IE: TRAPS, STRAINERS, EXPANSION COMPENSATORS, TANKS, ETC.). VALVE LOCATION DIAGRAMS, COMPLETE WITH VALVE TAG CHART.</p> <p>EQUIPMENT LOCATIONS (EXPOSED AND CONCEALED), DIMENSIONED FROM PROMINENT BUILDING LINES.</p> <p>APPROVED SUBSTITUTIONS, CONTRACT MODIFICATIONS, AND ACTUAL EQUIPMENT AND MATERIALS INSTALLED.</p> <p>CONTRACT MODIFICATIONS, ACTUAL EQUIPMENT AND MATERIALS INSTALLED.</p> <p>SUBMIT FOR REVIEW BOUND SETS OF THE REQUIRED DRAWINGS, MANUALS AND OPERATING INSTRUCTIONS.</p> <p>SUBMIT A COMPLETE MAINTENANCE MANUAL OF ALL EQUIPMENT INSTALLED UNDER THIS CONTRACT.</p> <p><b>HOUSEKEEPING PADS</b></p> <p>PROVIDE CONCRETE HOUSEKEEPING PADS FOR FLOOR-MOUNTED EQUIPMENT. COORDINATE EXACT LOCATIONS, DIMENSIONS, PIPING LOCATIONS, AND ANCHOR BOLT REQUIREMENTS. PROVIDE CONCRETE HOUSEKEEPING PADS UNDER ALL FLOOR MOUNTED EQUIPMENT. PADS SHALL BE CONSTRUCTED OF 3,000 PSI CONCRETE. PADS SHALL BE 4 INCHES HIGH, AND 4 INCHES WIDER THAN THE EQUIPMENT IN BOTH DIRECTIONS.</p> <p>COORDINATE FLOOR DRAIN LOCATIONS WITH RESPECT TO EQUIPMENT HOUSEKEEPING PADS. PLACE DRAINS SUCH THAT EDGE OF THE FLOOR GRATE EXTENDS NO FURTHER THAN 2 INCHES FROM THE SIDE OF THE PAD.</p> <p><b>HANGERS AND SUPPORT</b></p> <p>SEISMIC RESTRAINT: PROVIDE SEISMIC RESTRAINT AND EXPANSION OF ALL PLUMBING EQUIPMENT AND SYSTEMS IN ACCORDANCE WITH STATE AND FEDERAL BUILDING CODE REQUIREMENTS. SUBMIT SHOP DRAWINGS SIGNED AND SEALED BY A LICENSED PROFESSIONAL ENGINEER REGISTERED IN THE STATE OF THE PROJECT INDICATING ALL NECESSARY COMPONENT CUTS, PLAN LOCATIONS AND CALCULATIONS FOR A COMPLETE SYSTEM.</p> <p>PROVIDE ALL NECESSARY STRUCTURAL MEMBERS INCLUDING ADDITIONAL STRUCTURAL SUPPORT TO SUPPORT PIPING AND EQUIPMENT. HANGERS AND SUPPORTS SHALL BE OF AN APPROVED DESIGN NECESSARY TO SUPPORT PIPING, EQUIPMENT AND TO KEEP PIPING IN PROPER ALIGNMENT AND PREVENT TRANSMISSION OF INJURIOUS THRUSTS AND VIBRATIONS. IN ALL CASES WHERE HANGERS, BRACKETS, ETC., ARE SUPPORTED FROM CONCRETE CONSTRUCTION, DO NOT WEAKEN CONCRETE OR PENETRATE WATERPROOFING. ALL HANGERS AND SUPPORTS SHALL BE CAPABLE OF SCREW ADJUSTMENT AFTER PIPING IS ERECTED. HANGERS SUPPORTING PIPING EXPANDING INTO LOOPS, BENDS AND OFFSETS SHALL BE SECURED TO THE BUILDING STRUCTURE IN SUCH A MANNER THAT HORIZONTAL ADJUSTMENT PERPENDICULAR TO THE RUN OF PIPING SUPPORTED MAY BE MADE TO ACCOMMODATE DISPLACEMENT DUE TO EXPANSION. ALL SUCH HANGERS SHALL BE FINALLY ADJUSTED BOTH IN THE VERTICAL AND HORIZONTAL DIRECTION, AS REQUIRED. HANGERS IN CONTACT WITH COPPER OR BRASS PIPE SHALL BE DIELECTRIC, COMPATIBLE WITH COPPER AND BRASS ALLOY OR PROVIDED WITH FELT SLEEVE.</p> <p>PROVIDE ADDITIONAL SUPPORT FOR PIPING AND EQUIPMENT WHEN DECK IS NOT CAPABLE OF SUPPORT.</p> <p>BEAM CLAMPS - HANGERS SUPPORTED FROM STEEL SHALL BE CENTER LOADING BEAM CLAMPS FOR HANGERS SUPPORTING PIPING 2 INCHES. FOR PIPING 2-1/2 INCHES AND LARGER, 1 BEAM CLAMPS SHALL BE FORCED STEEL. "C" CLAMPS ARE NOT TO BE USED.</p> <p>PROVIDE AND INSTALL EXPANSION COMPENSATION FOR ALL PIPING. SUBMIT PLANS, CALCULATIONS AND EQUIPMENT DATA.</p> <p>BAND IRON, IE WIRE, METAL STRAPPING OR WIRE STRAPPING SHALL NOT BE PERMITTED TO SUPPORT PIPING OR EQUIPMENT.</p> <p><b>PIPE SEALS</b></p> <p>SEAL ALL PIPING PASSING THROUGH ALL FIRE AND/OR SMOKE RATED PARTITIONS AND WALLS WITH A UL LISTED, APPROVED AND TESTED FIRE AND/OR SMOKE SEALING MATERIAL, INSTALLED IN ACCORDANCE WITH MANUFACTURERS RECOMMENDATIONS.</p>	<p>ALL PIPING PENETRATING A SLAB ON GRADE OR FOUNDATION WALL BELOW GRADE AND IN CONTACT WITH EARTH SHALL BE PROVIDED WITH A POURED IN PLACE SCHEDULE 80 GALVANIZED STEEL WATER TIGHT SLEEVE WITH INTEGRAL WATER STOP AND SEAL EQUAL TO "LINK SEAL".</p> <p>FURNISH AND SET STEEL PIPE SLEEVES OF SCHEDULE 40 BLACK STEEL FOR ALL LOCATIONS OF INTERIOR PARTITIONS, WALLS AND FLOORS PROVIDING AT LEAST 1/2" CLEARANCE BETWEEN PIPE INSULATION AND SLEEVE OF PIPE AND SLEEVE. WALL SLEEVES SHALL BE SMOOTH CUT AND SET FLUSH WITH FINISHED WALLS. FLOOR SLEEVES SHALL EXTENDED 2" ABOVE THE FINISHED FLOOR.</p> <p>ALL PIPING THROUGH WALLS, FLOORS OR CEILINGS SHALL HAVE SLEEVES AND ESCUTCHEONS. PROVIDE A TWO PIECE CHROME ESCUTCHEON WHERE PIPING PASSES THROUGH WALLS OR FLOORS OF FINISHED SPACES.</p> <p><b>PLUMBING FIXTURES</b></p> <p>PLUMBING FIXTURES SHALL BE NEW, COMPLETE WITH TRIMMINGS AND FITTINGS, INCLUDING FAUCETS, CARRIERS, SUPPLIES, STOPS, TRAPS, TALLPIECES, WASTE PLUGS, CASINGS, HANGERS, PLATES, BRACKETS, ANCHORS, SUPPORTS, HARDWARE AND FASTENING DEVICES. NOTE: ALL FIXTURES SHALL BE OF SAME MANUFACTURER. TRIMMINGS AND FITTINGS SHALL BE CONSTRUCT OF FORGED, CAST, ROLLED OR EXTRUDED BRASS OR BRONZE WITH MONEL AND OTHER SUITABLE NON-CORROSIVE PARTS. DESIGNED WITH EASILY RENEWABLE PARTS THAT ARE SUBJECT TO WEAR OR DETERIORATION. NO DIE CASTINGS AND STAMPINGS OTHER THAN BRASS OR STAINLESS STEEL. PROVIDE PLUMBING FIXTURES AND TRIM WITH ALL NECESSARY TRIM, DEVICES AND ACCESSORIES REQUIRED FOR PROPER OPERATIONS SPECIFICALLY NOTED OR NOT.</p> <p>ESCUTCHEONS SHALL BE ONE-PIECE CHROME PLATED CAST BRASS OR STAINLESS STEEL.</p> <p>P-TRAPS SHALL BE ONE PIECE CHROME PLATED CAST BRASS WITH CLEANOUT PLUG.</p> <p>EXAMINE ROUGH-IN WORK OF POTABLE WATER AND WASTE PIPING SYSTEMS TO VERIFY ACTUAL LOCATIONS OF PIPING CONNECTIONS PRIOR TO INSTALLING FIXTURES. CORRECT ANY INCORRECT LOCATION OF PIPING, AND UNSATISFACTORY CONDITIONS FOR INSTALLATION OF PLUMBING FIXTURES. DO NOT PROCEED WITH WORK UNTIL UNSATISFACTORY CONDITIONS HAVE BEEN CORRECTED IN A MANNER ACCEPTABLE TO THE ENGINEER. ALL ROUGH-IN TO PLUMBING FIXTURES SHALL CONFORM TO FIXTURE MANUFACTURER PUBLISHED ROUGH-IN DIMENSIONS, AND REQUIREMENTS.</p> <p>UPON COMPLETION OF INSTALLATION OF PLUMBING FIXTURES AND AFTER UNITS ARE WATER PRESSURIZED, TEST FIXTURES TO DEMONSTRATE CAPABILITY AND COMPLIANCE WITH REQUIREMENTS. CORRECT MALFUNCTIONING UNITS AT SITE, THEN RETEST TO DEMONSTRATE COMPLIANCE; OTHERWISE, REMOVE AND REPLACE WITH NEW UNITS AND PROCEED WITH RETESTING.</p> <p>CLEAN PLUMBING FIXTURES, TRIM, AND STRAINERS OF DIRT AND DEBRIS UPON COMPLETION OF INSTALLATION.</p> <p>ADJUST WATER PRESSURE AT DRINKING FOUNTAINS, FAUCETS, SHOWER VALVES, AND FLUSH VALVES TO PROVIDE PROPER FLOW STREAM AND SPECIFIED GPM.</p> <p>SET FIXTURES LEVEL AND UNIFORMLY, WITH CONNECTIONS AT RIGHT ANGLES TO WALL AND PROPERLY CENTERED. LAY OUT ROUGHING ACCURATELY AND IN COORDINATION WITH SPACE AND FINISH REQUIREMENTS.</p> <p>LOCATE WASTE OUTLETS AND WATER SUPPLIES AT CONSTANT HORIZONTAL LEVELS, WITH WASTE FROM THE SEER OF THE PAD. CLEANOUT PLUGS SHALL BE BRASS OR PLASTIC, OR OTHER APPROVED MATERIALS. BRASS CLEANOUT PLUGS SHALL BE UTILIZED WITH METALLIC DRAIN, WASTE AND VENT PIPING ONLY, AND SHALL CONFORM TO ASTM A 74, ASME A112.3.1 OR ASME A112.36.1M. CLEANOUTS WITH PLATE-STYLE ACCESS COVERS SHALL BE FITTED WITH CORROSION-RESISTING FASTENERS. PLUGS SHALL HAVE RAISED SQUARE OR COUNTERSUNK SQUARE HEADS. COUNTERSUNK HEADS SHALL BE INSTALLED WHERE RAISED HEADS ARE A TRIP HAZARD. CLEANOUT PLUGS WITH BOROSILICATE GLASS SYSTEMS SHALL BE OF BOROSILICATE GLASS.</p> <p>PROVIDE TRAP PRIMERS FOR EACH FLOOR DRAIN. CONNECT TRAP PRIMER TO NEAREST COLD WATER MAIN. PROVIDE ISOLATION VALVE AND EXTEND TO FLOOR DRAIN AS REQUIRED.</p> <p>CLEANOUTS SHALL BE LOCATED AT MINIMUM INTERVALS OF 50 FEET FOR PIPING NPS 4 AND SMALLER AND 100 FEET FOR LARGER PIPING.</p> <p>BUILDING SEWERS SHALL BE PROVIDED WITH CLEANOUTS LOCATED NOT MORE THAN 100 FEET APART MEASURED FROM THE UPSTREAM ENTRANCE OF THE CLEANOUT. FOR BUILDING SEWERS 8 INCHES AND LARGER, MANHOLES SHALL BE PROVIDED AND LOCATED NOT MORE THAN 200 FEET FROM THE JUNCTION OF THE BUILDING DRAIN AND BUILDING SEWER, AT EACH CHANGE IN DIRECTION AND AT INTERVALS OF NOT MORE THAN 400 FEET APART. MANHOLES AND MANHOLE COVERS SHALL BE OF AN APPROVED TYPE.</p> <p>CLEANOUTS SHALL BE INSTALLED AT EACH CHANGE OF DIRECTION OF THE BUILDING DRAIN OR HORIZONTAL WASTE OR SOIL LINES GREATER THAN 45 DEGREES (INCLUDING P-TRAPS), WHERE MORE THAN ONE CHANGE OF DIRECTION OCCURS IN A RUN OF PIPING, ONLY ONE CLEANOUT SHALL BE REQUIRED FOR EACH 40 FEET OF DEVELOPED LENGTH OF THE DRAINAGE PIPING.</p> <p>A CLEANOUT SHALL BE PROVIDED AT THE BASE OF EACH WASTE OR SOIL STACK.</p> <p>THERE SHALL BE A CLEANOUT NEAR THE JUNCTION OF THE BUILDING DRAIN AND THE BUILDING SEWER. THE CLEANOUT SHALL BE EITHER INSIDE OR OUTSIDE THE BUILDING WALL AND SHALL BE BROUGHT UP TO THE FINISHED GROUND LEVEL OR TO THE BASEMENT FLOOR LEVEL. AN APPROVED TWO-WAY CLEANOUT IS ALLOWED TO BE USED AT THIS LOCATION TO SERVE AS A REQUIRED CLEANOUT FOR BOTH THE BUILDING DRAIN AND BUILDING SEWER. THE CLEANOUT AT THE JUNCTION OF THE BUILDING DRAIN AND BUILDING SEWER SHALL NOT BE REQUIRED IF THE CLEANOUT ON A 3-INCH OR LARGER DIAMETER SOIL STACK IS LOCATED WITHIN A DEVELOPED LENGTH OF 10 FEET OF THE BUILDING DRAIN AND BUILDING SEWER CONNECTION.</p> <p>CONCEALED PIPING: CLEANOUTS ON CONCEALED PIPING OR PIPING UNDER A FLOOR SLAB OR IN A CRAWL SPACE OF LESS THAN 24 INCHES IN HEIGHT OR A PLENUM SHALL BE EXTENDED THROUGH AND TERMINATE FLUSH WITH THE FINISHED WALL, FLOOR OR GROUND SURFACE OR SHALL BE EXTENDED TO THE OUTSIDE OF THE BUILDING. CLEANOUT PLUGS SHALL NOT BE COVERED WITH CEMENT, PLASTER OR ANY OTHER PERMANENT FINISH MATERIAL. WHERE IT IS NECESSARY TO CONCEAL A CLEANOUT OR TO TERMINATE A CLEANOUT IN AN AREA SUBJECT TO VEHICULAR TRAFFIC, THE COVERING PLATE, ACCESS DOOR OR CLEANOUT SHALL BE OF AN APPROVED TYPE DESIGNED AND INSTALLED FOR THIS PURPOSE.</p> <p>MINIMUM SIZE: CLEANOUTS SHALL BE THE SAME NOMINAL SIZE AS THE PIPE THEY SERVE UP TO 4 INCHES. FOR PIPES LARGER THAN 4 INCHES NOMINAL SIZE, THE MINIMUM SIZE OF THE CLEANOUT SHALL BE 4 INCHES.</p> <p>CAST-IRON CLEANOUT SIZING SHALL BE IN ACCORDANCE WITH ASTM A 74 FOR HUB AND SPIGOT FITTINGS OR ASTM A 888 OR C919 301 FOR HUBLESS FITTINGS.</p> <p>ACCESS SHALL BE PROVIDED TO ALL CLEANOUTS.</p> <p>PROVIDE CONDENSATE DRAINAGE, COMPLETE WITH CONDENSATE REMOVAL PUMP, FOR EACH COOLING COIL. CONDENSATE PUMP DISCHARGE SHALL BE CONNECTED VIA INDIRECT WASTE CONNECTION TO BUILDING SANITARY/WASTE PIPING SYSTEM. COORDINATE PUMP WIRING WITH PROJECT ELECTRICIAN. IF GRAVITY DRAINAGE IS POSSIBLE WITHIN THE CONSTRAINTS OF PIPING PITCH, CONCEALMENT ABOVE CEILINGS, AND ONLY AFTER COMPLETE COORDINATION WITH STRUCTURE AND OTHER TRADES, THE CONTRACTOR MAY SUBMIT SKETCH PROPOSALS FOR GRAVITY DRAINAGE FOR REVIEW/APPROVAL.</p> <p><b>MISCELLANEOUS SPECIALTIES</b></p> <p>ALL EQUIPMENT, VALVES, STRAINERS, UNIONS, TRAPS, FLANGES AND OTHER APPURTENANCES REQUIRING ACCESS SHALL BE LOCATED IN ACCESSIBLE LOCATIONS, WHEN A PIECE OF</p>	<p>EQUIPMENT MUST BE LOCATED ABOVE AN INACCESSIBLE CEILING OR WALL, THEN THE APPROPRIATE ACCESS DOOR SHALL BE PROVIDED. SUCH EQUIPMENT INCLUDES, BUT IS NOT LIMITED TO CLEANOUTS, WATER HAMMER ARRESTORS AND VALVES. THESE SHALL BE COORDINATED WITH THE ARCHITECT. ACCESS DOORS SHALL BE BUILT CONSTRUCTION WITH TWO HINGES AND A LATCH. IN PLENUM CEILINGS, PROVIDE FELT BETWEEN THE DOOR AND FRAME TO MAKE AN AIR TIGHT SEAL. ACCESS DOORS SHALL BE RATED TO THE SAME OR GREATER RATING OF THE PARTITION IN WHICH THEY ARE INSTALLED. ACCESS DOORS SHALL BE FLUSH MOUNTED, PRIME COATED WITH RUST INHIBITIVE PAINT, CONCEALED FRAME, FLUSH SCREW DRIVER OPERATED LOOKS WITH METAL CAMS AND ANCHORS AS REQUIRED.</p> <p>ACCESS DOOR SIZES SHALL BE: 12" X 12" AT EASILY ACCESSIBLE ITEMS 16" X 16" WHERE PARTIAL BODY ACCESS IS REQUIRED 24" X 24" WHERE FULL BODY ACCESS IS REQUIRED</p> <p>PROVIDE AND INSTALL DRIP PANS WITH WATER DETECTOR AND DRAIN FOR PIPING REQUIRED BY ACTUAL FIELD CONDITIONS WHERE PIPING PASSES OVER INCLUDING AREA WITHIN 3'-0" OF ELECTRICAL EQUIPMENT.</p> <p>DO NOT INSTALL AIR CAP BACKFLOW PREVENTERS IN CONCEALED SPACES OR IN AREAS WHERE SPLASHING WATER WILL DAMAGE FINISHES. PROVIDE AND INSTALL AN OVERSIZED COPPER FUNNEL WITH AIR GAP DIRECTLY BELOW RPD PRESSURE RELIEF PORT. PIPE FUNNEL TO SPILL AS AN INDIRECT WASTE TO AN APPROVED DRAIN LOCATION.</p> <p>INSTALL ELECTRONIC TRAP PRIMERS SERVING ALL DRAINS. INSTALL ALL TRAP PRIMER VALVES IN AN ACCESSIBLE LOCATION. PROVIDE AND INSTALL ACCESS PANELS AND DOORS WHERE REQUIRED TO GAIN ACCESS IN CONCEALED CONSTRUCTION.</p> <p>PROVIDE FLEXIBLE CONNECTIONS IN ALL PIPING SYSTEMS CONNECTED TO PUMPS AND OTHER EQUIPMENT WHICH REQUIRES VIBRATION ISOLATION, EXCEPT WATER COILS. FLEXIBLE CONNECTIONS SHALL BE PROVIDED AS CLOSE TO THE EQUIPMENT AS POSSIBLE.</p> <p><b>PIPING GENERAL</b></p> <p>NO PIPING SHALL BE COVERED UNTIL TESTED APPROVED BY THE AUTHORITIES HAVING JURISDICTION.</p> <p>ALL PIPING SHALL BE RUN PERPENDICULAR AND/OR PARALLEL TO FLOORS, INTERIOR WALLS, ETC. PIPING AND VALVES SHALL BE GROUPED NEATLY AND SHALL BE RUN AS TO MAXIMIZE HEADROOM OR PASSAGE CLEARANCE. ALL VALVES, CONTROLS AND ACCESSORIES CONCEALED IN FURRED SPACES AND REQUIRING ACCESS FOR OPERATION AND MAINTENANCE SHALL BE ARRANGED TO ASSURE THE USE OF A MINIMUM NUMBER OF ACCESS DOORS.</p> <p>ALL PIPE LINES MADE WITH SCREWED FITTINGS MUST BE PROVIDED WITH A SUFFICIENT NUMBER OF FLANGES AND/OR UNIONS TO ALLOW FOR EASY AND CONVENIENT DISMANTLING OF THE SYSTEM WITHOUT BREAKING FITTINGS.</p> <p>ALL PIPING SHALL RUN CONCEALED IN FURRED SPACES OF OCCUPIED AREAS OR CHASES. CONTRACTOR SHALL OBTAIN PERMISSION TO RUN ANY EXPOSED PIPES.</p> <p>CAP ALL PIPE AND EQUIPMENT OUTLETS DURING CONSTRUCTION AND KEEP LINES AND INSIDE OF EQUIPMENT FREE OF FOREIGN MATERIALS.</p> <p>PROVIDE FOR EXPANSION WITHOUT WARPING OR DISLOCATING LINES OR STRAINING CONNECTED EQUIPMENT. INSTALL PIPING TO CLEAR BUILDING CONSTRUCTION AND TO AVOID INTERFERENCE WITH OTHER BUILDING WORK. THE CONTRACTOR SHALL PROVIDE AND MAINTAIN A COMPLETE PIPING EXPANSION SYSTEM (INCLUDING SEISMIC JOINT EXPANSION) AND DEVICES AS REQUIRED FOR PROPER EXPANSION COMPENSATION STAMPED BY A PROFESSIONAL ENGINEER LICENSED IN THE STATE OF THE PROJECT.</p> <p>THE DRAWINGS INDICATE SCHEMATICALLY THE SIZE AND LOCATION OF PIPING. PIPING SHALL BE SET UP AND DOWN AND OFFSET AS REQUIRED TO MEET CONSTRUCTION CONDITIONS.</p> <p>THIS CONTRACTOR SHALL INFORM HIMSELF FROM THE GENERAL CONSTRUCTION SPECIFICATIONS AND PLANS, OF THE EXACT DIMENSION OF FINISHED WORK AND OF THE HEIGHT OF FINISHED CEILINGS IN ALL ROOMS WHERE EQUIPMENT OR PIPES ARE TO BE PLACED AND ARRANGE HIS WORK IN ACCORDANCE WITH THE SCHEDULE OF INTERIOR FINISHES, AS INDICATED ON THE ARCHITECTURAL DRAWINGS.</p> <p>WATER PIPING SHALL BE RUN FREE OF TRAPS AND UNNECESSARY BENDS. ANY TRAPS FORMED SHALL BE PROVIDED WITH HOSE END DRAIN VALVES WITH THREADED CAP AND CHAIN TO COMPLETELY DRAIN THE VALVES.</p> <p>PROVIDE SECTION CUT-OFF VALVES ON ALL MAINS AND BRANCHES. PITCH AND VALVE ALL WATER PIPING FOR CONVENIENT DRAINAGE.</p> <p>UNIONS AND/OR FLANGES SHALL BE INSTALLED AT EACH PIECE OF EQUIPMENT, IN BYPPASSES AND IN LONG PIPING RUNS (100 FEET OR MORE) TO PERMIT DISASSEMBLY FOR ALTERATION AND REPAIRS.</p> <p>WHEREVER DISSIMILAR METALS ARE JOINED TOGETHER AN APPROVED DIELECTRIC FITTING SHALL BE USED. THE DIELECTRIC FITTING SHALL BE A LISTED ASSEMBLY.</p> <p>RUN ALL SOIL, WASTE AND VENT PIPING SHOWN OR REQUIRED BY LOCAL CODES. PIPING SHOWN IS MINIMUM AND IN ACCORDANCE WITH STATE AND FEDERAL CODES. IF LOCAL CODES REQUIRE ADDITIONAL VENTING OR LARGER SIZES, PROVIDE AS REQUIRED.</p> <p>MAKE ALL CONNECTIONS THROUGH TRAPS. EACH TRAP TO BE VENTED, EITHER BY CIRCUIT, LOOP, OR INDIVIDUAL VENT, AS REQUIRED, BUT NOT LESS THAN SHOWN, OR AS REQUIRED BY LOCAL CODE.</p> <p>ALL UNDERGROUND PIPING SHALL BE Laid ON 6" SAND AND BACKFILLED WITH CLEAN FINE EARTH COMPACTED TO 12" ABOVE PIPE. COMPLETE BACKFILL WITH AVAILABLE EARTH FREE OF LARGE BouldERS AND SHARP ROCKS. TAMP BACKFILL IN 6" ELEVATIONS AND OVERLIFT TO ALLOW FOR SETTLEMENT.</p> <p>SET AND PROPERLY CONNECT ALL FIXTURES WITH HOT AND COLD WATER, VENT AND DRAINAGE PIPING, AS REQUIRED AND PROTECT FIXTURES UNTIL ACCEPTANCE AND TEST. CLEAN ALL FLUSH VALVES AFTER TWO WEEKS OF OPERATION.</p> <p>INSTALL THRUST BLOCKS FOR UNDERGROUND WATER PIPING AT ALL CHANGES IN DIRECTION BOTH HORIZONTALLY AND VERTICALLY. THRUST BLOCKS SHALL BEAR AGAINST UNDISTURBED EARTH OR EARTH. THRUST BLOCKS SHALL BE INSTALLED IN ACCORDANCE WITH THE DUCTILE IRON PIPE RESEARCH ASSOCIATION (DIPRA) MANUAL, "THRUST RESTRAINT DESIGN FOR DUCTILE IRON PIPE" AND LOCAL UTILITY COMPANY REQUIREMENTS.</p> <p><b>GAS PIPING</b></p> <p>INSTALL GAS PIPING, AND GAS PIPING SPECIALTIES IN ACCORDANCE WITH NFPA 54, AND AUTHORITIES HAVING JURISDICTION.</p> <p>PROVIDE AND INSTALL INDEPENDENT GAS PRESSURE REGULATOR VENTS TO THE EXTERIOR AS REQUIRED IN NFPA 54 AND THE REGULATOR MANUFACTURERS REQUIREMENTS.</p> <p>LOCATE GAS PIPING WITH ADEQUATE SEPARATION BETWEEN ELECTRICAL CABLES, EQUIPMENT, AND CONDUIT.</p> <p>SLOPE GAS PIPING TO LOW POINTS WITHOUT TRAPS. PROVIDE DRIPS (PIPE TEE, NIPPLE, AND CAP) AT BOTTOM OF ALL VERTICAL RISERS AND DROPS.</p> <p>MAKE BRANCH CONNECTIONS TO MAINS FROM TOP OR SIDE, NOT FROM BOTTOM OF MAIN.</p> <p>PROVIDE AND INSTALL GAS SHUT-OFF VALVES FOR THE PROPER AND SAFE CONTROL OF THE SYSTEM.</p> <p>DO NOT LOCATE GAS VALVES IN SPACES USED AS AIR PLenums.</p> <p>VERIFICATION: BEFORE MAKING A GAS CONNECTION, VERIFY THAT EQUIPMENT IS COMPATIBLE WITH THE TYPE AND PRESSURE OF GAS BEING SUPPLIED.</p> <p>PURGING: PURGE GAS TO SAFE LOCATION.</p>

PLUMBING DEMOLITION NOTES	
ALL EQUIPMENT, FIXTURES, PIPING ETC. TO BE REMOVED SHALL BE DISPOSED OF, TURNED OVER TO THE OWNER, OR SALVAGED AS DIRECTED BY THE OWNER. EQUIPMENT, FIXTURES, PIPING, DEVICES, ETC. SHALL NOT BE REMOVED FROM THE PREMISES WITH OUT THE OWNERS APPROVAL.	
ALL ABANDONED PIPING TO REMAIN SHALL BE PROPERLY PLUGGED, VALVED, CAPPED AND/OR BY PASSED SUCH THAT UPON COMPLETION OF WORK ALL ABANDONED SYSTEMS ARE PROPERLY CONCEALED, AND THAT EXISTING SYSTEMS TO REMAIN, REMAIN OPERATIONAL.	
NO DEAD ENDS SHALL BE LEFT ON ANY PIPING SYSTEMS UPON COMPLETION OF WORK.	
PATCH ALL WALLS, FLOORS, CEILINGS, AND ROOFS TO MATCH EXISTING IN ALL CASES WHERE EXISTING WALLS, FLOORS, CEILINGS, AND ROOFS REMAIN AND PLUMBING DEMOLITION IS INDICATED.	
EXISTING EXPOSED PIPING SYSTEMS NOT TO BE REUSED, AND NOT SPECIFICALLY NOTED FOR REMOVAL SHALL BE COMPLETELY REMOVED. CONTRACTOR SHALL VERIFY PRIOR TO REMOVAL WORK.	
ALL SYSTEMS SHALL BE LEFT IN PERFECT WORKING ORDER UPON COMPLETION OF ALL NEW WORK.	
ALL EXISTING EXPOSED, UNNECESSARY PIPING RELATED TO NEW WORK SHALL BE COMPLETELY REMOVED.	
REROUTE OR REMOVE ALL EXISTING PIPING, AND SYSTEMS WHERE NECESSARY TO AVOID NEW EQUIPMENT, STRUCTURAL, OR MASONRY WORK AS REQUIRED BY THE PROPOSED ALTERATIONS.	
COORDINATE PLUMBING SERVICES SHUT DOWNS (H&OV, GAS, WASTE, VENT & STORM SYSTEMS) WITH THE BUILDING MANAGER AND UTILITY COMPANY.	

PLUMBING PIPING SYSTEM LEGEND		
EXISTING	NEW	DESCRIPTION
---	---	DOMESTIC COLD WATER
---	---	DOMESTIC HOT WATER SUPPLY
140'	140'	DOMESTIC 140°F HOT WATER SUPPLY
---	---	DOMESTIC HOT WATER RETURN
S	S	SANITARY WASTE
---	---	SANITARY WASTE BELOW SLAB
V	V	SANITARY VENT
ST	ST	STORM DRAIN
---	---	STORM DRAIN BELOW SLAB
OS	OS	OVERFLOW STORM
G	G	NATURAL GAS
---	---	NATURAL GAS BELOW SLAB
RV	RV	RADON VENT
CD	CD	CONDENSATE DRAIN
FM	FM	FORCE MAIN
---	---	FORCE MAIN BELOW SLAB
W	W	INDIRECT WASTE
GW	GW	GREASE WASTE
---	---	GREASE WASTE BELOW SLAB
AW	AW	ACID WASTE
---	---	ACID WASTE BELOW SLAB
AV	AV	ACID VENT

PLUMBING SYMBOL LEGEND	
SYMBOL	DESCRIPTION
	BALANCING VALVE
	BALL VALVE
	CHECK VALVE
	GAS VALVE
	PRESSURE RELIEF VALVE
	THERMOSTATIC MIXING VALVE
	GATE VALVE
	SUPPLY VALVE
	REDUCED PRESSURE BACKFLOW PREVENTER
	CLOTHES WASHER CONNECTION
	FLOOR CLEANOUT
	FLOOR DRAIN
	FLOOR SINK WITH FULL GRATE
	FLOOR SINK WITH HALF GRATE
	FLOOR SINK WITH THREE-QUARTER GRATE
	HUB DRAIN
	ROOF DRAIN
	ROOF OVERFLOW DRAIN
	TRENCH DRAIN
HB 	HOSE BIBB
	POINT OF NEW CONNECTION
	POINT OF DISCONNECTION
	VENT THROUGH ROOF
	RECIRCULATION PUMP
	"P" TRAP
	PIPE DOWN
	PIPE UP
	CAPPED PIPE
	CLEANOUT PLUG
	UNION
	DIRECTION OF FLOW
	PIPE OR EQUIPMENT TO BE DEMOLISHED
	PLUMBING FIXTURE
	ADA COMPLIANT PLUMBING FIXTURE


PLUMBING DRAWING LIST	
DRAWING NUMBER	DRAWING DESCRIPTION
P001-1	BUILDING 1 - COVER SHEET - PLUMBING
P010-1	BUILDING 1 - LOWER LEVEL DEMOLITION PLAN - PLUMBING
P020-1	BUILDING 1 - MAIN LEVEL DEMOLITION PLAN - PLUMBING
P030-1	BUILDING 1 - SECOND LEVEL FLOOR DEMOLITION PLAN - PLUMBING
P040-1	BUILDING 1 - THIRD FLOOR LEVEL DEMOLITION PLAN - PLUMBING
P050-1	BUILDING 1 - ROOF DEMOLITION PLAN - PLUMBING
P060-1	BUILDING 1 - UNDER SLAB PLAN - PLUMBING
P101-1	BUILDING 1 - LOWER LEVEL PLAN - PLUMBING
P102-1	BUILDING 1 - MAIN LEVEL PLAN - PLUMBING
P140-1	BUILDING 1 - THIRD LEVEL FLOOR PLAN - PLUMBING
P150-1	BUILDING 1 - ROOF PLAN - PLUMBING
P200-1	BUILDING 1 ENLARGED KITCHEN PLAN - PLUMBING
P201-1	BUILDING 1 - LOWER LEVEL PART PLANS - PLUMBING
P202-1	BUILDING 1 - LOWER LEVEL PARTIAL PLANS - PLUMBING
P203-1	BUILDING 1 - PARTIAL PLANS - PLUMBING
P204-1	BUILDING 1 - PARTIAL PLANS - PLUMBING
P205-1	BUILDING 1 - PARTIAL PLANS - PLUMBING
P300-1	BUILDING 1 - DETAILS - PLUMBING
P301-1	BUILDING 1 - DETAILS - PLUMBING
P400-1	BUILDING 1 - SCHEDULES - PLUMBING

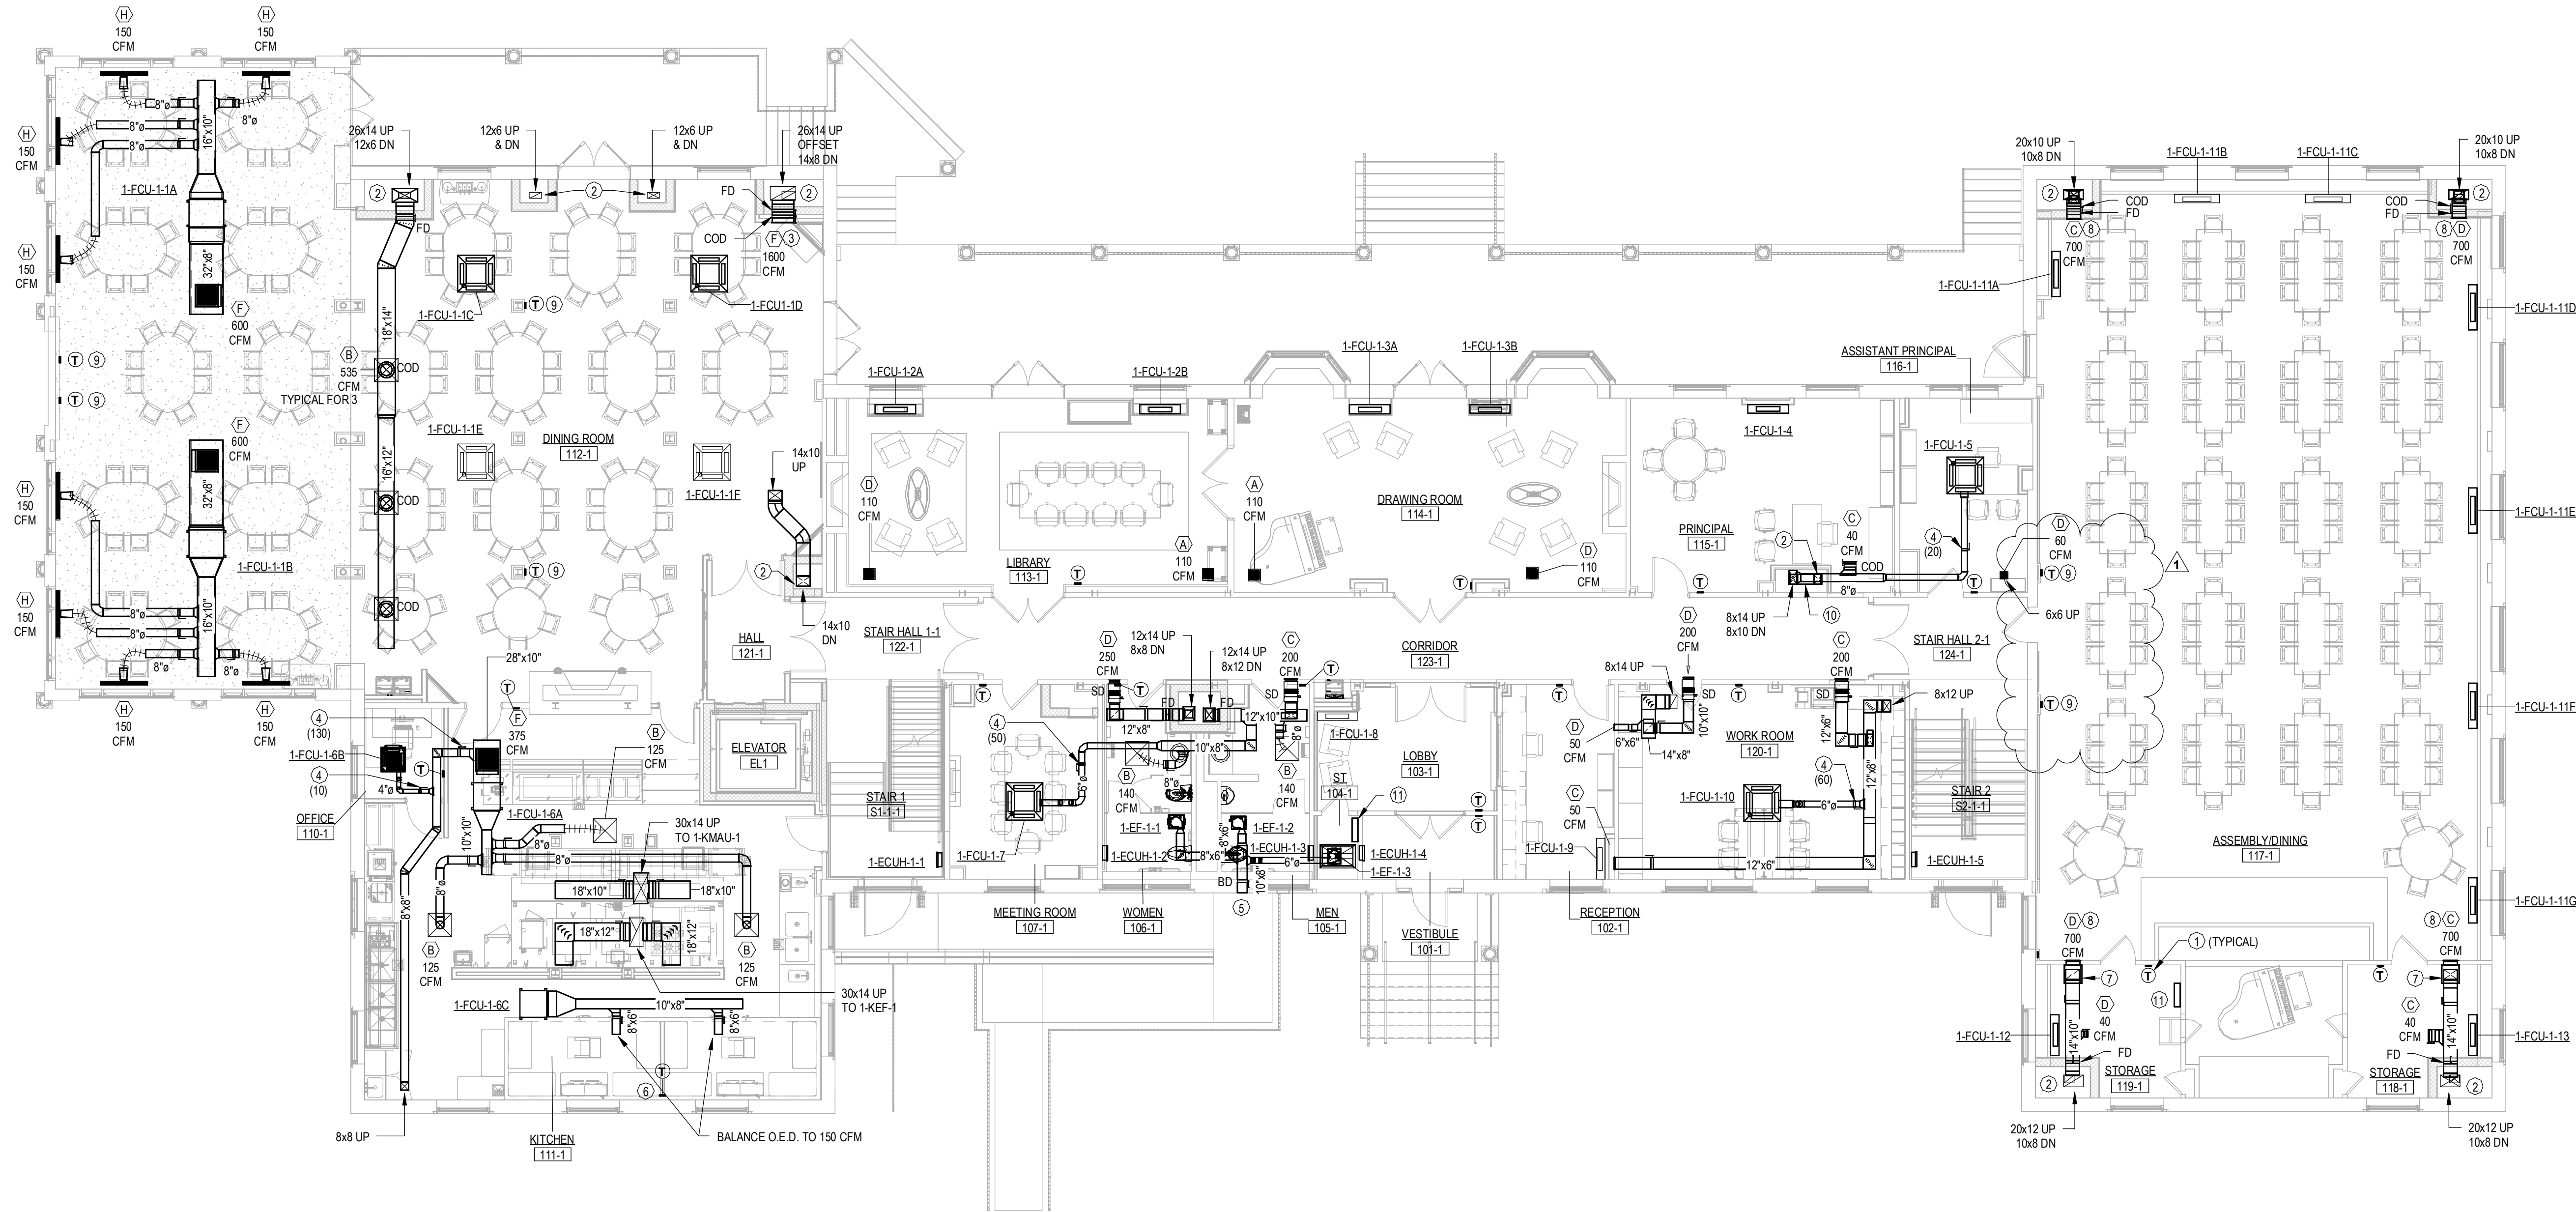


1 FIRST FLOOR DUCT PLAN

1/8" = 1'-0"

- ### GENERAL NOTES
- REFER TO DRAWING M001 FOR ADDITIONAL MECHANICAL NOTES.
  - UPON COMPLETION OF CONSTRUCTION, CONTRACTOR TO HIRE A CERTIFIED TESTING & BALANCING (TAB) CONTRACTOR TO BALANCE ALL NEW HVAC EQUIPMENT (DOAS-# EF-# ETC.) AND ASSOCIATED DIFFUSERS / GRILLES TO AIR FLOWS (CFM) INDICATED ON DRAWINGS. CONTRACTOR TO ALSO REFER TO SPECIFICATION SECTION 230593 "TESTING, ADJUSTING, AND BALANCING FOR HVAC" FOR ADDITIONAL REQUIREMENTS.
  - ALL NEW DUCTWORK & PIPING SHALL BE INSULATED AND LABELED. REFER TO SCHEDULES FOR INSULATION CHART. LABELS SHALL BE SET ON CODE SELF-ADHESIVE DUCT MARKERS. LABELS SHALL BE LOCATED EVERY 20 FEET AND ON BOTH SIDES OF WALL PENETRATIONS.
  - SIZES ASSOCIATED WITH ACOUSTICALLY LINED DUCTWORK REPRESENTS THE INTERNAL FREE AREA DIMENSION OF THE DUCTWORK REQUIRED.
  - CONTRACTOR TO PROVIDE ALL PENETRATIONS WITHIN WALLS, FLOORS, CEILINGS, ROOF, ETC. AS NECESSARY TO ACCOMMODATE NEW WORK. REFER TO ALL HAZARDOUS MATERIALS ABATEMENT PLANS AND SPECIFICATIONS FOR ADDITIONAL REQUIREMENTS AND COORDINATE ALL WORK WITH THE HAZARDOUS MATERIALS ABATEMENT CONTRACTOR.
  - CONTRACTOR SHALL PROVIDE ALL CONTROL DEVICES, RELAYS, SENSORS, PANELS, TRANSFORMERS, LOW VOLTAGE WIRING, PROGRAMMABLE CONTROLLERS, PROGRAMMING, ETC. NECESSARY TO ACHIEVE THE SEQUENCE OF OPERATION IN SPECIFICATION SECTION 230593 "SEQUENCE OF OPERATION FOR HVAC CONTROLS".
  - REFER TO PLUMBING DRAWINGS FOR CONDENSATE PIPING.
  - CONTRACTOR TO MAINTAIN EQUIPMENT MANUFACTURERS REQUIRED SERVICE CLEARANCES.
  - REFER TO HVAC PIPING DRAWINGS FOR REFRIGERANT PIPING.
  - DUCTWORK GREATER THAN 8" DEEP MUST SPLIT INTO TWO SEPARATE DUCTS WHEN PENETRATING FLOOR IN ORDER TO FIT BETWEEN FLOOR BEAMS. REFER TO DETAIL SCHEDULE ON DRAWING M400-1. DUCT RISERS WITHIN CMU CHASES DO NOT APPLY.
- ### MECHANICAL NOTES
- PROVIDE NEW COMBINATION WALL MOUNTED DDC THERMOSTAT WITH HUMIDITY. THERMOSTAT SHALL BE LABELED W/ ASSOCIATED HVAC EQUIPMENT (FCU-#) PRIOR TO OCCUPANCY.
  - PROVIDE FIRE DAMPER AT FLOOR PENETRATION AND DUCT ACCESS DOOR FOR MAINTENANCE SERVICE. REFER TO ARCHITECTURAL DRAWING FOR WALL ACCESS DOOR REQUIREMENTS.
  - BOTTOM OF DIFFUSER / GRILLE SHALL BE LOCATED 7'-0" AFF.
  - BALANCE VENTILATION AIR DUCT TO AIR FLOW (CFM) INDICATED.
  - CONNECT NEW EXHAUST DUCTWORK TO EXISTING EXTERIOR LOUVER TO REMAIN.
  - PROVIDE NEW DDC THERMOSTAT FOR 1-FCU-6C ABOVE CEILING TO MONITOR SPACE TEMPERATURE BY THE COMPRESSORS LOCATED ON TOP OF THE COOLERS. 1-FCU-6C SHALL MAINTAIN A TEMPERATURE OF 80F IN THAT AREA. THERMOSTAT SHALL BE LABELED W/ ASSOCIATED HVAC EQUIPMENT (FCU-#) PRIOR TO OCCUPANCY.
  - PROVIDE 16Lx16"Wx16"H A.L. PLENUM.
  - BOTTOM OF DIFFUSER / GRILLE SHALL BE LOCATED 6'-0" AFF.
  - PROVIDE VANDAL RESISTANT THERMOSTAT COVERS.
  - OFFSET 8x10 DUCT WITHIN CHASE AFTER 8" TAKEOFF SERVING THE MAIN LEVEL.
  - CONTRACTOR TO PROVIDE NEW TEMPERATURE CONTROL PANEL (TCP). CONTRACTOR TO PROVIDE ALL CONTROL DEVICES, PANELS, RELAYS, SENSORS, TRANSFORMERS, LOW VOLTAGE WIRING, PROGRAMMABLE CONTROLLERS, PROGRAMMING, ETC. NECESSARY TO ACHIEVE THE SEQUENCE OF OPERATIONS IN SPECIFICATION SECTION 230593 SEQUENCE OF OPERATION FOR HVAC CONTROLS.

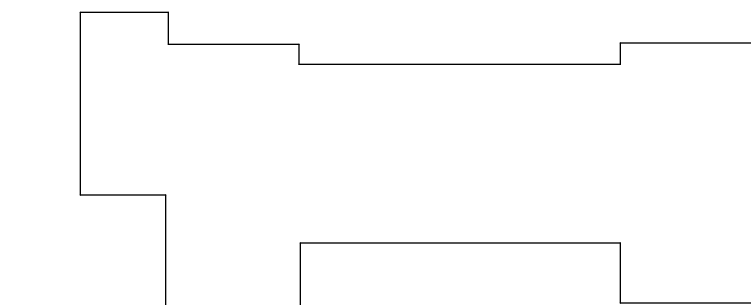

KEY PLAN  
SCALE: NTS

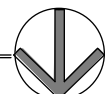

Project Title:  
**ALTERATIONS TO:  
ACES at Chase**  
565 Chase Parkway  
Waterbury, Connecticut 06708



**SILVER PETRUCCELLI + ASSOCIATES**  
3190 WHITNEY AVENUE HAMDEN CT 06518  
311 STATE STREET NEW LONDON CT 06320  
203 230 9007 silverpetrucci.com

Revision:	Description:	Date:	Revised By:
1	Bulletin #1	12/16/25	WJY

Drawing Title:  
**BUILDING 1 - MAIN LEVEL PLAN -  
DUCTWORK**  
Project Phase:  
**ISSUED FOR BID - 11/03/2025**  
State Project Number:  
**#244-0044 MAG**


Date:  
AUGUST 12, 2025  
Scale:  
1/8" = 1'-0"  
Drawn By:  
WJY  
Project Number:  
22.050

Drawing Number:

**M111-1**

12/16/2025 9:51:17 AM



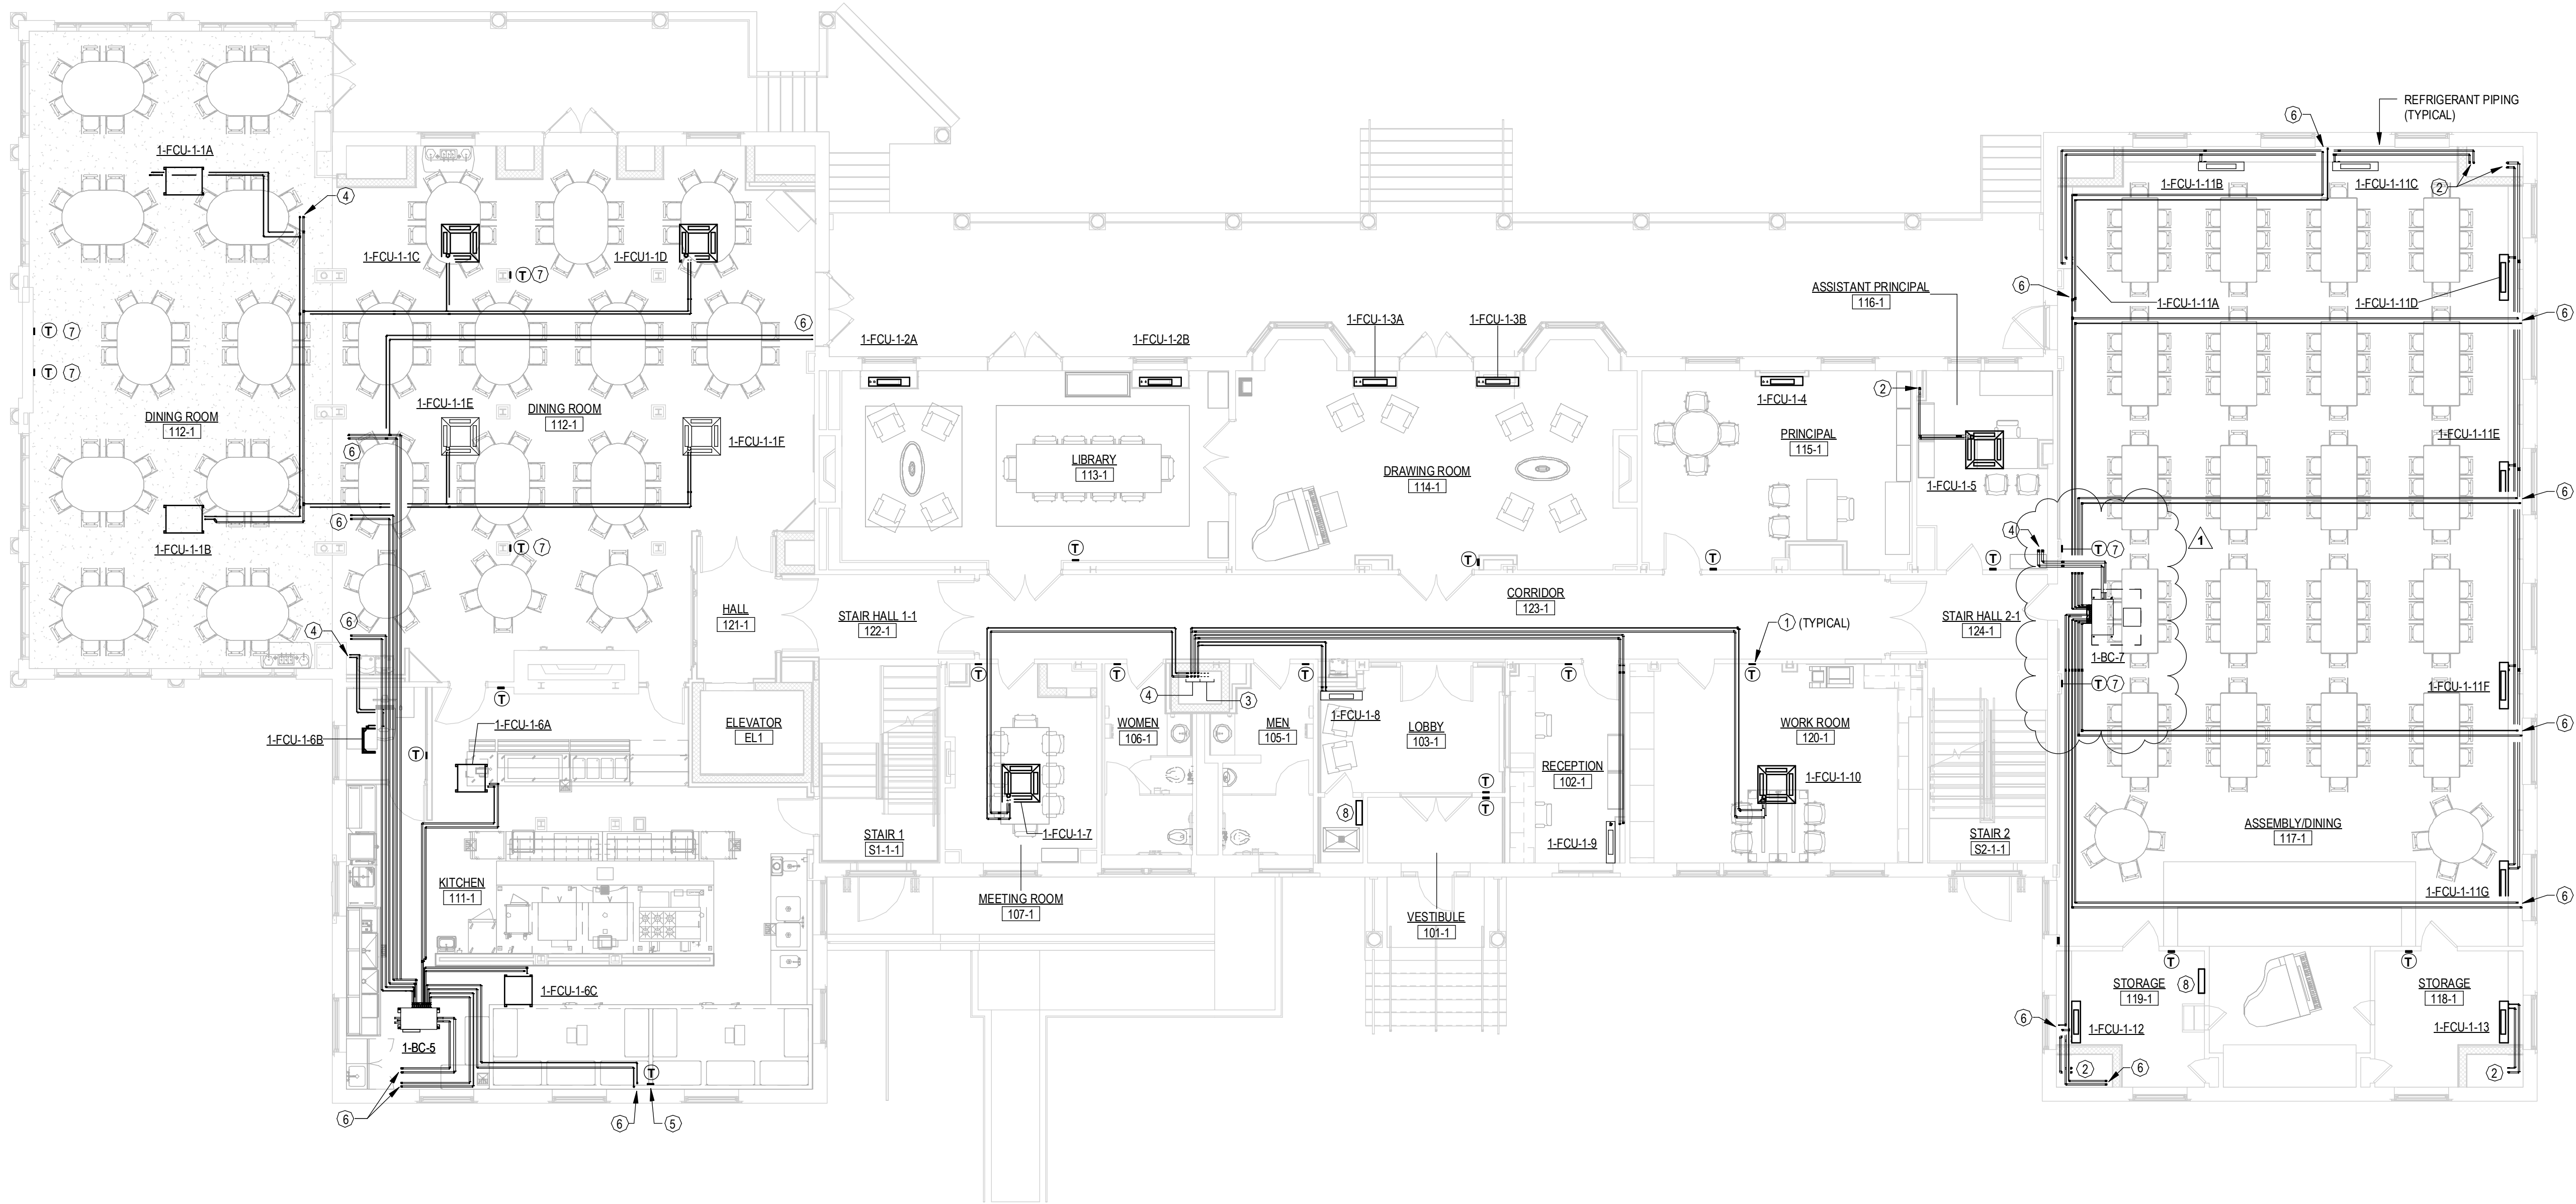

- GENERAL NOTES
1.

REFER TO DRAWING M001 FOR ADDITIONAL MECHANICAL NOTES.
2.

UPON COMPLETION OF CONSTRUCTION, CONTRACTOR TO HIRE A CERTIFIED TESTING & BALANCING (TAB) CONTRACTOR TO BALANCE ALL NEW HVAC EQUIPMENT (DOAS-# EF-# ETC.) AND ASSOCIATED DIFFUSERS / GRILLES TO AIR FLOWS (CFM) INDICATED ON DRAWINGS. CONTRACTOR TO ALSO REFER TO SPECIFICATION SECTION 230593 "TESTING, ADJUSTING, AND BALANCING FOR HVAC" FOR ADDITIONAL REQUIREMENTS.
3.

ALL NEW DUCTWORK & PIPING SHALL BE INSULATED AND LABELED. REFER TO SCHEDULES FOR INSULATION CHART. LABELS SHALL BE SET ON CODE SELF-ADHESIVE DUCT MARKERS. LABELS SHALL BE LOCATED EVERY 20 FEET AND ON BOTH SIDES OF WALL PENETRATIONS.
4.

CONTRACTOR TO PROVIDE ALL PENETRATIONS WITHIN WALLS, FLOORS, CEILINGS, ROOF, ETC AS NECESSARY TO ACCOMMODATE NEW WORK. REFER TO ALL HAZARDOUS MATERIALS ABATEMENT PLANS AND SPECIFICATIONS FOR ADDITIONAL REQUIREMENTS AND COORDINATE ALL WORK WITH THE HAZARDOUS MATERIALS ABATEMENT CONTRACTOR.
5.

CONTRACTOR SHALL PROVIDE ALL CONTROL DEVICES, RELAYS, SENSORS, PANELS, TRANSFORMERS, LOW VOLTAGE WIRING, PROGRAMMABLE CONTROLLERS, PROGRAMMING, ETC. NECESSARY TO ACHIEVE THE SEQUENCE OF OPERATION IN SPECIFICATION SECTION 230993 "SEQUENCE OF OPERATION FOR HVAC CONTROLS".
6.

SIZE AND ROUTE REFRIGERATION PIPING TO/FROM INDOOR FAN COIL UNIT (FCU-#) TO RESPECTIVE OUTDOOR UNIT (CU-#) PER EQUIPMENT MANUFACTURER'S REQUIREMENTS.
7.

REFRIGERANT PIPING ROUTED UP THE BUILDING EXTERIOR WALL SHALL BE COVERED. CONTRACTOR TO PROVIDE COVER SIMILAR TO DUCTLESS AIRE HIDE-A-LINE COVER KITS.
8.

REFER TO PLUMBING DRAWINGS FOR CONDENSATE PIPING.
9.

CONTRACTOR TO MAINTAIN EQUIPMENT MANUFACTURER'S REQUIRED SERVICE CLEARANCES.
- MECHANICAL NOTES
- ①

PROVIDE NEW COMBINATION WALL MOUNTED DDC THERMOSTAT WITH HUMIDITY. THERMOSTAT SHALL BE LABELED W ASSOCIATED HVAC EQUIPMENT (FCU-#) PRIOR TO OCCUPANCY.
- ②

REFRIGERANT PIPING DOWN.
- ③

REFRIGERANT PIPING UP & DOWN.
- ④

REFRIGERANT PIPING UP.
- ⑤

PROVIDE NEW DDC THERMOSTAT FOR 1-FCU-6C ABOVE CEILING TO MONITOR SPACE TEMPERATURE BY THE COMPRESSORS LOCATED ON TOP OF THE COILERS. 1-FCU-6C SHALL MAINTAIN A TEMPERATURE OF 80F IN THAT AREA. THERMOSTAT SHALL BE LABELED W ASSOCIATED HVAC EQUIPMENT (FCU-#) PRIOR TO OCCUPANCY.
- ⑥


REFRIGERANT PIPING UP TO FLOOR MOUNTED FAN COIL UNIT(S) ON LEVEL 2.
- ⑦

PROVIDE VANDAL RESISTANT THERMOSTAT COVERS.
- ⑧

CONTRACTOR TO PROVIDE NEW TEMPERATURE CONTROL PANEL (TCP). CONTRACTOR TO PROVIDE ALL CONTROL DEVICES, PANELS, RELAYS, SENSORS, TRANSFORMERS, LOW VOLTAGE WIRING, PROGRAMMABLE CONTROLLERS, PROGRAMMING, ETC. NECESSARY TO ACHIEVE THE SEQUENCE OF OPERATIONS IN SPECIFICATION SECTION 230993 SEQUENCE OF OPERATION FOR HVAC CONTROLS.

1 FIRST FLOOR PIPING PLAN

1/8" = 1'-0"

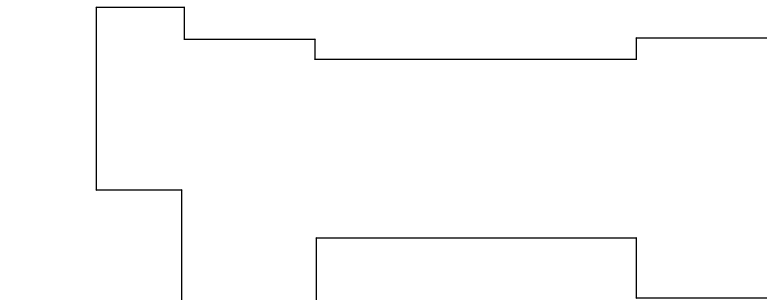

KEY PLAN  
SCALE: NTS

Project Title:  
ALTERATIONS TO:  
ACES at Chase  
565 Chase Parkway  
Waterbury, Connecticut 06708



SILVER PETRUCCELLI + ASSOCIATES  
3190 WHITNEY AVENUE HAMDEN CT 06518  
311 STATE STREET NEW LONDON CT 06320  
203 230 9007 silverpetrucelli.com

Revision:	Description:	Date:	Revised By:
1	Bulletin #1	12/16/25	WJY

Drawing Title:  
BUILDING 1 - MAIN LEVEL PLAN -  
PIPING  
Project Phase:  
ISSUED FOR BID - 11/03/2025  
State Project Number:  
#244-0044 MAG

Date:  
AUGUST 12, 2025  
Scale:  
1/8" = 1'-0"  
Drawn By:  
WJY  
Project Number:  
22.050

Drawing Number:

M211-1

12/16/2025 9:55:35 AM



MITSUBISHI ELECTRIC TRANE HVAC US: CITY MULTI VRF INDOOR UNIT SCHEDULE																											
System Tag	Room Name	Tag Reference	M-NET Address	Model	Type	Nominal Cooling Capacity (BTU/h)	Nominal Heating Capacity (BTU/h)	Cooling Design Entering Temp DB/WB (°F) / [Water in temp]	Heating Design Entering Temp DB/WB (°F) / [Water in temp]	Cooling Diversity Full/Partial (See Note 5, 6)	Heating Diversity Full/Partial (See Note 5, 6)	Corrected Capacity Cooling Total Capacity (BTU/h)	Corrected Capacity Heating Diversity Full/Partial (See Note 5, 6)	Heating Capacity (BTU/h)	Estimated Cooling Coil LAT (°F) / [LWT]	Estimated Heating Coil LAT (°F) / [LWT]	Refrig Pipe Dim Liquid/Section (inch)	Fan Speed Setting	Peak Fan Airflow (cfm) / [Design gpm GUS]/min	Max Fan ESP Setting 208V/230V (N WG)	Voltage / Phase	Power Cooling 208V/230V (kW)	Power Heating 208V/230V (kW)	Electrical MCA/MFS	Condensate Removal Rate (gal/hr)	Remarks	
1-CU-G-4	GUIDANCE OFFICE B19-1	1-FCU-B-9	1	TPFFYP006CS140A	Floor-Standing Type (Exposed)	6,000	6,700	80.0/67.0	70	PARTIAL DEMAND	FULL DEMAND	6,009.1	4,993.4	6,267.7	59.4	95.4	1/4 / 1/2	HIGH	229		208/230V/1-phase	0.061	0.061	0.32/0.34/15	0.11	See Below	
1-CU-G-4	PASSAGE B20-1	1-FCU-B-10	2	TPLFYP005FM140B	Ceiling-Cassette (Four-Way)	5,000	5,600	80.0/67.0	70	PARTIAL DEMAND	FULL DEMAND	5,007.6	4,386.2	5,238.7	65.2	87.3	1/4 / 1/2	HIGH	280		208/230V/1-phase	0.02	0.02	0.24/0.24/15	0.09	See Below	
1-CU-G-4	GUIDANCE OFFICE B21-1	1-FCU-B-11	3	TPFFYP006CS140A	Floor-Standing Type (Exposed)	6,000	6,700	80.0/67.0	70	PARTIAL DEMAND	FULL DEMAND	6,009.1	4,993.4	6,267.7	59.4	95.4	1/4 / 1/2	HIGH	229		208/230V/1-phase	0.061	0.061	0.32/0.34/15	0.11	See Below	
1-CU-G-4	STORAGE B18-1	1-FCU-B-12	4	TPFFYP006CS140A	Floor-Standing Type (Exposed)	6,000	6,700	80.0/67.0	70	PARTIAL DEMAND	FULL DEMAND	6,009.1	4,993.4	6,267.7	59.4	95.4	1/4 / 1/2	HIGH	229		208/230V/1-phase	0.061	0.061	0.32/0.34/15	0.11	See Below	
1-CU-G-4	GUIDANCE OFFICE B22-1	1-FCU-B-13	5	TPFFYP006CS140A	Floor-Standing Type (Exposed)	6,000	6,700	80.0/67.0	70	PARTIAL DEMAND	FULL DEMAND	6,009.1	4,993.4	6,267.7	59.4	95.4	1/4 / 1/2	HIGH	229		208/230V/1-phase	0.061	0.061	0.32/0.34/15	0.11	See Below	
1-CU-G-4	COPY/WORKROOM B17-1	1-FCU-B-14	6	TPFFYP006CS140A	Floor-Standing Type (Exposed)	6,000	6,700	80.0/67.0	70	PARTIAL DEMAND	FULL DEMAND	6,009.1	4,993.4	6,267.7	59.4	95.4	1/4 / 1/2	HIGH	229		208/230V/1-phase	0.061	0.061	0.32/0.34/15	0.11	See Below	
1-CU-G-4	ADMIN/CHECK-IN B23-1	1-FCU-B-15	7	TPFFYP006CS140A	Floor-Standing Type (Exposed)	6,000	6,700	80.0/67.0	70	PARTIAL DEMAND	FULL DEMAND	6,009.1	4,993.4	6,267.7	59.4	95.4	1/4 / 1/2	HIGH	229		208/230V/1-phase	0.061	0.061	0.32/0.34/15	0.11	See Below	
1-CU-G-4	WAITING B24-1	1-FCU-B-16	8	TPFFYP006CS140A	Floor-Standing Type (Exposed)	6,000	6,700	80.0/67.0	70	PARTIAL DEMAND	FULL DEMAND	6,009.1	4,993.4	6,267.7	59.4	95.4	1/4 / 1/2	HIGH	229		208/230V/1-phase	0.061	0.061	0.32/0.34/15	0.11	See Below	
1-CU-G-4	LOCKER ROOM B32-1	1-FCU-B-17	9	TPFFYP006CS140A	Floor-Standing Type (Exposed)	6,000	6,700	80.0/67.0	70	PARTIAL DEMAND	FULL DEMAND	6,009.1	4,993.4	6,267.7	59.4	95.4	1/4 / 1/2	HIGH	229		208/230V/1-phase	0.061	0.061	0.32/0.34/15	0.11	See Below	
1-CU-G-4	CONFERENCE B26-1	1-FCU-B-18	10	TPLFYP006EM142A	Ceiling-Cassette (Four-Way)	6,000	6,700	80.0/67.0	70	PARTIAL DEMAND	FULL DEMAND	6,009.1	5,090.0	6,267.7	70.3	81.8	1/4 / 1/2	HIGH	494		208/230V/1-phase	0.02	0.02	0.24/0.19/15	0.06	See Below	
1-CU-G-4	PSYCHOLOGIST OFFICE B30-1	1-FCU-B-19	11	TPFFYP006CS140A	Floor-Standing Type (Exposed)	8,000	9,000	80.0/67.0	70	PARTIAL DEMAND	FULL DEMAND	8,012.2	5,791.5	8,419.3	56.2	103.9	1/4 / 1/2	HIGH	230		208/230V/1-phase	0.061	0.061	0.32/0.34/15	0.27	See Below	
1-CU-G-4	RESTORATIVE CIRCLE B29-1	1-FCU-B-20	12	TPFFYP006CS140A	Floor-Standing Type (Exposed)	6,000	6,700	80.0/67.0	70	PARTIAL DEMAND	FULL DEMAND	6,009.1	4,993.4	6,267.7	59.4	95.4	1/4 / 1/2	HIGH	229		208/230V/1-phase	0.061	0.061	0.32/0.34/15	0.11	See Below	
1-CU-G-4	SOCIAL WORKER OFFICE B27-1	1-FCU-B-21	13	TPFFYP006CS140A	Floor-Standing Type (Exposed)	8,000	9,000	80.0/67.0	70	PARTIAL DEMAND	FULL DEMAND	8,012.2	5,791.5	8,419.3	56.2	103.9	1/4 / 1/2	HIGH	230		208/230V/1-phase	0.061	0.061	0.32/0.34/15	0.27	See Below	
1-CU-G-4	STORAGE 119-1	1-FCU-1-13	14	TPFFYP006CS140A	Floor-Standing Type (Exposed)	6,000	6,700	80.0/67.0	70	PARTIAL DEMAND	FULL DEMAND	6,009.1	4,993.4	6,267.7	59.4	95.4	1/4 / 1/2	HIGH	229		208/230V/1-phase	0.061	0.061	0.32/0.34/15	0.11	See Below	
1-CU-G-4	STORAGE 118-1	1-FCU-1-14	15	TPFFYP006CS140A	Floor-Standing Type (Exposed)	6,000	6,700	80.0/67.0	70	PARTIAL DEMAND	FULL DEMAND	6,009.1	4,993.4	6,267.7	59.4	95.4	1/4 / 1/2	HIGH	229		208/230V/1-phase	0.061	0.061	0.32/0.34/15	0.11	See Below	
1-CU-G-4	STAFF BREAK ROOM B14-1	1-FCU-B-6	16	TPKFYP008LM140B	Wall -Mounted	8,000	9,000	80.0/67.0	70	PARTIAL DEMAND	FULL DEMAND	8,012.2	5,570.9	8,419.3	57.8	102.9	1/4 / 1/2	HIGH	237		208/230V/1-phase	0.03	0.02	0.24/0.24/15	0.38	See Below	
1-CU-G-4	INNOVATION LAB B13-1	1-FCU-B-5A	19	TPKFYP008LM140B	Wall -Mounted	6,000	6,700	80.0/67.0	70	PARTIAL DEMAND	FULL DEMAND	6,009.1	4,257.7	6,267.7	58.9	100.4	1/4 / 1/2	HIGH	191		208/230V/1-phase	0.02	0.01	0.24/0.24/15	0.26	See Below	
1-CU-G-4	INNOVATION LAB B13-1	1-FCU-B-5B	20	TPKFYP008LM140B	Wall -Mounted	6,000	6,700	80.0/67.0	70	PARTIAL DEMAND	FULL DEMAND	6,009.1	4,257.7	6,267.7	58.9	100.4	1/4 / 1/2	HIGH	191		208/230V/1-phase	0.02	0.01	0.24/0.24/15	0.26	See Below	
1-CU-G-4	ASSISTANT PRINCIPAL 116-1	1-FCU-1-5	17	TPLFYP006EM142A	Ceiling-Cassette (Four-Way)	6,000	6,700	80.0/67.0	70	PARTIAL DEMAND	FULL DEMAND	6,009.1	5,090.0	6,267.7	70.3	81.8	1/4 / 1/2	HIGH	494		208/230V/1-phase	0.02	0.02	0.24/0.19/15	0.06	See Below	
1-CU-G-4	PRINCIPAL 115-1	1-FCU-1-4	18	TPFFYP006CS140A	Floor-Standing Type (Exposed)	6,000	6,700	80.0/67.0	70	PARTIAL DEMAND	FULL DEMAND	6,009.1	4,993.4	6,267.7	59.4	95.4	1/4 / 1/2	HIGH	229		208/230V/1-phase	0.061	0.061	0.32/0.34/15	0.11	See Below	
1-CU-G-4	DRAWING ROOM 114-1	1-FCU-1-3A	21	TPFFYP006RE140A	Floor-Standing Type (Concealed)	6,000	6,700	80.0/67.0	70	PARTIAL DEMAND	FULL DEMAND	6,009.1	4,993.4	6,267.7	59.4	95.4	1/4 / 1/2	HIGH	229		208/230V/1-phase	0.061	0.061	0.32/0.34/15	0.11	See Below	
1-CU-G-4	DRAWING ROOM 114-1	1-FCU-1-3B	22	TPFFYP006RE140A	Floor-Standing Type (Concealed)	6,000	6,700	80.0/67.0	70	PARTIAL DEMAND	FULL DEMAND	6,009.1	4,993.4	6,267.7	59.4	95.4	1/4 / 1/2	HIGH	229		208/230V/1-phase	0.061	0.061	0.32/0.34/15	0.11	See Below	
1-CU-G-4	LIBRARY 113-1	1-FCU-1-2A	23	TPFFYP006RE140A	Floor-Standing Type (Concealed)	6,000	6,700	80.0/67.0	70	PARTIAL DEMAND	FULL DEMAND	6,009.1	4,993.4	6,267.7	59.4	95.4	1/4 / 1/2	HIGH	229		208/230V/1-phase	0.061	0.061	0.32/0.34/15	0.11	See Below	
1-CU-G-4	LIBRARY 113-1	1-FCU-1-2B	24	TPFFYP006RE140A	Floor-Standing Type (Concealed)	6,000	6,700	80.0/67.0	70	PARTIAL DEMAND	FULL DEMAND	6,009.1	4,993.4	6,267.7	59.4	95.4	1/4 / 1/2	HIGH	229		208/230V/1-phase	0.061	0.061	0.32/0.34/15	0.11	See Below	
1-CU-G-3	STORAGE B01-1	1-FCU-B-4	25	PKA-AL18NL	Wall -Mounted	18,000	23,600	80.0/67.0	70	PARTIAL DEMAND	FULL DEMAND	17,545.1	11,037.9	12,290.2	56.8	95.3	1/4 / 1/2	HIGH	450		208/230V/1-phase				Powered by Outdoor	0.39	See Below
1-CU-G-1	SPEC ED RM B09-1	FCU-B-1	26	MFZ-KX09NL	Floor-Standing Type (Exposed)	9,000	12,000	80.0/67.0	70	PARTIAL DEMAND	FULL DEMAND	9,365.0	8,773.3	9,510.8	60.1	83.1	3/8 / 1/4	HIGH	417		208/230V/1-phase				Powered by Outdoor	0.04	See Below
1-CU-G-2	SPEC ED RM B10-1	FCU-B-2	27	MFZ-KX09NL	Floor-Standing Type (Exposed)	9,000	12,000	80.0/67.0	70	PARTIAL DEMAND	FULL DEMAND	9,365.0	8,773.3	9,510.8	60.1	83.1	3/8 / 1/4	HIGH	417		208/230V/1-phase				Powered by Outdoor	0.04	See Below
1-CU-R-1	DINING ROOM 112-1	1-FCU-1-1A	1	TPFEFYP018MA145 A	Ceiling-Concealed (Ducted)	18,000	20,000	80.0/67.0	70	PARTIAL DEMAND	FULL DEMAND	18,024.1	16,965.4	19,865.6	61.9	90.9	1/4 / 1/2	HIGH	883	0.6/0.6	208/230V/1-phase	0.082	0.14	2.88/15	0.11	See Below	
1-CU-R-1	DINING ROOM 112-1	1-FCU-1-1B	2	TPFEFYP018MA145 A	Ceiling-Concealed (Ducted)	18,000	20,000	80.0/67.0	70	PARTIAL DEMAND	FULL DEMAND	18,024.1	16,965.4	19,865.6	61.9	90.9	1/4 / 1/2	HIGH	883	0.6/0.6	208/230V/1-phase	0.082	0.14	2.88/15	0.11	See Below	
1-CU-R-1	DINING ROOM 112-1	1-FCU-1-1C	3	TPLFYP015EM142A	Ceiling-Cassette (Four-Way)	15,000	17,000	80.0/67.0	70	PARTIAL DEMAND	FULL DEMAND	15,020.1	11,365.1	16,885.7	62.1	96.1	1/4 / 1/2	HIGH	600		208/230V/1-phase	0.03	0.02	0.39/0.39/15	0.42	See Below	
1-CU-R-1	DINING ROOM 112-1	1-FCU-1-1D	4	TPLFYP015EM142A	Ceiling-Cassette (Four-Way)	15,000	17,000	80.0/67.0	70	PARTIAL DEMAND	FULL DEMAND	15,020.1	11,365.1	16,885.7	62.1	96.1	1/4 / 1/2	HIGH	600		208/230V/1-phase	0.03	0.02	0.39/0.39/15	0.42	See Below	
1-CU-R-1	DINING ROOM 112-1	1-FCU-1-1E	5	TPLFYP015EM142A	Ceiling-Cassette (Four-Way)	15,000	17,000	80.0/67.0	70	PARTIAL DEMAND	FULL DEMAND	15,020.1	11,365.1	16,885.7	62.1	96.1	1/4 / 1/2	HIGH	600		208/230V/1-phase	0.03	0.02	0.39/0.39/15	0.42	See Below	
1-CU-R-1	DINING ROOM 112-1	1-FCU-1-1F	6	TPLFYP015EM142A	Ceiling-Cassette (Four-Way)	15,000	17,000	80.0/67.0	70	PARTIAL DEMAND	FULL DEMAND	15,020.1	11,365.1	16,885.7	62.1	96.1	1/4 / 1/2	HIGH	600		208/230V/1-phase	0.03	0.02	0.39/0.39/15	0.42	See Below	
1-CU-G-5	ASSEMBLY/DINING 117-1	1-FCU-1-11A	7	TPFFYP012CS140A	Floor-Standing Type (Exposed)	12,000	13,500	80.0/67.0	70	PARTIAL DEMAND	FULL DEMAND	12,016.1	8,083.5	13,483.2	56.0	109.3	1/4 / 1/2	HIGH	318		208/230V/1-phase	0.067	0.067	0.34/0.38/15	0.48	See Below	
1-CU-G-5	ASSEMBLY/DINING 117-1	1-FCU-1-11B	8	TPFFYP012CS140A	Floor-Standing Type (Exposed)	12,000	13,500	80.0/67.0	70	PARTIAL DEMAND	FULL DEMAND	12,016.1	8,083.5	13,483.2	56.0	109.3	1/4 / 1/2	HIGH	318		208/230V/1-phase	0.067	0.067	0.34/0.38/15	0.48	See Below	
1-CU-G-5	ASSEMBLY/DINING 117-1	1-FCU-1-11C	9	TPFFYP012CS140A	Floor-Standing Type (Exposed)	12,000	13,500	80.0/67.0	70	PARTIAL DEMAND	FULL DEMAND	12,016.1	8,083.5	13,483.2	56.0	109.3	1/4 / 1/2	HIGH	318		208/230V/1-phase	0.067	0.067	0.34/0.38/15	0.48	See Below	
1-CU-G-5	ASSEMBLY/DINING 117-1	1-FCU-1-11D	10	TPFFYP012CS140A	Floor-Standing Type (Exposed)	12,000	13,500	80.0/67.0	70	PARTIAL DEMAND	FULL DEMAND	12,016.1	8,083.5	13,483.2	56.0	109.3	1/4 / 1/2	HIGH	318		208/230V/1-phase	0.067	0.067	0.34/0.38/15	0.48	See Below	
1-CU-G-5	ASSEMBLY/DINING 117-1	1-FCU-1-11E	11	TPFFYP012CS140A	Floor-Standing Type (Exposed)	12,000	13,500	80.0/67.0	70	PARTIAL DEMAND	FULL DEMAND	12,016.1	8,083.5	13,483.2	56.0	109.3	1/4 / 1/2	HIGH	318		208/230V/1-phase	0.067	0.067	0.34/0.38/15	0.48	See Below	
1-CU-G-5	ASSEMBLY/DINING 117-1	1-FCU-1-11F	12	TPFFYP012CS140A	Floor-Standing Type (Exposed)	12,000	13,500	80.0/67.0	70	PARTIAL DEMAND	FULL DEMAND	12,016.1	8,083.5	13,483.2	56.0	109.3	1/4 / 1/2	HIGH	318		208/230V/1-phase	0.067	0.067	0.34/0.38/15	0.48	See Below	
1-CU-G-5	ASSEMBLY/DINING 117-1	1-FCU-1-11G	13	TPFFYP012CS140A	Floor-Standing Type (Exposed)	12,000	13,500	80.0/67.0	70	PARTIAL DEMAND	FULL DEMAND	12,016.1	8,083.5	13,483.2	56.0	109.3	1/4 / 1/2	HIGH	318		208/230V/1-phase	0.067	0.067	0.34/0.38/15	0.48	See Below	
1-CU-R-2	MEETING ROOM 107-1	1-FCU-1-7	14	TPLFYP008EM142A	Ceiling-Cassette (Four-Way)	8,000	9,000	80.0/67.0	70	PARTIAL DEMAND	FULL DEMAND	8,010.7	6,452.3	8,989.3	69.8</												

GENERAL POWER NOTES

- 1 REFER TO DRAWING E001-1 FOR ELECTRICAL SYMBOLS AND ABBREVIATIONS.
- 2 ALL NEW RECEPTACLES SHALL BE TAMPER-PROOF TYPE PER NEC 406.12 UNLESS LOCATED MORE THAN 5'-6" ABOVE THE FLOOR OR SERVE A DEDICATED PIECE OF EQUIPMENT THAT CAN NOT BE EASILY MOVED TO EXPOSE THE PLUG.
- 3 ALL DEVICES (RECEPTACLES, FIRE ALARM, CALL FOR AID, ETC.), AND ELECTRICAL EQUIPMENT (PANELBOARDS, DISCONNECT SWITCHES, ETC.) SHOWN DARK AND SOLID ARE TO BE NEW UNLESS OTHERWISE NOTED. ALL DEVICES AND EQUIPMENT SHOWN HALF-TONE (LIGHT) AND SOLID ARE EXISTING TO REMAIN UNLESS OTHERWISE NOTED.

POWER KEY NOTES

- 1 ALL DEVICES WHICH ARE MOUNTED ON EXISTING WALLS SHALL BE SURFACE MOUNTED DEVICES. THE RACEWAY SERVING THESE SPACES SHALL BE WIREMOLD PAINTED TO MATCH THE WALL. THE RACEWAY SHALL COME FROM THE CEILING & CONNECT ALL DEVICES SHOWN ON THE CIRCUIT. EXPOSED CONDUIT IN FINISHED SPACES IS NOT ACCEPTABLE. COORDINATE WIRETECHNOLOGY TO INCLUDE DATAVOICE JACKS IN WIREMOLD WHERE NECESSARY.
- 2 EQUIPMENT SHOWN IS CONTROLLED VIA THE BUILDING MANAGEMENT SYSTEM. PROVIDE ALL NECESSARY WIRING BETWEEN THE CONTROLLER, EQUIPMENT, RELAYS, ETC. COORDINATE LOCATION OF POWER FOR EQUIPMENT SHOWN W/ASSOCIATED CONTRACTORS OF OTHER DISCIPLINES.
- 3 PROVIDE & INSTALL NEMA 1, 60A, 208V, 3 PHASE, SHUNT-TRIP FUSIBLE DISCONNECT SWITCH WITH AUXILIARY CONTACTS TO BE WIRED TO ELEVATOR BATTERY BACKUP. DISCONNECT SWITCH SHALL CONTAIN 40A FUSES. PROVIDE & INSTALL NEMA 1, 30A, 120V, SINGLE PHASE, FUSED DISCONNECT SWITCH W/40A FUSE FOR CAB LIGHTING POWER.
- 4 DUCT SMOKE DETECTORS FOR RTUS. PROVIDE & INSTALL 1 FOR SUPPLY & 1 FOR RETURN. DETECTOR SHALL BE COORDINATE W/MECH. COORDINATE EXACT LOCATIONS IN FIELD.
- 5 POWER TO DAMPER SHALL COME FROM NEARBY AREA RECEPTACLE CIRCUIT. PROVIDE DUCT SMOKE & FIRE ALARM RELAY. WIRING OF DAMPER SHALL CLOSE ON DETECTION OF SMOKE & DETECTOR/RELAYS SHALL BE WIRED TO FIRE ALARM SYSTEM. COORDINATE W/CONTRACTOR.
- 6 INSTALL NEW SURFACE MOUNTED BOX EXTENSION WIRECEPTACLE TO EXISTING BACK BOX OF RECEPTACLE WHICH WAS REMOVED. INSTALL WIREMOLD TO INTERCONNECT THE DEVICES ON THE CIRCUIT SHOWN. COORDINATE WIRETECHNOLOGY TO INCLUDE DATAVOICE JACKS IN WIREMOLD WHERE NECESSARY.
- 7 EXISTING SURFACE MOUNTED RECEPTACLE. INSTALL WIREMOLD FROM DEVICE TO ACCESSIBLE CEILING SPACE IF POSSIBLE. OR TO NEXT DEVICE/FIXTURE IN THE CIRCUIT AS SHOWN. COORDINATE WIRETECHNOLOGY TO INCLUDE DATAVOICE JACKS IN WIREMOLD WHERE NECESSARY.
- 8 INSTALL NEW SURFACE MOUNTED BOX EXTENSION WIRE FIRE ALARM DEVICE TO EXISTING BACK BOX OF FIRE ALARM DEVICE WHICH WAS REMOVED. INSTALL WIREMOLD TO ACCESSIBLE CEILING SPACE TO INTERCONNECT DEVICE TO FIRE ALARM LOOP FOR THE AREA.
- 9 INSTALL NEW SURFACE MOUNTED FIRE ALARM DEVICE IN SAME LOCATION AS DEVICE WHICH WAS REMOVED. REUSE EXISTING RACEWAY TO FISH WIRES TO DEVICE FROM NEARBY FIRE ALARM LOOP. EXTEND RACEWAY AS NECESSARY TO REACH ACCESSIBLE CEILING SPACE.
- 10 INDOOR UNIT SHOWN IS POWERED BY THE OUTDOOR CONDENSING UNIT. WIRE UNIT TO THE ASSOCIATED CONDENSING UNIT. REFER TO MANUFACTURER'S INSTRUCTIONS FOR INSTALLATION.
- 11 POWER FOR HEAT TRACE FOR FREEZER/COOLER CONDENSATE LINE. COORDINATE LOCATION OF CONTROLLER W/PLUMBING CONTRACTOR. CIRCUIT BREAKER SERVING HEAT TRACE SHALL BE GFCI.
- 12 FAN COIL UNITS SHOWN WILL HAVE A HARD WIRED INTERNAL CONDENSATE PUMP. PROVIDE WIRING FOR PUMP. COORDINATE W/MECHANICAL CONTRACTOR.
- 13 VRF HEAT RECOVERY BRANCH CIRCUIT CONTROLLER SHOWN WILL HAVE A HARD WIRED INTERNAL CONDENSATE PUMP. PROVIDE WIRING FOR PUMP. COORDINATE W/MECHANICAL CONTRACTOR.
- 14 PROPOSED CONDUIT PATH FOR FLOOR BOX. FLOOR MUST BE TRENCHED TO LOCATIONS SHOWN. COORDINATE W/ARCHITECTURAL DRAWINGS. ALL PATHWAYS MUST BE CONCEALED.
- 15 FURNISH AND INSTALL ELECTRICAL LIGHTING INVERTER PANEL. REFER TO ONE-LINE DIAGRAM DRAWING E300-1 AND PANEL SCHEDULE ON E300 SERIES DRAWINGS FOR NEW WORK REQUIREMENTS.
- 16 FURNISH AND INSTALL ELECTRICAL PANEL. REFER TO ONE-LINE DIAGRAM DRAWING E300-1 AND PANEL SCHEDULE ON E300 SERIES DRAWINGS FOR NEW WORK REQUIREMENTS.
- 17 FURNISH AND INSTALL ELECTRICAL EQUIPMENT. REFER TO ONE-LINE DIAGRAM DRAWING E300-1 FOR NEW WORK REQUIREMENTS.
- 18 CONDENSATE PUMP FOR BOCS & WALL MOUNTED FCU'S NEED WIRING/POWER PROVIDED TO THEM. CONDENSATE PUMP POWER SHALL COME FROM THE UNIT IT IS SERVING. DISCONNECT SWITCH WIRING SHALL BE CONNECTED TO THE UNIT SAFETY CONNECTORS. WIRING SHALL BE FIELD SUPPLIED & SHALL BE IN ACCORDANCE W/MANUFACTURER'S REQUIREMENTS. REFER TO MECHANICAL DRAWINGS FOR MORE INFORMATION.

3 MER B01.1 PART PLAN

1/4" = 1'-0"

2 CRAWL SPACE POWER PLAN

1/8" = 1'-0"

1 BASEMENT POWER PLAN

1/8" = 1'-0"

ALTERATIONS TO:  
ACES at Chase  
565 Chase Parkway  
Waterbury, Connecticut 06708



SILVER PETRUCCELLI + ASSOCIATES

3190 WHITNEY AVENUE HAMDEN CT 06518  
311 STATE STREET NEW LONDON CT 06320  
203 230 9007 silverpetrucci.com

Revision:	Description:	Date:	Revised By:
1	Bulletin #1	12/16/25	MTC

Drawing Title:  
**BUILDING 1 - BASEMENT LEVEL  
POWER PLAN**  
Project Phase:  
**ISSUED FOR BID - 11/03/2025**  
State Project Number:  
**#244-0044 MAG**

Date:  
AUGUST 12, 2025  
Scale:  
As indicated  
Drawn By:  
MTC  
Project Number:  
22,650

E200-1

12/16/2025 10:11:18 AM




GENERAL POWER NOTES

- REFER TO DRAWING E001-1 FOR ELECTRICAL SYMBOLS AND ABBREVIATIONS.
- ALL NEW RECEPTACLES SHALL BE TAMPER-PROOF TYPE PER NEC 406.12 UNLESS LOCATED MORE THAN 5'-6" ABOVE THE FLOOR OR SERVE A DEDICATED PIECE OF EQUIPMENT THAT CAN NOT BE EASILY MOVED TO EXPOSE THE PLUG.
- ALL DEVICES (RECEPTACLES, FIRE ALARM, CALL FOR AID, ETC.), AND ELECTRICAL EQUIPMENT (PANELBOARDS, DISCONNECT SWITCHES, ETC.) SHOWN DARK AND SOLID ARE TO BE NEW UNLESS OTHERWISE NOTED. ALL DEVICES AND EQUIPMENT SHOWN HALF TONE (LIGHT) AND SOLID ARE EXISTING TO REMAIN UNLESS OTHERWISE NOTED.

POWER KEY NOTES

- ALL NEW DEVICES WHICH ARE MOUNTED ON EXISTING WALLS SHALL BE SURFACE MOUNTED DEVICES. THE RACEWAY SERVING THESE SPACES SHALL BE WIREMOLD PAINTED TO MATCH THE WALL. THE RACEWAY SHALL COME FROM THE CEILING & CONNECT ALL DEVICES SHOWN ON THE CIRCUIT. EXPOSED CONDUIT IN FINISHED SPACES IS NOT ACCEPTABLE. COORDINATE W/TECHNOLOGY TO INCLUDE DATA/VOICE JACKS IN WIREMOLD WHERE NECESSARY.
- EQUIPMENT SHOWN IS CONTROLLED VIA THE BUILDING MANAGEMENT SYSTEM. PROVIDE ALL NECESSARY WIRING BETWEEN THE CONTROLLER, EQUIPMENT, RELAYS, ETC. COORDINATE LOCATION OF POWER FOR EQUIPMENT SHOWN W/ASSOCIATED CONTRACTORS OF OTHER DISCIPLINES.
- ALL EQUIPMENT & CIRCUITS IN KITCHEN ARE TO BE GFCI PROTECTED. IF THEY ARE NOT PROTECTED BY A GFCI RECEPTACLE THEY MUST BE PROTECTED BY A GFCI CIRCUIT BREAKER.
- POWER TO DAMPER SHALL COME FROM NEARBY AREA RECEPTACLE CIRCUIT. PROVIDE DUCT SMOKE & FIRE ALARM RELAY. WIRING OF DAMPER SHALL CLOSE ON DETECTION OF SMOKE & DETECTORS/RELAYS SHALL BE WIRED TO FIRE ALARM SYSTEM. COORDINATE W/CONTRACTOR.
- INSTALL NEW SURFACE MOUNTED BOX EXTENSION WIRECEPTACLE TO EXISTING BACK BOX OF RECEPTACLE WHICH WAS REMOVED. INSTALL WIREMOLD TO INTERCONNECT THE DEVICES ON THE CIRCUIT SHOWN. COORDINATE W/TECHNOLOGY TO INCLUDE DATA/VOICE JACKS IN WIREMOLD WHERE NECESSARY.
- EXISTING SURFACE MOUNTED RECEPTACLE. INSTALL WIREMOLD FROM DEVICE TO ACCESSIBLE CEILING SPACE IF POSSIBLE. OR TO NEXT DEVICE/FIXTURE IN THE CIRCUIT AS SHOWN. COORDINATE W/TECHNOLOGY TO INCLUDE DATA/VOICE JACKS IN WIREMOLD WHERE NECESSARY.
- INSTALL NEW SURFACE MOUNTED BOX EXTENSION WIRE ALARM DEVICE TO EXISTING BACK BOX OF FIRE ALARM DEVICE WHICH WAS REMOVED. INSTALL WIREMOLD TO ACCESSIBLE CEILING SPACE TO INTERCONNECT DEVICE TO FIRE ALARM LOOP FOR THE AREA.
- INSTALL NEW SURFACE MOUNTED FIRE ALARM DEVICE IN SAME LOCATION AS DEVICE WHICH WAS REMOVED. REUSE EXISTING RACEWAY TO FISH WIRES TO DEVICE FROM NEARBY FIRE ALARM LOOP. EXTEND RACEWAY AS NECESSARY TO REACH ACCESSIBLE CEILING SPACE.
- FISH WIRE TO EXISTING RECEPTACLES IN AREAS SHOWN. WIRE RECEPTACLES TO CIRCUITS AS SHOWN.
- INDOOR UNIT SHOWN IS POWERED BY THE OUTDOOR CONDENSING UNIT. WIRE UNIT TO THE ASSOCIATED CONDENSING UNIT. REFER TO MANUFACTURERS INSTRUCTIONS FOR INSTALLATION.
- VRF HEAT RECOVERY BRANCH CIRCUIT CONTROLLER SHOWN WILL HAVE A HARD WIRED INTERNAL CONDENSATE PUMP. PROVIDE WIRING FOR PUMP. COORDINATE W/MECHANICAL CONTRACTOR.
- EXISTING ELECTRICAL PANEL. REFER TO ONE-LINE DIAGRAM DRAWING E300-1 AND PANEL SCHEDULE ON E500 SERIES DRAWINGS FOR NEW WORK REQUIREMENTS.
- FURNISH AND INSTALL ELECTRICAL PANEL. REFER TO ONE-LINE DIAGRAM DRAWING E300-1 AND PANEL SCHEDULE ON E500 SERIES DRAWINGS FOR NEW WORK REQUIREMENTS.
- INSTALL NEW POWERED DOOR OPENERS AT THE DOOR SHOWN. INSTALL A TOGGLE DISCONNECT SWITCH AT THE MOTOR. INSTALL PUSH PLATE DOOR OPERATORS AT THE LOCATIONS SHOWN. COORDINATE W/ARCHITECT FOR EXACT LOCATIONS. PROVIDE ALL WIRING, CONDUIT, EQUIPMENT NECESSARY FOR A COMPLETE & WORKING INSTALLATION. ANY DEVICES WHICH ARE MOUNTED ON AN EXISTING WALL OR MULLION SHALL HAVE WIREMOLD PAINTED THE SAME COLOR AS THE WALL OR MULLION IF IT IS INSTALLED ON. POWER FOR CIRCUIT IS ASSUMED FOR A 1/2 HP MOTOR. IF THE MOTOR IS LARGER THE CIRCUIT BREAKER SERVING IT WILL NEED TO BE INCREASED, AS WELL AS THE WIRE SIZE.
- CONDENSATE PUMP FOR BCC'S & WALL MOUNTED FCU'S NEED WIRING/POWER PROVIDED TO THEM. CONDENSATE PUMP POWER SHALL COME FROM THE UNIT IT IS SERVING. DISCONNECT SWITCH WIRING SHALL BE CONNECTED TO THE UNIT SAFETY CONNECTORS. WIRING SHALL BE FIELD SUPPLIED & SHALL BE IN ACCORDANCE W/MANUFACTURER'S REQUIREMENTS. REFER TO MECHANICAL DRAWINGS FOR MORE INFORMATION.

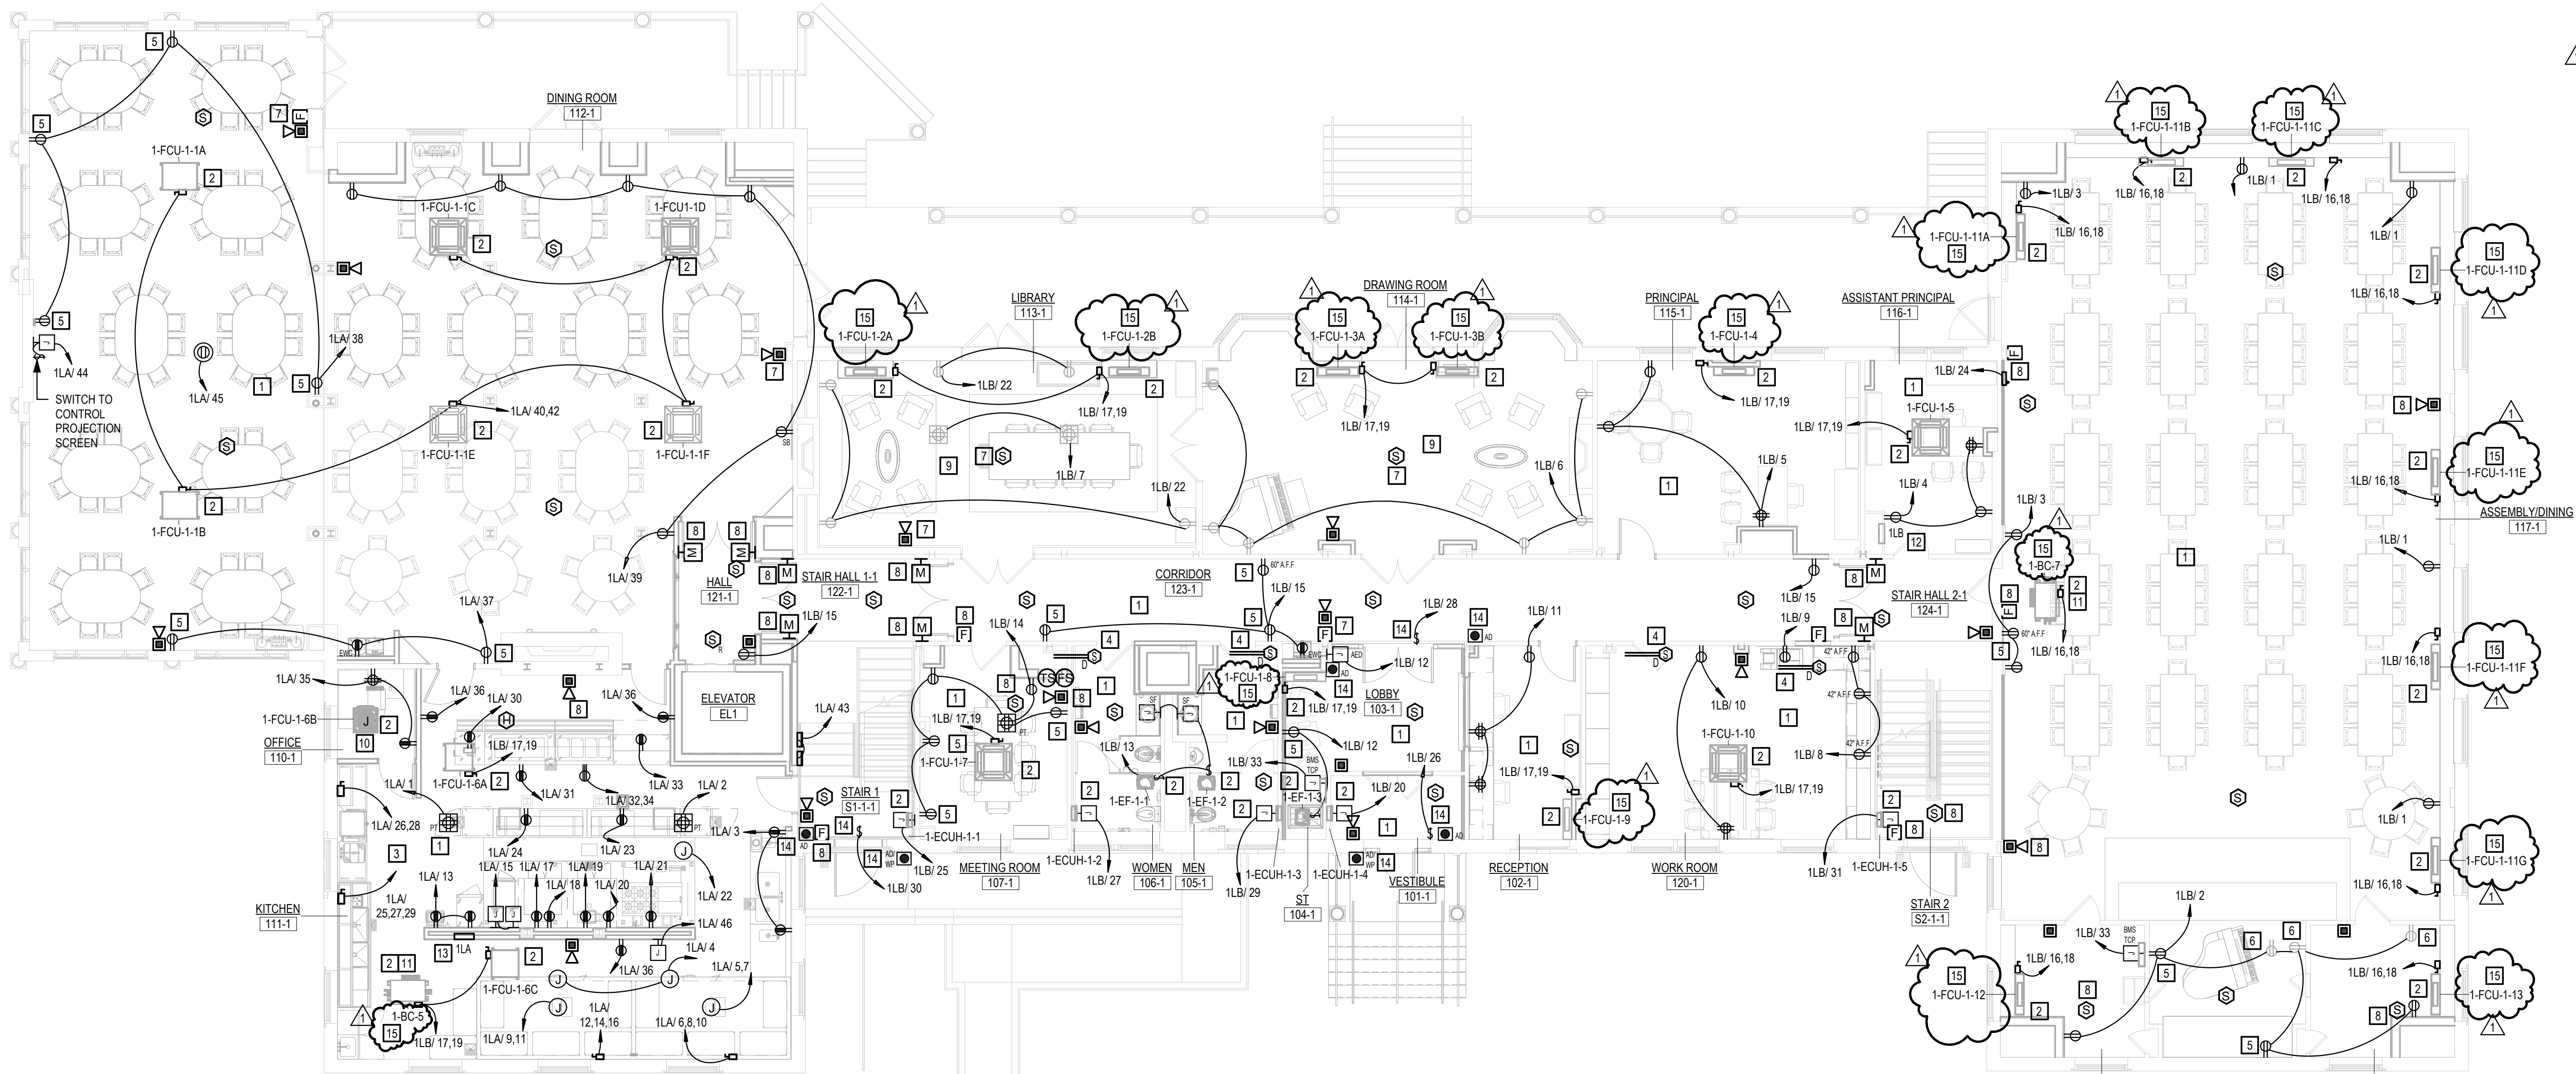

1 FIRST FLOOR POWER PLAN  
1/8" = 1'-0"

KEY PLAN  
SCALE: NTS

ALTERATIONS TO:  
ACES at Chase  
565 Chase Parkway  
Waterbury, Connecticut 06708



SILVER PETRUCCELLI + ASSOCIATES  
3190 WHITNEY AVENUE HAMDEN CT 06518  
311 STATE STREET NEW LONDON CT 06320  
203 230 9007 silverpetrucci.com

Revision:	Description:	Date:	Revised By:
1	Bulletin #1	12/16/25	MTC

Drawing Title:  
BUILDING 1 - MAIN LEVEL POWER PLAN  
Project Phase:  
ISSUED FOR BID - 11/03/2025  
State Project Number:  
#244-0044 MAG

Date:  
AUGUST 12, 2025  
Scale:  
As indicated  
Drawn By:  
MTC  
Project Number:  
22.050

E210-1


12/16/2025 10:11:26 AM

GENERAL POWER NOTES

- REFER TO DRAWING E001-1 FOR ELECTRICAL SYMBOLS AND ABBREVIATIONS.
- ALL NEW RECEPTACLES SHALL BE TAMPER-PROOF TYPE PER NEC 406.12 UNLESS LOCATED MORE THAN 5'-6" ABOVE THE FLOOR OR SERVE A DEDICATED PIECE OF EQUIPMENT THAT CAN NOT BE EASILY MOVED TO EXPOSE THE PLUG.
- ALL DEVICES (RECEPTACLES, FIRE ALARM, CALL FOR AID, ETC.), AND ELECTRICAL EQUIPMENT (PANELBOARDS, DISCONNECT SWITCHES, ETC.) SHOWN DARK AND SOLID ARE TO BE NEW UNLESS OTHERWISE NOTED. ALL DEVICES AND EQUIPMENT SHOWN HALF TONE (LIGHT) AND SOLID ARE EXISTING TO REMAIN UNLESS OTHERWISE NOTED.

POWER KEY NOTES

- ALL DEVICES WHICH ARE MOUNTED ON EXISTING WALLS SHALL BE SURFACE MOUNTED DEVICES. THE RACEWAY SERVING THESE SPACES SHALL BE WIREMOLD PAINTED TO MATCH THE WALL. THE RACEWAY SHALL COME FROM THE CEILING & CONNECT ALL DEVICES SHOWN ON THE CIRCUIT. EXPOSED CONDUIT IN FINISHED SPACES IS NOT ACCEPTABLE. COORDINATE W/TECHNOLOGY TO INCLUDE DATA/VOICE JACKS IN WIREMOLD WHERE NECESSARY.
- EQUIPMENT SHOWN IS CONTROLLED VIA THE BUILDING MANAGEMENT SYSTEM. PROVIDE ALL NECESSARY WIRING BETWEEN THE CONTROLLER, EQUIPMENT, RELAYS, ETC. COORDINATE LOCATION OF POWER FOR EQUIPMENT SHOWN W/ASSOCIATED CONTRACTORS OF OTHER DISCIPLINES.
- POWER TO DAMPER SHALL COME FROM NEARBY AREA RECEPTACLE CIRCUIT. PROVIDE DUCT SMOKE & FIRE ALARM RELAY. WIRING OF DAMPER SHALL CLOSE ON DETECTION OF SMOKE & DETECTORS/RELAYS SHALL BE WIRED TO FIRE ALARM SYSTEM. COORDINATE W/CONTRACTOR.
- INSTALL NEW SURFACE MOUNTED BOX EXTENSION WIRECEPTACLE TO EXISTING BACK BOX OF RECEPTACLE WHICH WAS REMOVED. INSTALL WIREMOLD TO INTERCONNECT THE DEVICES ON THE CIRCUIT SHOWN. COORDINATE W/TECHNOLOGY TO INCLUDE DATA/VOICE JACKS IN WIREMOLD WHERE NECESSARY.
- EXISTING SURFACE MOUNTED RECEPTACLE. INSTALL WIREMOLD FROM DEVICE TO ACCESSIBLE CEILING SPACE IF POSSIBLE. OR TO NEXT DEVICE/FIXTURE IN THE CIRCUIT AS SHOWN. COORDINATE W/TECHNOLOGY TO INCLUDE DATA/VOICE JACKS IN WIREMOLD WHERE NECESSARY.
- INSTALL NEW SURFACE MOUNTED BOX EXTENSION WIRE ALARM DEVICE TO EXISTING BACK BOX OF FIRE ALARM DEVICE WHICH WAS REMOVED. INSTALL WIREMOLD TO ACCESSIBLE CEILING SPACE TO INTERCONNECT DEVICE TO FIRE ALARM LOOP FOR THE AREA.
- INSTALL NEW SURFACE MOUNTED FIRE ALARM DEVICE IN SAME LOCATION AS DEVICE WHICH WAS REMOVED. REUSE EXISTING RACEWAY TO FISH WIRES TO DEVICE FROM NEARBY FIRE ALARM LOOP. EXTEND RACEWAY AS NECESSARY TO REACH ACCESSIBLE CEILING SPACE.
- VRF HEAT RECOVERY BRANCH CIRCUIT CONTROLLER SHOWN WILL HAVE A HARD WIRED INTERNAL CONDENSATE PUMP. PROVIDE WIRING FOR PUMP. COORDINATE W/MECHANICAL CONTRACTOR.
- FURNISH AND INSTALL ELECTRICAL PANEL. REFER TO ONE-LINE DIAGRAM DRAWING E300-1 AND PANEL SCHEDULE ON E300 SERIES DRAWINGS FOR NEW WORK REQUIREMENTS.
- CONDENSATE PUMP FOR BCC'S & WALL MOUNTED FCU'S NEED WIRING/POWER PROVIDED TO THEM. CONDENSATE PUMP POWER SHALL COME FROM THE UNIT IT IS SERVING. DISCONNECT SWITCH WIRING SHALL BE CONNECTED TO THE UNIT SAFETY CONNECTORS. WIRING SHALL BE FIELD SUPPLIED & SHALL BE IN ACCORDANCE W/MANUFACTURER'S REQUIREMENTS. REFER TO MECHANICAL DRAWINGS FOR MORE INFORMATION.

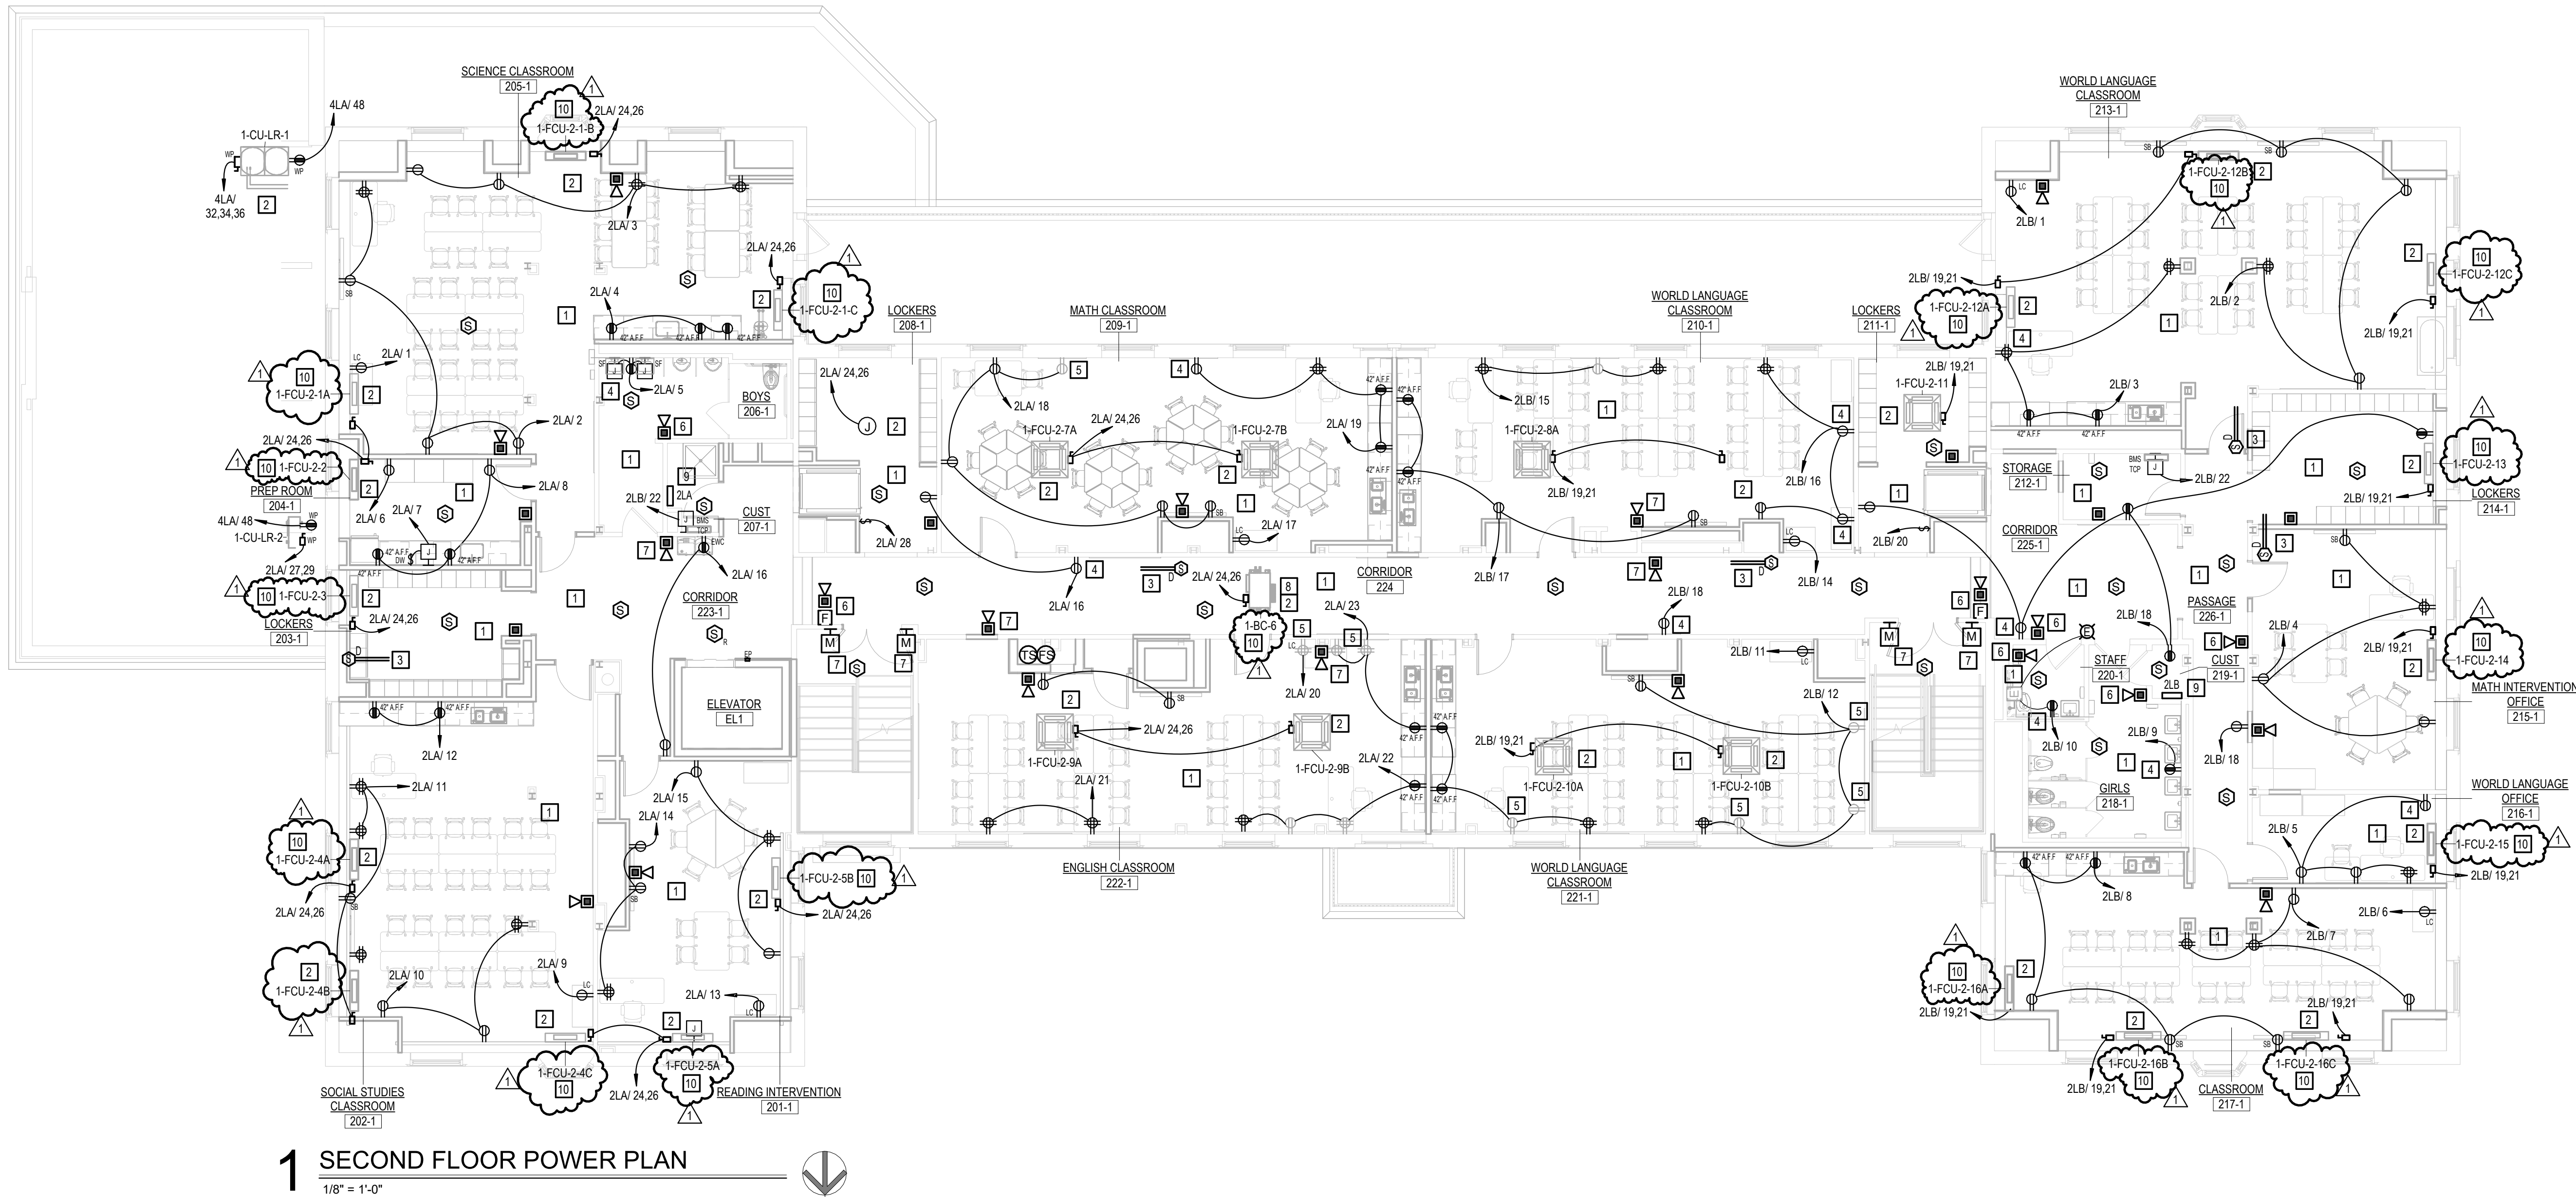

1 SECOND FLOOR POWER PLAN  
1/8" = 1'-0"

KEY PLAN  
SCALE: NTS

Project Title:  
**ALTERATIONS TO:  
ACES at Chase**  
565 Chase Parkway  
Waterbury, Connecticut 06708



**SILVER PETRUCCELLI + ASSOCIATES**  
3190 WHITNEY AVENUE HAMDEN CT 06518  
311 STATE STREET NEW LONDON CT 06320  
203 230 9007 silverpetrucci.com

Revision:	Description:	Date:	Revised By:
1	Bulletin #1	12/16/25	MTC

Drawing Title:  
**BUILDING 1 - SECOND LEVEL POWER PLAN**  
Project Phase:  
**ISSUED FOR BID - 11/03/2025**  
State Project Number:  
**#244-0044 MAG**

Date:  
AUGUST 12, 2025  
Scale:  
As indicated  
Drawn By:  
MTC  
Project Number:  
22.050

E220-1


12/16/2025 10:11:49 AM

GENERAL POWER NOTES

- REFER TO DRAWING E001-1 FOR ELECTRICAL SYMBOLS AND ABBREVIATIONS.
- ALL NEW RECEPTACLES SHALL BE TAMPER-PROOF TYPE PER NEC 406.12 UNLESS LOCATED MORE THAN 5'-6" ABOVE THE FLOOR OR SERVE A DEDICATED PIECE OF EQUIPMENT THAT CAN NOT BE EASILY MOVED TO EXPOSE THE PLUG.
- ALL DEVICES (RECEPTACLES, FIRE ALARM, CALL FOR AID, ETC.), AND ELECTRICAL EQUIPMENT (PANELBOARDS, DISCONNECT SWITCHES, ETC.) SHOWN DARK AND SOLID ARE TO BE NEW UNLESS OTHERWISE NOTED. ALL DEVICES AND EQUIPMENT SHOWN HALF TONE (LIGHT) AND SOLID ARE EXISTING TO REMAIN UNLESS OTHERWISE NOTED.

POWER KEY NOTES

- ALL DEVICES WHICH ARE MOUNTED ON EXISTING WALLS SHALL BE SURFACE MOUNTED DEVICES. THE RACEWAY SERVING THESE SPACES SHALL BE WIREMOLD PAINTED TO MATCH THE WALL. THE RACEWAY SHALL COME FROM THE CEILING & CONNECT ALL DEVICES SHOWN ON THE CIRCUIT. EXPOSED CONDUIT IN FINISHED SPACES IS NOT ACCEPTABLE. COORDINATE W/TECHNOLOGY TO INCLUDE DATA/VOICE JACKS IN WIREMOLD WHERE NECESSARY.
- EQUIPMENT SHOWN IS CONTROLLED VIA THE BUILDING MANAGEMENT SYSTEM. PROVIDE ALL NECESSARY WIRING BETWEEN THE CONTROLLER, EQUIPMENT, RELAYS, ETC. COORDINATE LOCATION OF POWER FOR EQUIPMENT SHOWN W/ASSOCIATED CONTRACTORS OF OTHER DISCIPLINES.
- POWER TO DAMPER SHALL COME FROM NEARBY AREA RECEPTACLE CIRCUIT. PROVIDE DUCT SMOKE & FIRE ALARM RELAY. WIRING OF DAMPER SHALL CLOSE ON DETECTION OF SMOKE & DETECTORS/RELAYS SHALL BE WIRED TO FIRE ALARM SYSTEM. COORDINATE W/CONTRACTOR.
- INSTALL NEW SURFACE MOUNTED BOX EXTENSION WIRECEPTACLE TO EXISTING BACK BOX OF RECEPTACLE WHICH WAS REMOVED. INSTALL WIREMOLD TO INTERCONNECT THE DEVICES ON THE CIRCUIT SHOWN. COORDINATE W/TECHNOLOGY TO INCLUDE DATA/VOICE JACKS IN WIREMOLD WHERE NECESSARY.
- EXISTING SURFACE MOUNTED RECEPTACLE. INSTALL WIREMOLD FROM DEVICE TO ACCESSIBLE CEILING SPACE IF POSSIBLE. OR TO NEXT DEVICE/FIXTURE IN THE CIRCUIT AS SHOWN. COORDINATE W/TECHNOLOGY TO INCLUDE DATA/VOICE JACKS IN WIREMOLD WHERE NECESSARY.
- INSTALL NEW SURFACE MOUNTED BOX EXTENSION WIRE FIRE ALARM DEVICE TO EXISTING BACK BOX OF FIRE ALARM DEVICE WHICH WAS REMOVED. INSTALL WIREMOLD TO ACCESSIBLE CEILING SPACE TO INTERCONNECT DEVICE TO FIRE ALARM LOOP FOR THE AREA.
- INSTALL NEW SURFACE MOUNTED FIRE ALARM DEVICE IN SAME LOCATION AS DEVICE WHICH WAS REMOVED. REUSE EXISTING RACEWAY TO FISH WIRES TO DEVICE FROM NEARBY FIRE ALARM LOOP. EXTEND RACEWAY AS NECESSARY TO REACH ACCESSIBLE CEILING SPACE.
- VRF HEAT RECOVERY BRANCH CIRCUIT CONTROLLER SHOWN WILL HAVE A HARD WIRED INTERNAL CONDENSATE PUMP. PROVIDE WIRING FOR PUMP. COORDINATE W/MECHANICAL CONTRACTOR.
- EXISTING ELECTRICAL PANEL. REFER TO ONE-LINE DIAGRAM DRAWING E300-1 AND PANEL SCHEDULE ON E300 SERIES DRAWINGS FOR NEW WORK REQUIREMENTS.
- CONDENSATE PUMP FOR BCC'S & WALL MOUNTED FCU'S NEED WIRING/POWER PROVIDED TO THEM. CONDENSATE PUMP POWER SHALL COME FROM THE UNIT IT IS SERVING. DISCONNECT SWITCH WIRING SHALL BE CONNECTED TO THE UNIT SAFETY CONNECTORS. WIRING SHALL BE FIELD SUPPLIED & SHALL BE IN ACCORDANCE W/MANUFACTURER'S REQUIREMENTS. REFER TO MECHANICAL DRAWINGS FOR MORE INFORMATION.

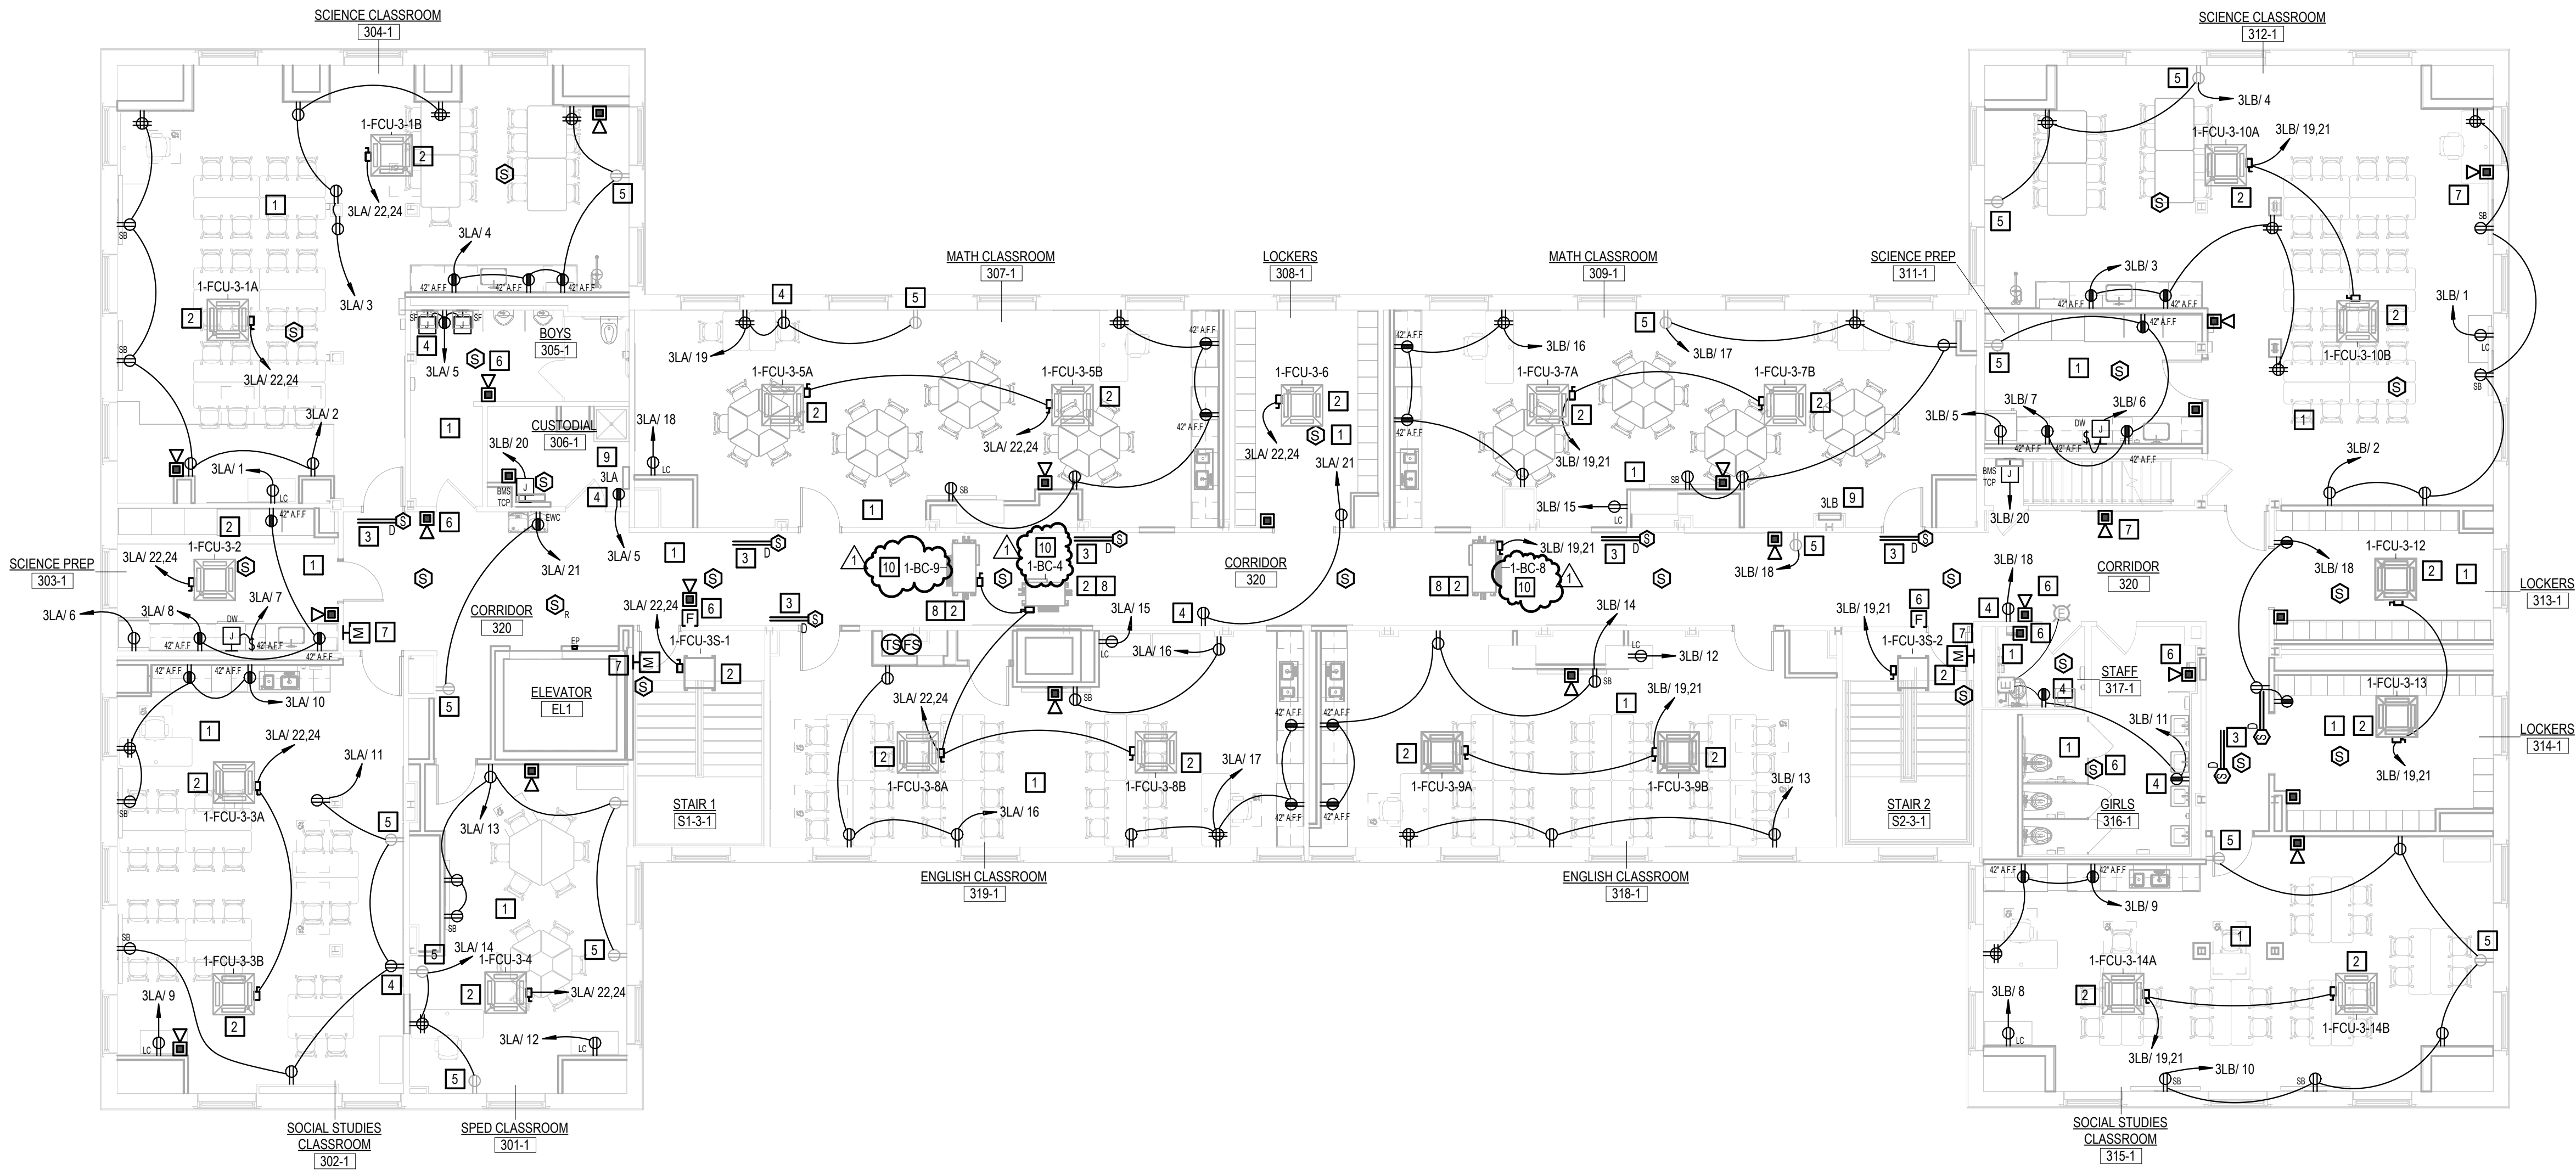

1 THIRD FLOOR POWER PLAN  
1/8" = 1'-0"

KEY PLAN  
SCALE: NTS

Project Title:  
**ALTERATIONS TO:  
ACES at Chase**  
565 Chase Parkway  
Waterbury, Connecticut 06708



**SILVER PETRUCCELLI + ASSOCIATES**  
3190 WHITNEY AVENUE HAMDEN CT 06518  
311 STATE STREET NEW LONDON CT 06320  
203 230 9007 silverpetrucci.com

Revision:	Description:	Date:	Revised By:
1	Bulletin #1	12/16/25	MTC


Drawing Title:  
**BUILDING 1 - THIRD LEVEL POWER  
PLAN**  
Project Phase:  
**ISSUED FOR BID - 11/03/2025**  
State Project Number:  
**#244-0044 MAG**

Date:  
AUGUST 12, 2025  
Scale:  
As indicated  
Drawn By:  
MTC  
Project Number:  
22.050

E230-1

12/16/2025 10:12:13 AM




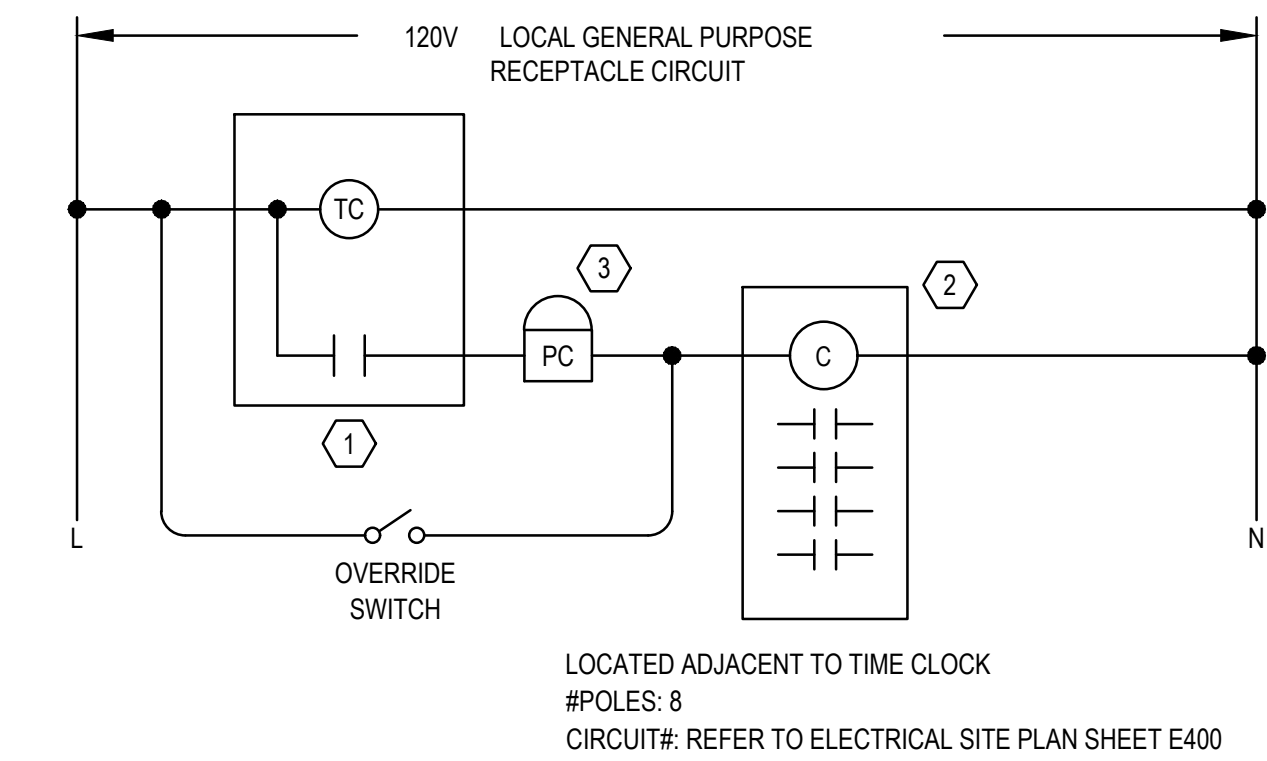


LOCATED ADJACENT TO TIME CLOCK  
#POLES: 8  
CIRCUIT#: REFER TO ELECTRICAL SITE PLAN SHEET E400

CONTACTOR SCHEDULE			
YAG	DESCRIPTION	MODEL NO.	REMARKS
1	DIGITAL PROGRAMMABLE TIME CLOCK 24HR. TDY 365DAY. SEASONAL SCHEDULING. 99 ON/OFF POINTS. PERMANENT SCHEDULE RETENTION ON POWER LOSS. POWER OUTAGE BACKUP. AUTOMATIC LEAP YEAR AND DAYLIGHT SAVINGS TIME ADJ. MECHANICALLY WELDED CONTACTS. MULTI VOLTAGE INPUT.	TORK 02S300A OR EQUIVALENT INTERMATIC OR SQUARE D	1.2.4
2	CONTACTOR ELECTRICALLY OPERATED. MECHANICALLY HELD. 250A LIGHTING CONTACTOR. CONTROL VOLTAGE AS LISTED. FROM LOCAL GENERAL PURPOSE RECEPTACLE CIRCUIT.	ASCO 917 SERIES WITH 2 WIRE CONTROL. OPTION OR EQUIVALENT GE OR SQUARE D	
3	PHOTOCELL 1800V. 10A. 40 DEG. TO 140 DEG. SOLID STATE SPST DRY CONTACT. LIGHT LEVEL RANGE 1.5 TO 10IC WITH ADJUSTMENT. TIME DELAY 15 SEC. MINIMUM	TORK 2100 SERIES OR EQUIVALENT INTERMATIC OR SQUARE D	3
<b>NOTES:</b> 1. TIMECLOCK SHALL BE PROGRAMMED TO TURN SITE LIGHTING ON AT DUSK (VIA PHOTOCELL) AND OFF WHENEVER THE OWNER WOULD LIKE IT OFF. 2. LOCATE TIME CLOCK ADJACENT TO ELECTRICAL PANEL. 3. PHOTOCELL TO BE LOCATED ON SOUTHERN EXPOSURE. 4. PROVIDE BACKUP CAPABILITY TO TIE INTO BMS & ACCESS CONTROLS REMOTELY.			

1 LIGHTING TIME CLOCK & CONTACTOR DETAIL  
SCALE: NONE

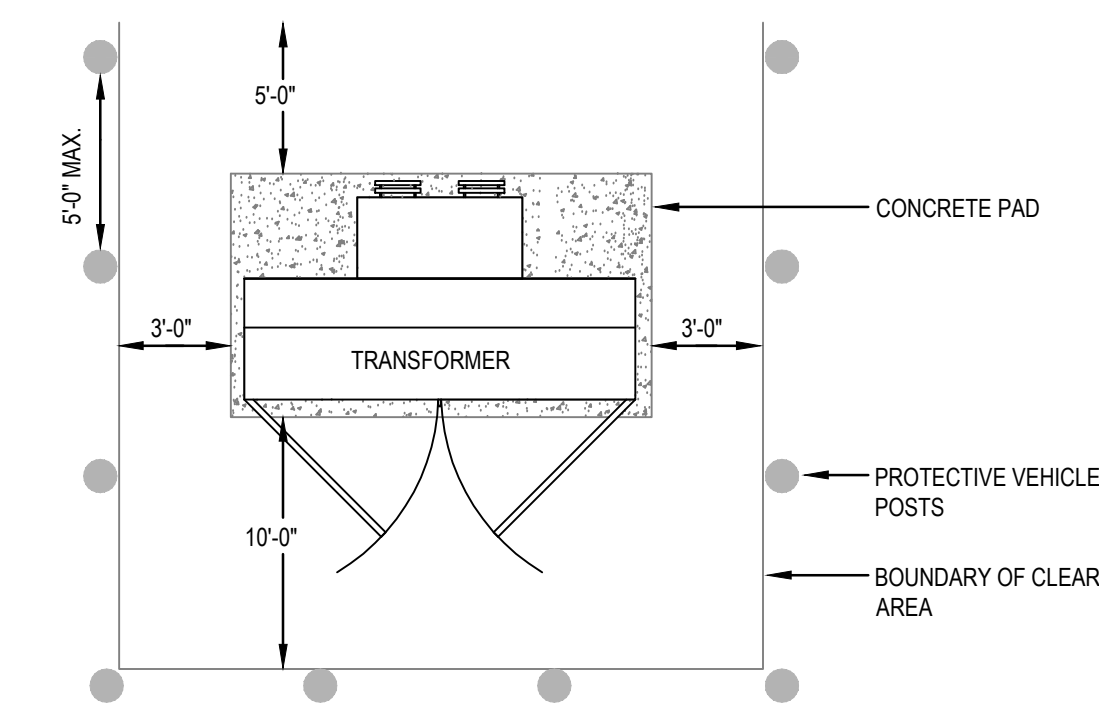


2 TYPICAL PAD MOUNTED TRANSFORMER  
SCALE: NONE

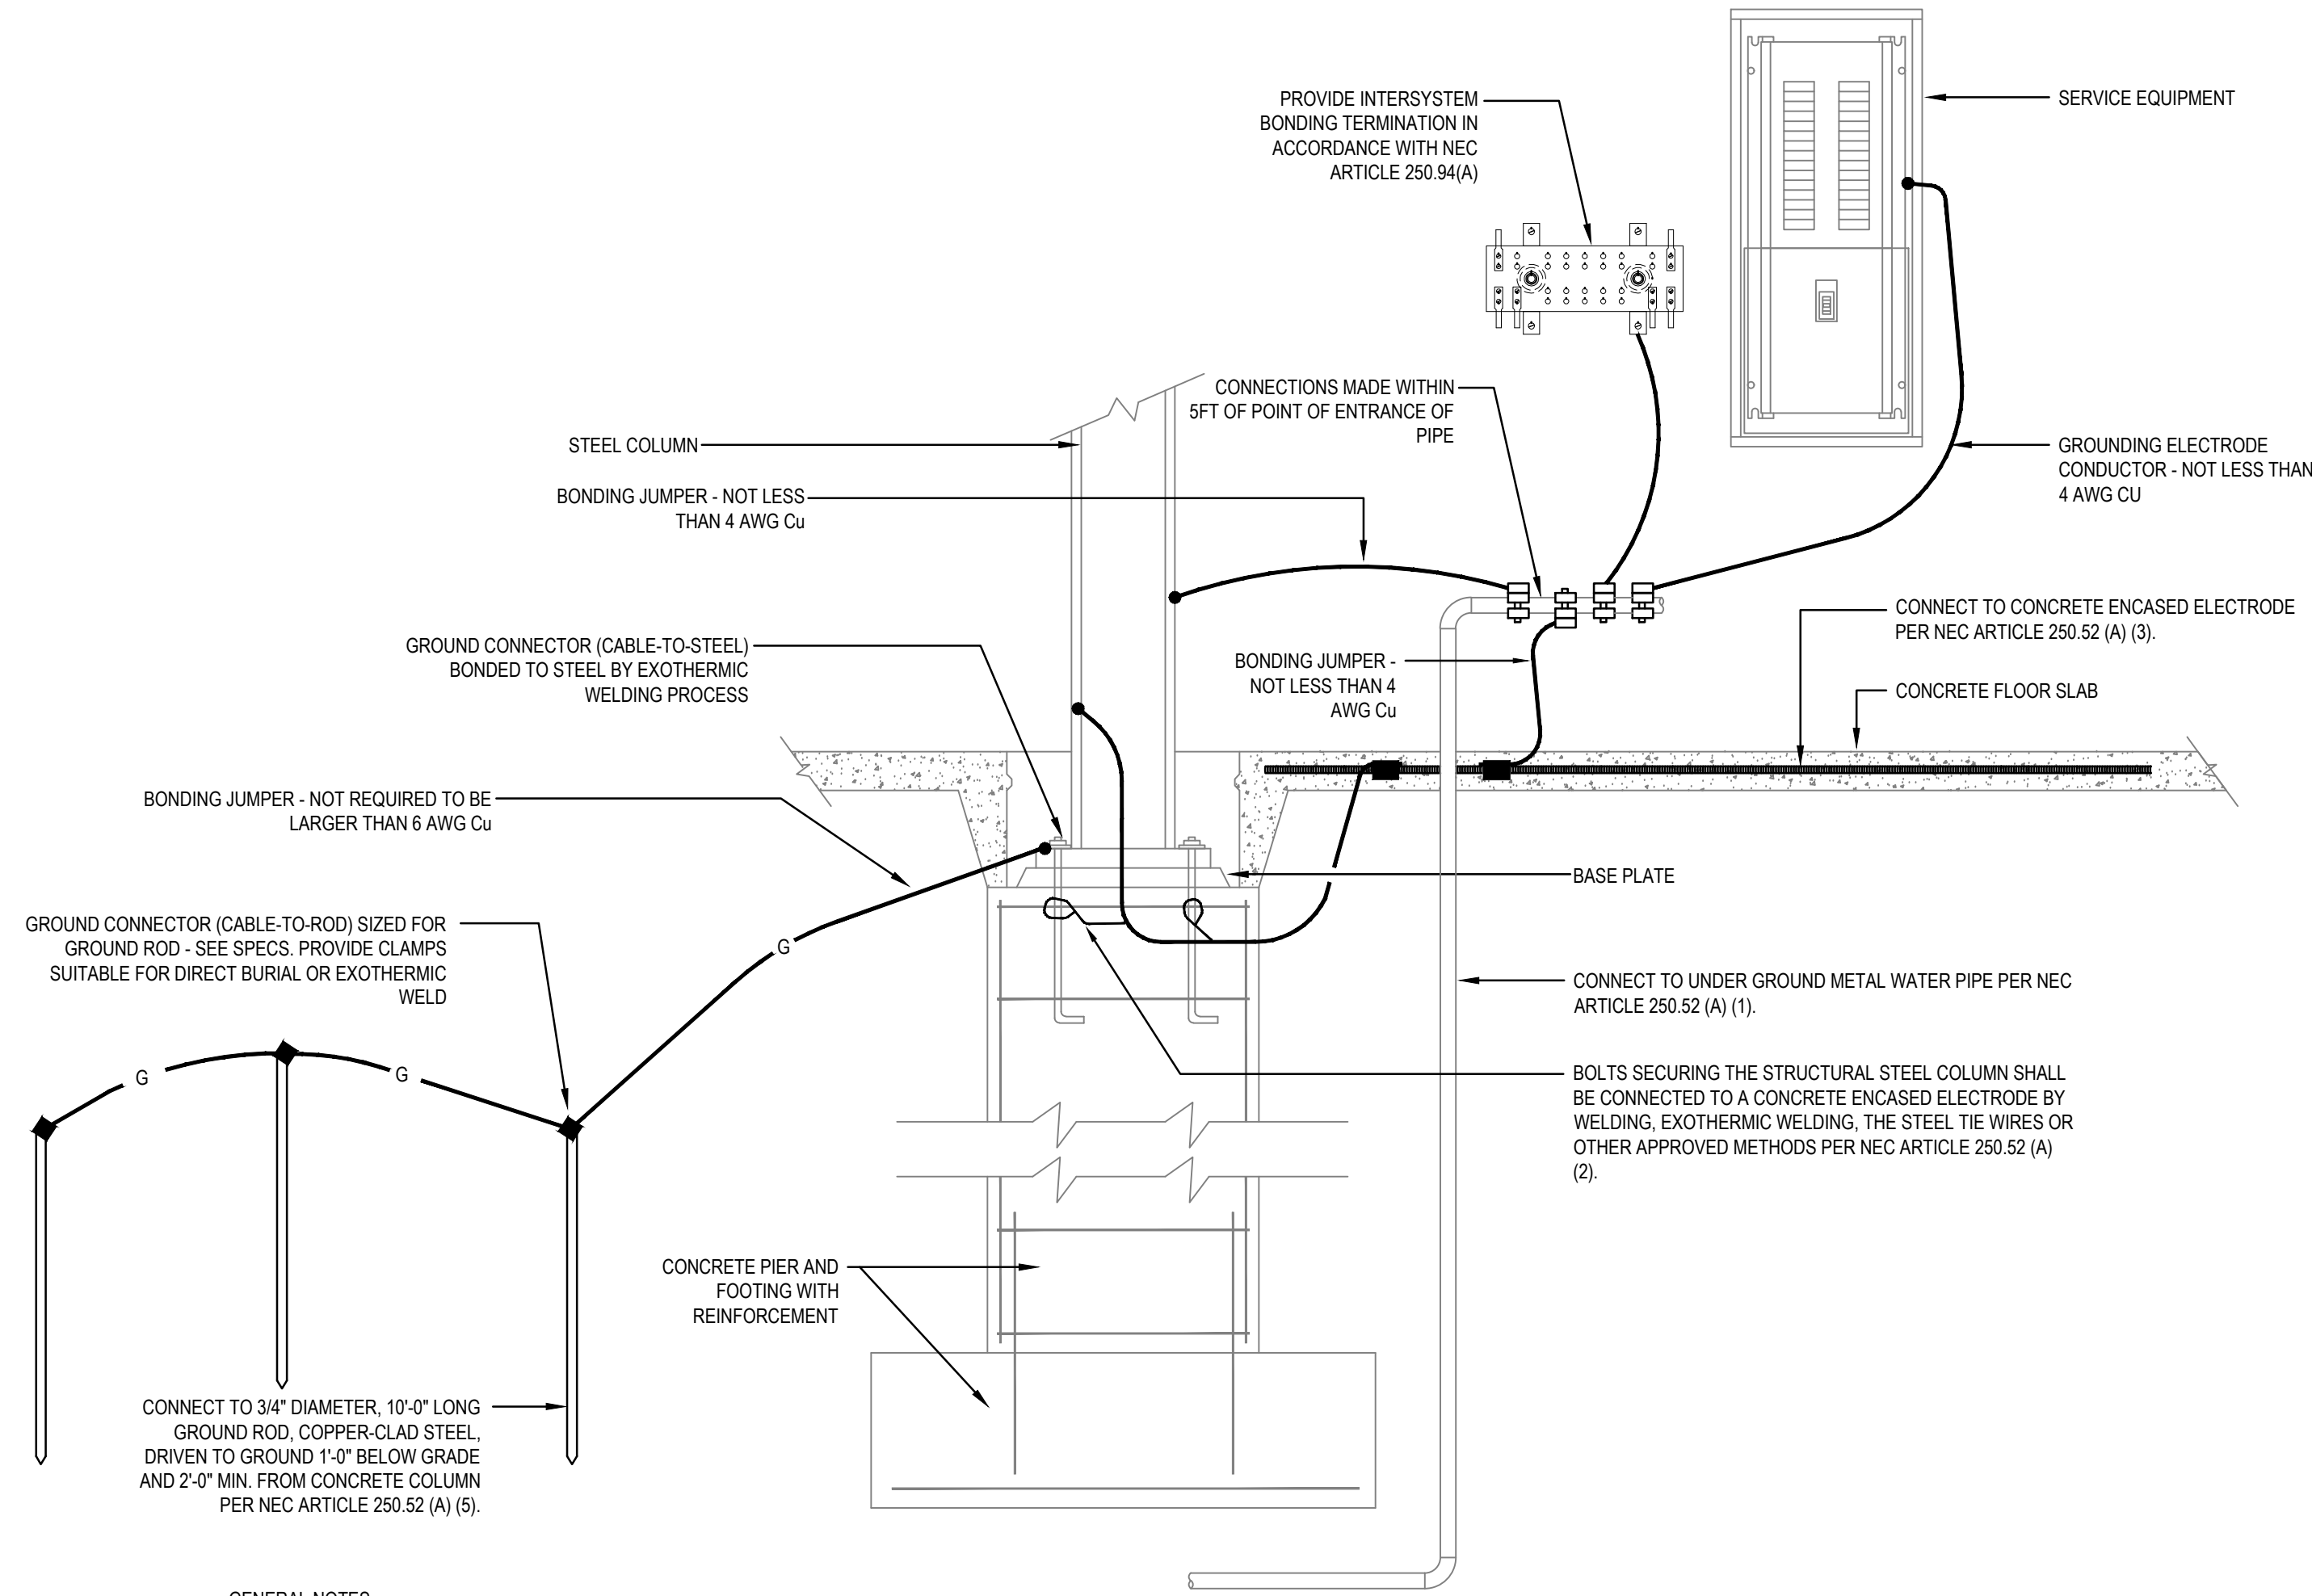


GENERAL NOTES:

1. PROVIDE GROUNDING ELECTRODE SYSTEM PER NEC ARTICLE 250.50. ALL GROUNDING ELECTRODES AS DESCRIBED IN 250.52 (A) (1) THROUGH (A) (7) THAT ARE PRESENT AT EACH BUILDING OR STRUCTURE SERVED SHALL BE BONDED TOGETHER TO FORM THE GROUNDING ELECTRODE SYSTEM.

3 TYPICAL GROUNDING DETAIL  
SCALE: NONE

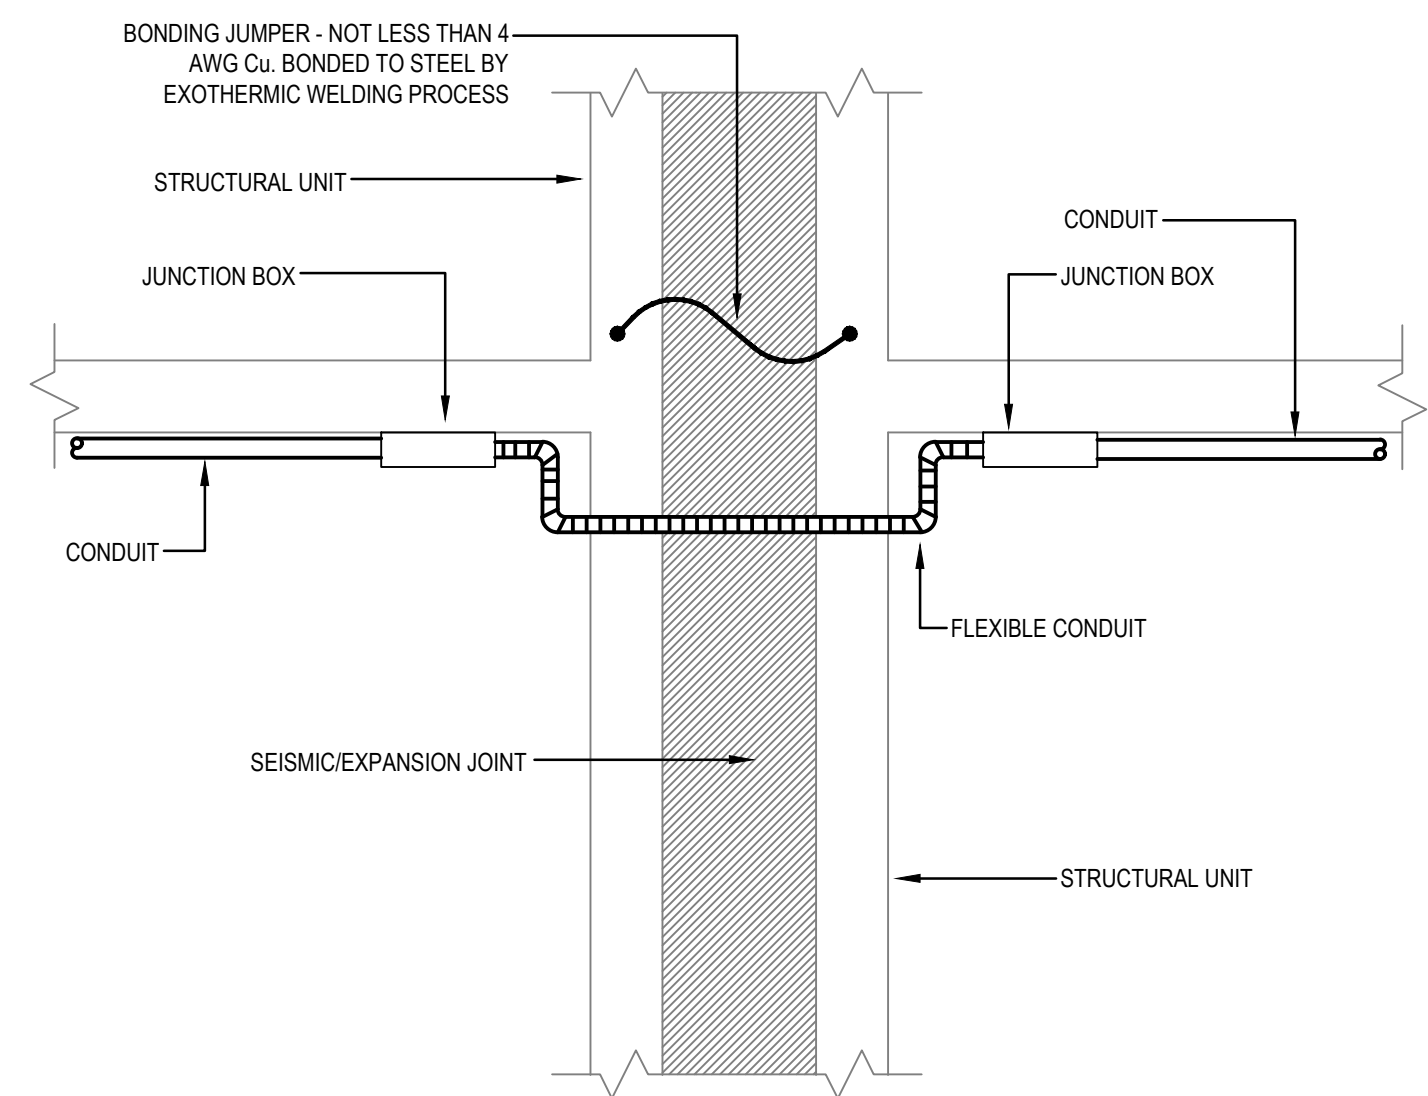

4 EXPANSION/SEISMIC JOINT FITTING DETAIL  
SCALE: NONE

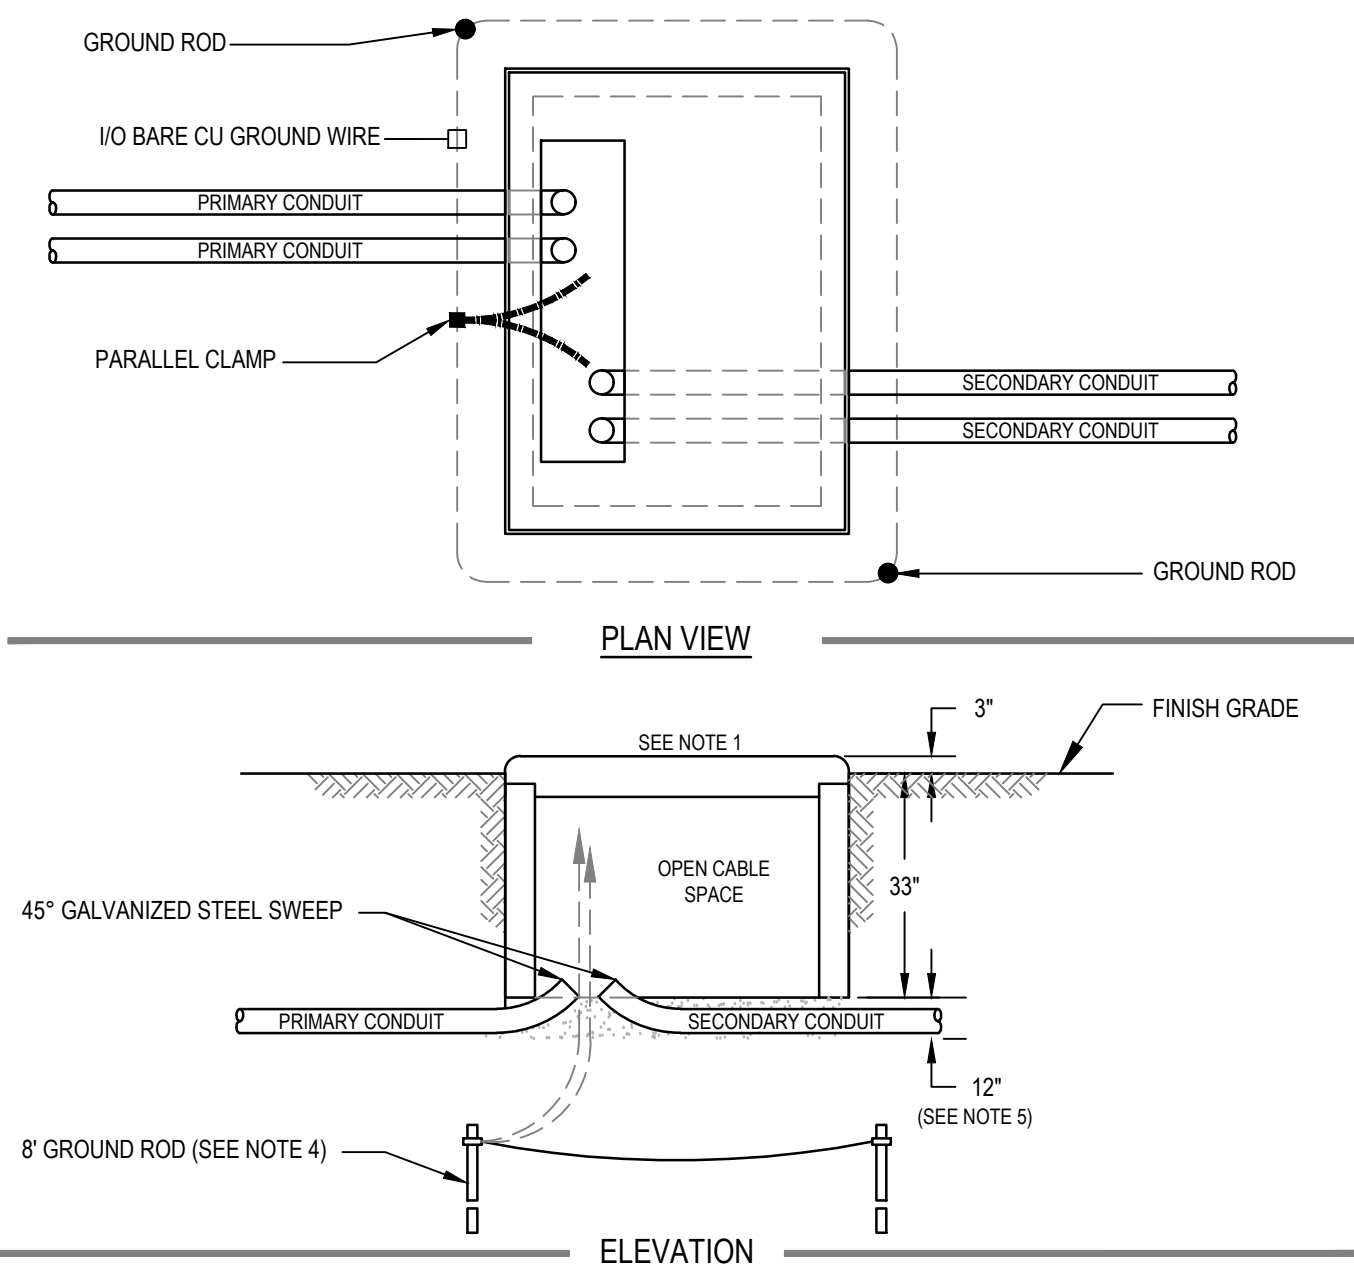

- NOTES:
1. 75-300 KVA: INSTALL 76" X 54" X 36" PAD PER SPC P-05, P-06.  
500-1500 KVA: INSTALL 76" X 70" X 36" PAD PER SPC P-07, P-08.
  2. PRIMARY CABLE:  
A. INSTALL CABLES IN CONDUIT A MINIMUM OF 3" BELOW GRADE.  
B. LOOP CABLES IN CABLE VAULT BEFORE MAKING CONNECTIONS.
  3. SECONDARY CABLE:  
LEAVE SLACK FOR FUTURE RECONNECTING TO TRANSFORMERS WITH HIGHER SECONDARY TERMINALS.
  4. COPPERWELDED GROUND RODS: INSTALL IN TRENCH


AND CONNECT A BARE 1/0 COPPER CONDUCTOR FROM RODS THROUGH PAD OPENING AND EXTENDING 5 FT. ABOVE PAD.  
5. THE EXCAVATION FOR THE PAD SHALL BE CARRIED TO A DEPTH OF 12" BELOW THE BOTTOM OF THE PAD WALLS. THE BACKFILL UNDER THE PAD WALLS SHALL BE A CLEAN GRAVEL, FREE OF FOREIGN MATTER AND CONSTRUCTION DEBRIS, AND IN ACCORDANCE WITH CONN D.O.T. SPEC. M.02.06 GRADING "A". BACKFILL SHALL BE PLACED IN 6" LAYERS AND COMPACTED WITH MECHANICAL TAMPERS TO NOT LESS THAN 95% OF THE MAXIMUM DRY DENSITY AS DETERMINED BY STANDARD COMPACTION TESTS, AASHTO T199 OR ASTM D698.

5 PRECAST CONCRETE TRANSFORMER PAD DETAIL  
SCALE: NONE


GENERAL NOTES:

PROVIDE UL LISTED FIRE/SMOKE PENETRATION ASSEMBLY IN ACCORDANCE W/ UL1479, ASTM E814 REQUIREMENTS FOR WALL TYPE, RATING, PIPE SIZE, INSTALLED.


FIRE STOPPING SHALL HAVE A RATING EQUAL TO OR GREATER THAN THE WALL BEING PENETRATED - SEE SPECIFICATIONS. REFER TO ARCHITECTURAL DRAWINGS FOR WALL RATINGS AND LOCATIONS.

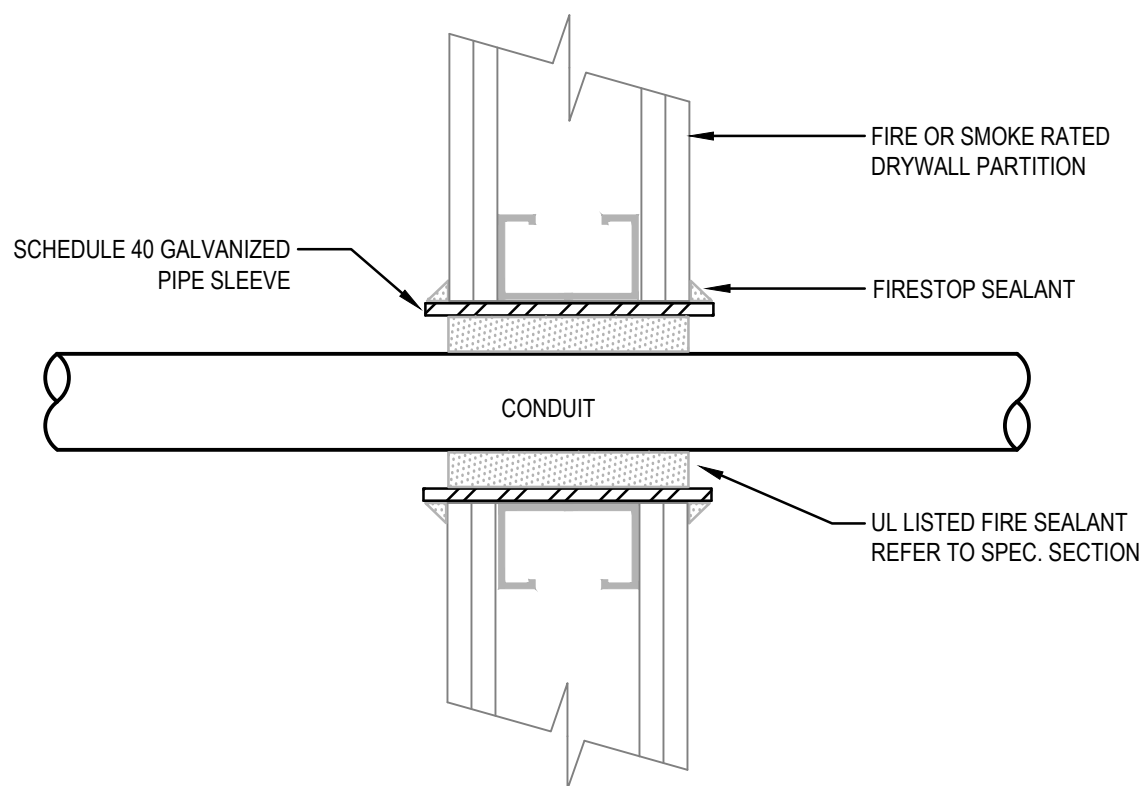

6 WALL PENETRATION W/FIRE-SMOKE SEAL DETAIL  
SCALE: NONE

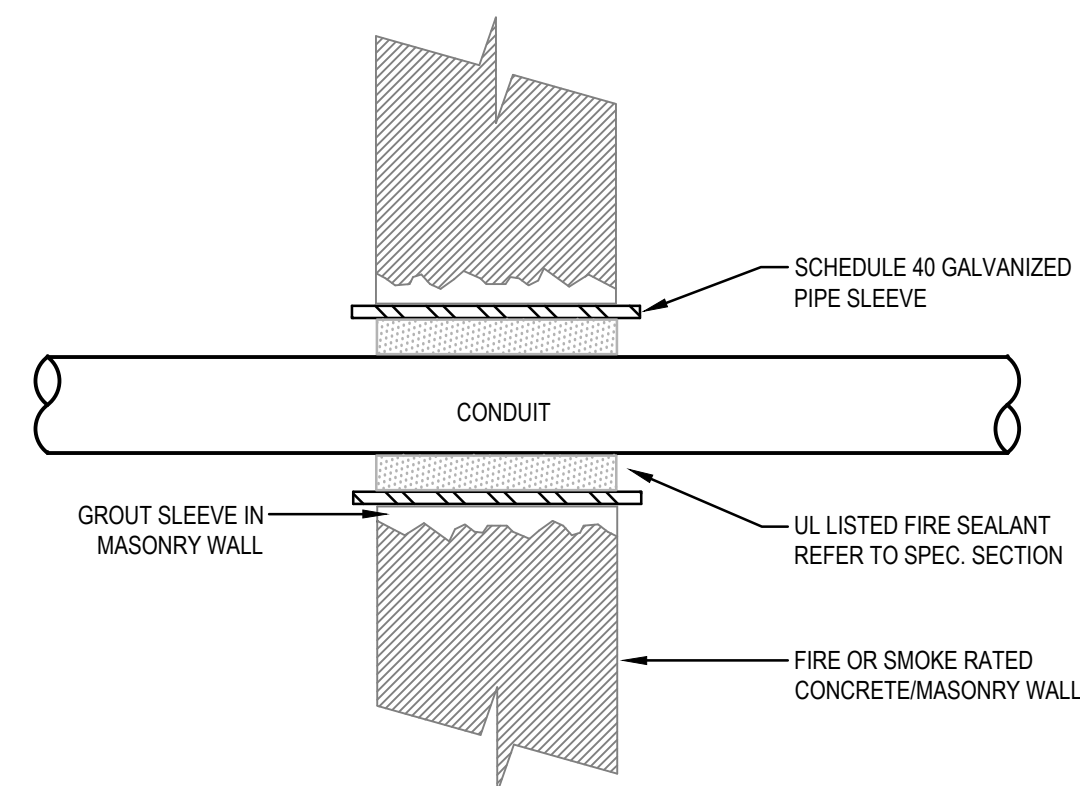

7 WATER-TIGHT WALL SLEEVE  
SCALE: NONE

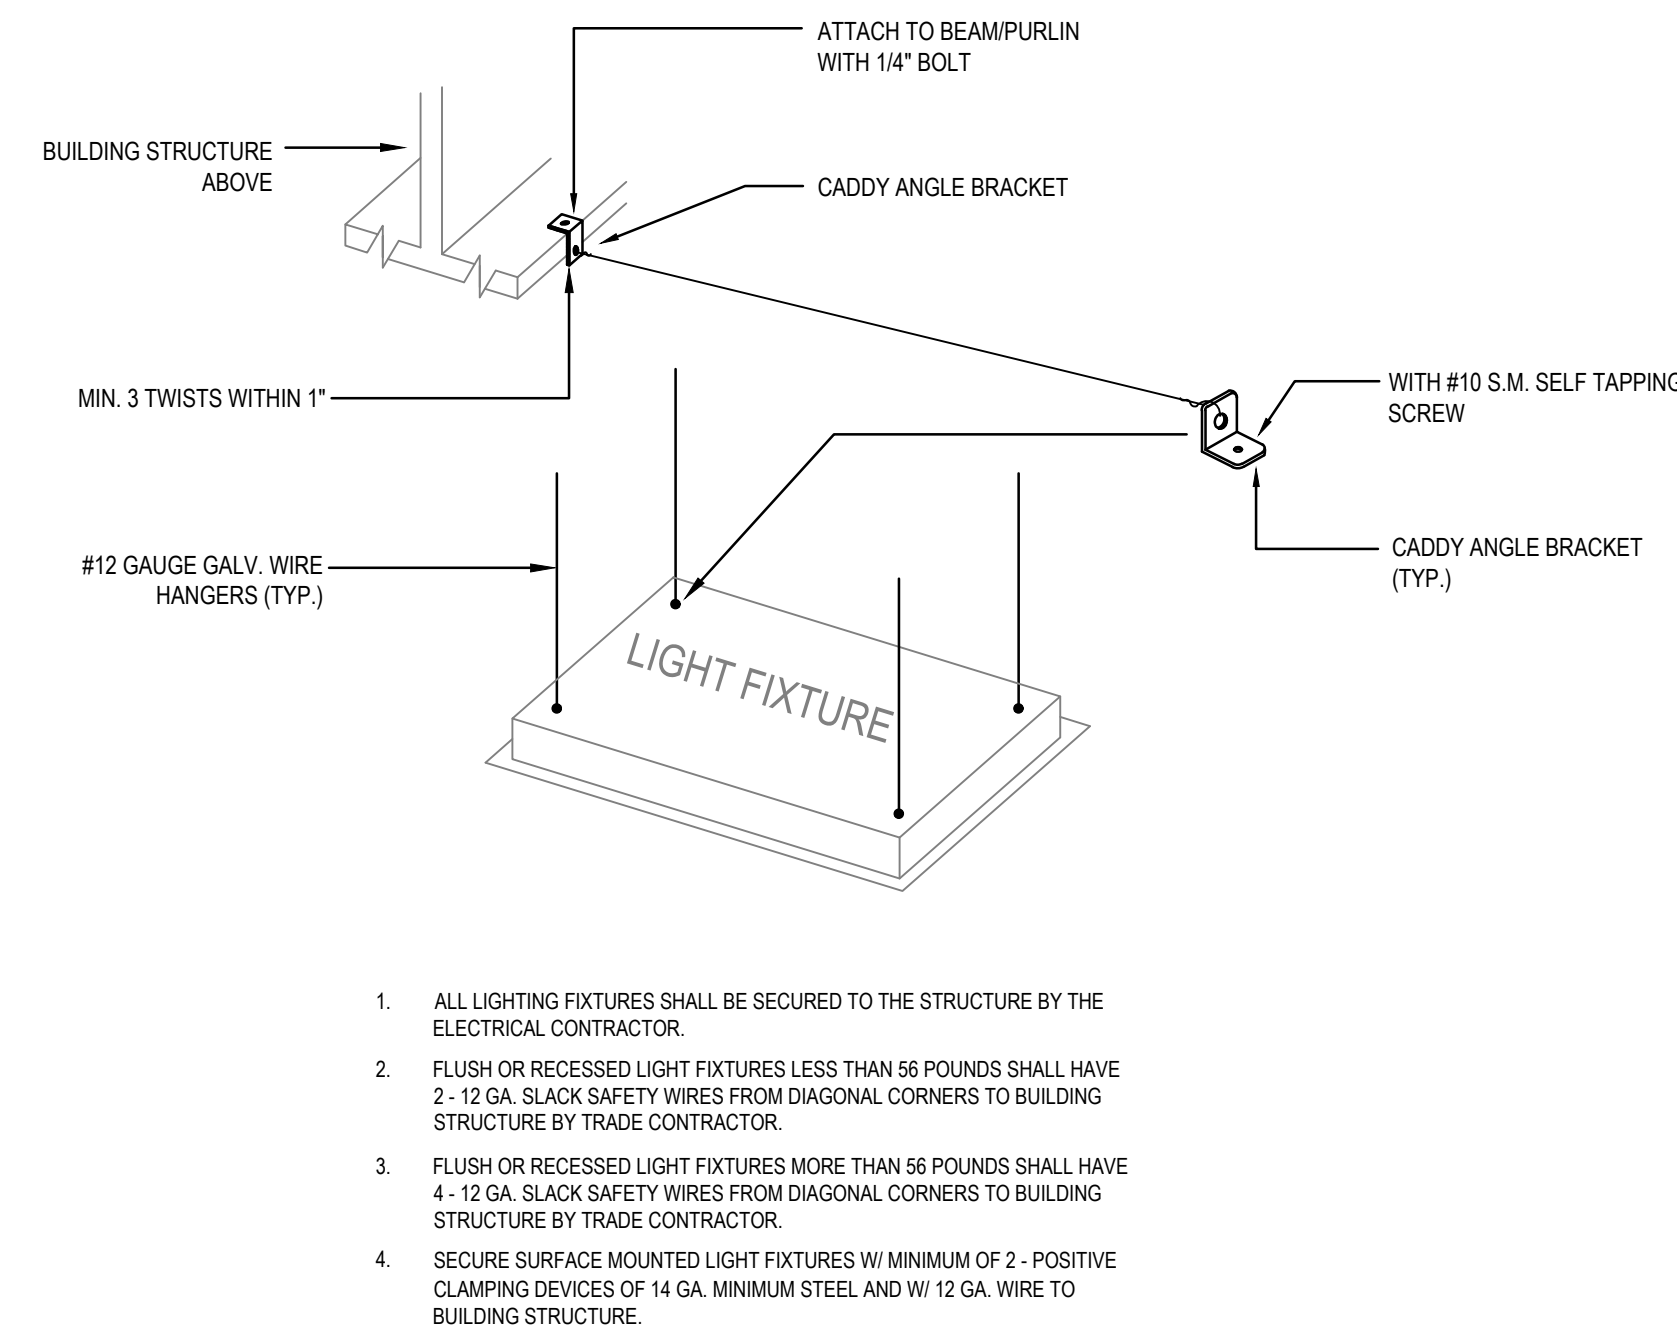

1. ALL LIGHTING FIXTURES SHALL BE SECURED TO THE STRUCTURE BY THE ELECTRICAL CONTRACTOR.
2. FLUSH OR RECESSED LIGHT FIXTURES LESS THAN 56 POUNDS SHALL HAVE 2-12 GA. SLACK SAFETY WIRES FROM DIAGONAL CORNERS TO BUILDING STRUCTURE BY TRADE CONTRACTOR.
3. FLUSH OR RECESSED LIGHT FIXTURES MORE THAN 56 POUNDS SHALL HAVE 4-12 GA. SLACK SAFETY WIRES FROM DIAGONAL CORNERS TO BUILDING STRUCTURE BY TRADE CONTRACTOR.
4. SECURE SURFACE MOUNTED LIGHT FIXTURES W/ MINIMUM OF 2 - POSITIVE CLAMPING DEVICES OF 1/4 GA. MINIMUM STEEL AND W/ 1/2 GA. WIRE TO BUILDING STRUCTURE.

8 TYPICAL LAY-IN GRID LIGHTING FIXTURE SUPPORT/MOUNTING DETAIL  
SCALE: NONE

Project Title:  
**ALTERATIONS TO:  
ACES at Chase**  
565 Chase Parkway  
Waterbury, Connecticut 06708



SILVER PETRUCCELLI + ASSOCIATES

3190 WHITNEY AVENUE HAMDEN CT 06518  
311 STATE STREET NEW LONDON CT 06320  
203 230 9007 silverpetrucci.com

Revision:	Description:	Date:	Revised By:
1	Bulletin #1	12/16/25	MTC

Drawing Title:  
**BUILDING 1 - DETAILS**

Project Phase:  
**ISSUED FOR BID - 11/03/2025**  
State Project Number:  
**#244-0044 MAG**

Date:  
AUGUST 12, 2025  
Scale:  
AS NOTED  
Drawn By:  
MTC  
Project Number:  
22.050




Drawing Number:  
**E400-1**

## GENERAL POWER NOTES

- 1 REFER TO DRAWING E001-2 FOR ELECTRICAL SYMBOLS AND ABBREVIATIONS.
- 2 ALL NEW RECEPTACLES SHALL BE TAMPER-PROOF TYPE PER NEC 406.12 UNLESS LOCATED MORE THAN 5'-6" ABOVE THE FLOOR OR SERVE A DEDICATED PIECE OF EQUIPMENT THAT CAN NOT BE EASILY MOVED TO EXPOSE THE PLUG.
- 3 ALL DEVICES (RECEPTACLES, FIRE ALARM, CALL FOR AID, ETC.), AND ELECTRICAL EQUIPMENT (PANELBOARDS, DISCONNECT SWITCHES, ETC.) SHOWN DARK AND SOLID ARE TO BE NEW UNLESS OTHERWISE NOTED. ALL DEVICES AND EQUIPMENT SHOWN HALF-TONE (LIGHT) AND SOLID ARE EXISTING TO REMAIN UNLESS OTHERWISE NOTED.

## POWER KEY NOTES

- 1 FURNISH AND INSTALL ELECTRICAL PANEL AND REWORK EXISTING CIRCUITS TO THIS PANEL, WHICH ARE NOT BEING REMOVED. CONTRACTOR TO MAINTAIN ALL EXISTING ACTIVE BRANCH CIRCUITS. BALANCE LOADS AND INSTALL NEW TYPED PANEL DIRECTORY. REFER TO ONE-LINE DIAGRAM DRAWING E300-2 AND PANEL SCHEDULE ON E300 SERIES DRAWINGS FOR NEW WORK REQUIREMENTS.
- 2 ALL NEW DEVICES WHICH ARE MOUNTED ON EXISTING WALLS SHALL BE SURFACE MOUNTED DEVICES. THE RACEWAY SERVING THESE SPACES SHALL BE WIREMOLD PAINTED TO MATCH THE WALL. THE RACEWAY SHALL COME FROM THE CEILING & CONNECT ALL DEVICES SHOWN ON THE CIRCUIT. EXPOSED CONDUIT IN FINISHED SPACES IS NOT ACCEPTABLE. COORDINATE WIRETECHNOLOGY TO INCLUDE DATA/Voice JACKS IN WIREMOLD WHERE NECESSARY.
- 3 EQUIPMENT SHOWN IS CONTROLLED VIA THE BUILDING MANAGEMENT SYSTEM. PROVIDE ALL NECESSARY WIRING BETWEEN THE CONTROLLER, EQUIPMENT, RELAYS, ETC. COORDINATE LOCATION OF POWER FOR EQUIPMENT SHOWN W/ASSOCIATED CONTRACTORS OF OTHER DISCIPLINES.
- 4 PROVIDE & INSTALL NEMA 1, 60A, 208V, 3 PHASE, SHUNT-TRIP FUSIBLE DISCONNECT SWITCH WITH AUXILIARY CONTACTS TO BE WIRED TO ELEVATOR BATTERY BACKUP. DISCONNECT SWITCH SHALL CONTAIN 40A FUSES. PROVIDE & INSTALL NEMA 1, 30A, 120V, SINGLE PHASE, FUSED DISCONNECT SWITCH W/20A FUSE FOR CAB LIGHTING POWER.
- 5 INSTALL NEW RECEPTACLE IN EXISTING BACK BOX OF RECEPTACLE WHICH WAS REMOVED. FISH WIRE TO DEVICE & WIRE IT TO DEVICES ON CIRCUIT AS SHOWN.
- 6 EXISTING SURFACE MOUNTED RECEPTACLE. INSTALL WIREMOLD TO INTERCONNECT DEVICES AS SHOWN & TO ACCESSIBLE CEILING SPACE. MINIMIZE AMOUNT OF WIREMOLD USED AS POSSIBLE. WIREMOLD SHALL BE PAINTED TO MATCH COLOR OF WALL INSTALLED ON.
- 7 INSTALL NEW FIRE ALARM DEVICE IN EXISTING BACK BOX OF DEVICE WHICH WAS REMOVED. FISH WIRE TO DEVICE THROUGH EXISTING RACEWAY & INTERCONNECT DEVICE TO FIRE ALARM LOOP FOR THE AREA.
- 8 PROPOSED CONDUIT PATH FOR FLOOR BOXES, FLOOR MUST BE TRENCHED TO LOCATIONS SHOWN. COORDINATE W/ARCHITECTURAL DRAWINGS. ANY PATHWAY WHICH IS TO BE LOCATED ON AN EXISTING WALL SHALL BE WIREMOLD, PAINTED TO MATCH COLOR OF WALL.
- 9 BUILDING WILL BE OCCUPIED WHILE BEING RENOVATED. THE FIRE ALARM SYSTEM MUST BE FUNCTIONAL AT ALL TIMES. WORK ON THE FIRE ALARM SYSTEM SHOULD BE DONE DURING OFF HOURS, OR DURING TIMES WHEN THERE WILL BE MINIMAL INTERRUPTION TO THE BUILDING. IF NEEDED, A FIRE WATCH SHOULD BE PROVIDED.
- 10 INDOOR UNIT SHOWN IS POWERED BY THE OUTDOOR CONDENSING UNIT. WIRE UNIT TO THE ASSOCIATED CONDENSING UNIT. REFER TO MANUFACTURER'S INSTRUCTIONS FOR INSTALLATION.
- 11 POWER FOR HEAT TRACE. COORDINATE LOCATION OF CONTROLLER W/PLUMBING CONTRACTOR. CIRCUIT BREAKER SERVING HEAT TRACE SHALL BE GFCI.
- 12 FAN COIL UNITS SHOWN WILL HAVE A HARD WIRED INTERNAL CONDENSATE PUMP. PROVIDE WIRING FOR PUMP. COORDINATE W/MECHANICAL CONTRACTOR.
- 13 AC UNIT SHOWN WILL HAVE A HARD WIRED CONDENSATE PUMP. PROVIDE WIRING FOR PUMP. COORDINATE W/MECHANICAL CONTRACTOR.
- 14 FURNISH AND INSTALL ELECTRICAL LIGHTING INVERTER PANEL. REFER TO ONE-LINE DIAGRAM DRAWING E300-2 AND PANEL SCHEDULE ON E300 SERIES DRAWINGS FOR NEW WORK REQUIREMENTS.
- 15 FURNISH AND INSTALL ELECTRICAL EQUIPMENT. REFER TO ONE-LINE DIAGRAM DRAWING E300-2 FOR NEW WORK REQUIREMENTS.
- 16 CONDENSATE PUMP FOR BCC'S & WALL MOUNTED FCU'S NEED WIRING POWER PROVIDED TO THEM. CONDENSATE PUMP POWER SHALL COME FROM THE UNIT IT IS SERVING. DISCONNECT SWITCH WIRING SHALL BE CONNECTED TO THE UNIT SAFETY CONNECTORS. WIRING SHALL BE FIELD SUPPLIED & SHALL BE IN ACCORDANCE W/MANUFACTURER'S REQUIREMENTS. REFER TO MECHANICAL DRAWINGS FOR MORE INFORMATION.

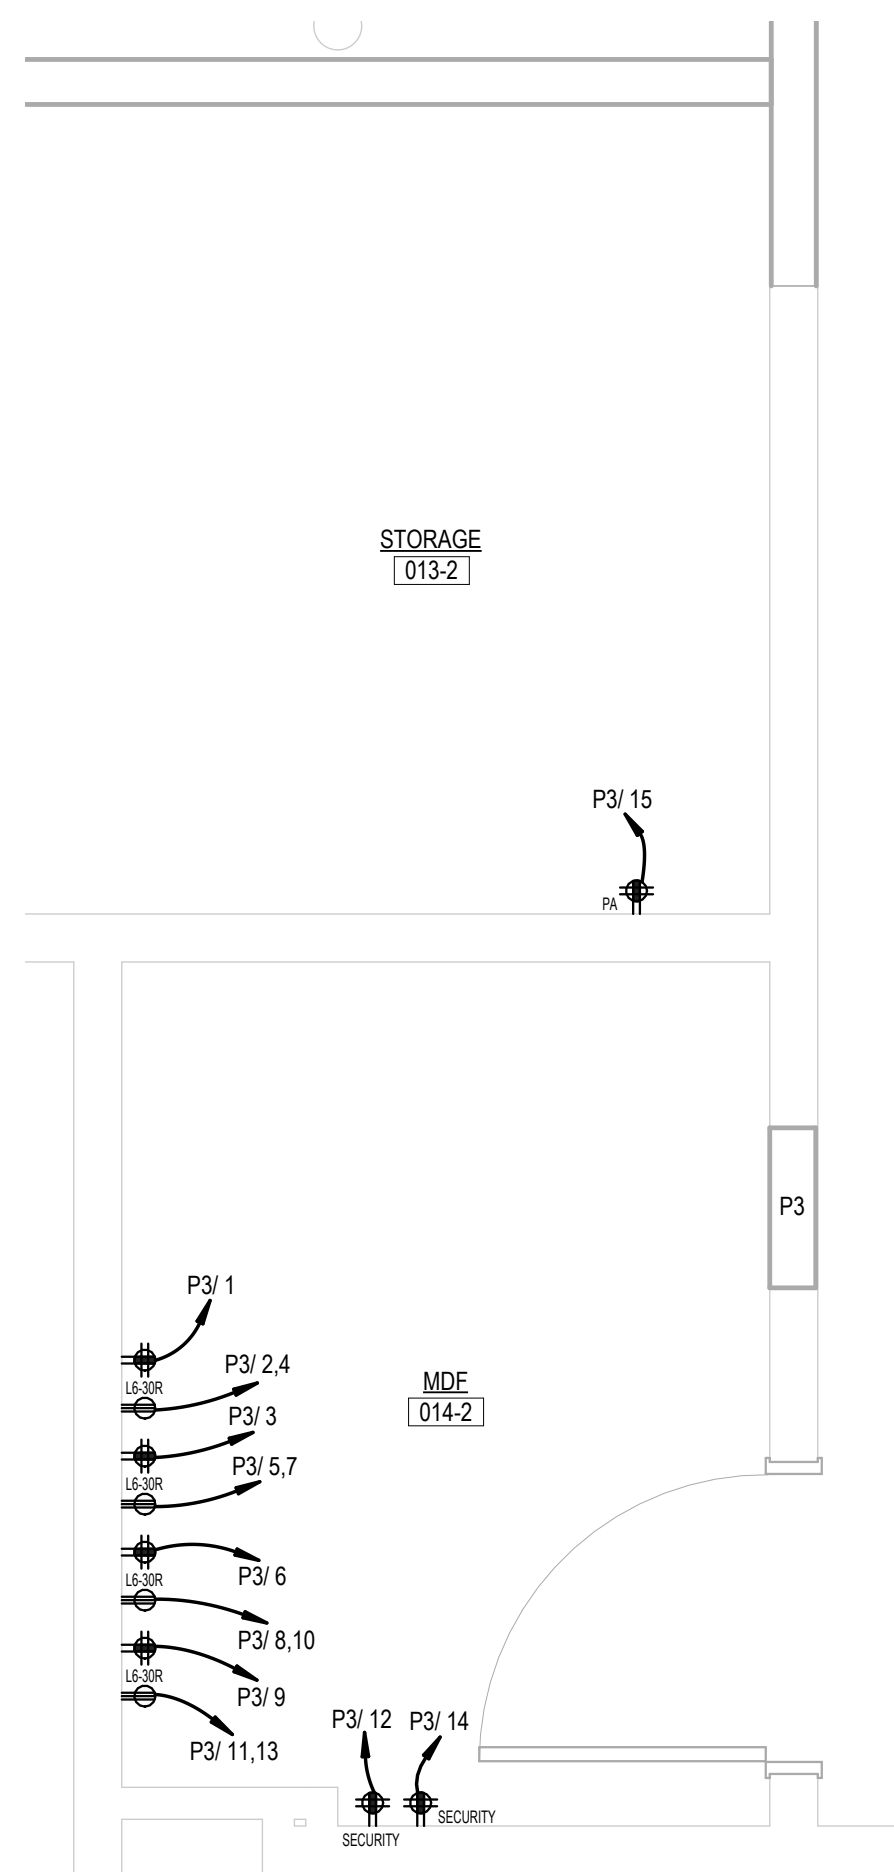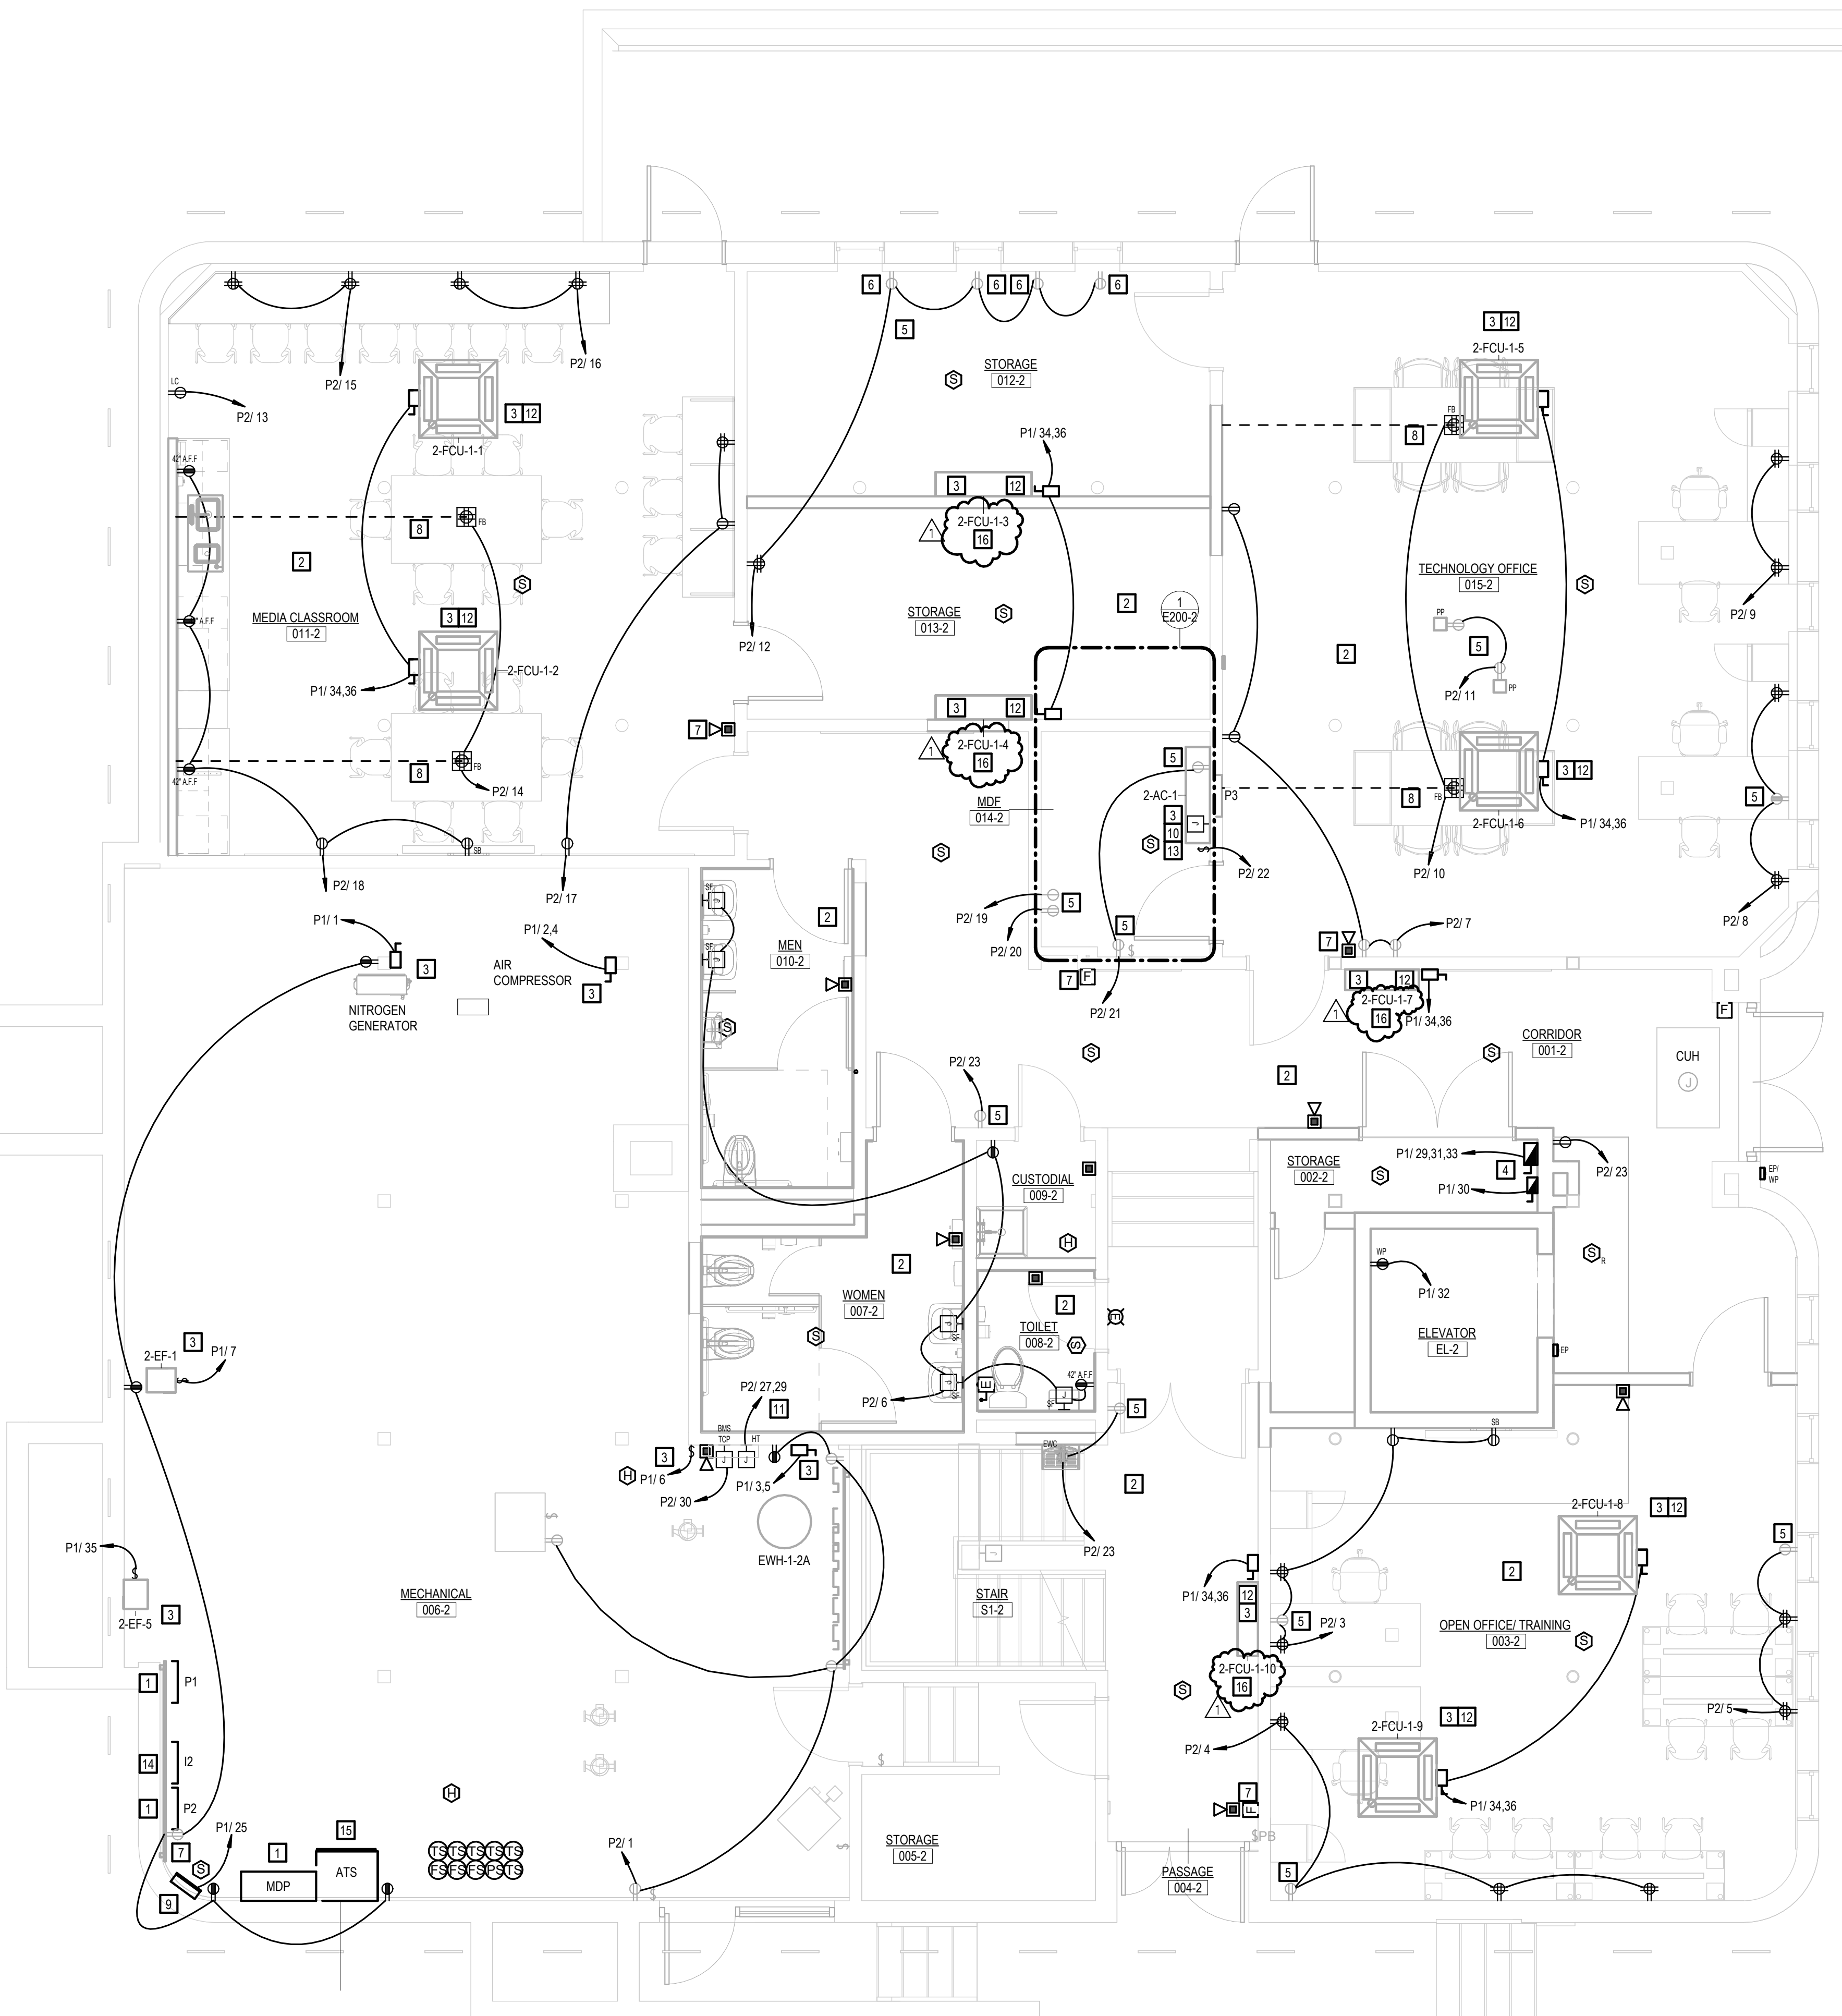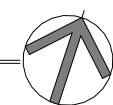1 MDF PART PLAN  
1/2" = 1'-0"2 LOWER LEVEL POWER PLAN PART A  
1/4" = 1'-0"KEY PLAN  
SCALE: NTS

Project Title:  
**ALTERATIONS TO:  
ACES at Chase**  
565 Chase Parkway  
Waterbury, Connecticut 06708

**SILVER PETRUCELLI + ASSOCIATES**

3190 WHITNEY AVENUE HAMDEN CT 06518  
311 STATE STREET NEW LONDON CT 06320  
203 230 9007 silverpetrucelli.com

Revision:	Description:	Date:	Revised By:
1	Bulletin #1	12/16/25	MTC

Drawing Title:  
**BUILDING 2 - LOWER LEVEL POWER  
PLAN PART A**  
Project Phase:  
**ISSUED FOR BID - 11/03/2025**  
State Project Number:  
**#244-0044 MAG**

Date:  
AUGUST 12, 2025  
Scale:  
As indicated  
Drawn By:  
MTC  
Project Number:  
22.050

**E200-2**


12/16/2025 10:23:17 AM

GENERAL POWER NOTES

- REFER TO DRAWING E001-2 FOR ELECTRICAL SYMBOLS AND ABBREVIATIONS.
- ALL NEW RECEPTACLES SHALL BE TAMPER-PROOF TYPE PER NEC 406.12 UNLESS LOCATED MORE THAN 5'-6" ABOVE THE FLOOR OR SERVE A DEDICATED PIECE OF EQUIPMENT THAT CAN NOT BE EASILY MOVED TO EXPOSE THE PLUG.
- ALL DEVICES (RECEPTACLES, FIRE ALARM, CALL FOR AID, ETC.), AND ELECTRICAL EQUIPMENT (PANELBOARDS, DISCONNECT SWITCHES, ETC.) SHOWN DARK AND SOLID ARE TO BE NEW UNLESS OTHERWISE NOTED. ALL DEVICES AND EQUIPMENT SHOWN HALF TONE (LIGHT) AND SOLID ARE EXISTING TO REMAIN UNLESS OTHERWISE NOTED.


POWER KEY NOTES

- PANELS SHOWN ARE TO HAVE EXISTING CIRCUITS REWORKED TO THEM WHICH ARE NOT BEING REMOVED. CONTRACTOR TO MAINTAIN ALL EXISTING ACTIVE BRANCH CIRCUITS, REBALANCE LOADS AND UPDATE PANEL DIRECTORIES TO REFLECT ALL CHANGES MADE TO THESE PANELS.
- ALL DEVICES WHICH ARE MOUNTED ON EXISTING WALLS SHALL BE SURFACE MOUNTED DEVICES. THE RACEWAY SERVING THESE SPACES SHALL BE WIREMOLD PAINTED TO MATCH THE WALL. THE RACEWAY SHALL COME FROM THE CEILING & CONNECT ALL DEVICES SHOWN ON THE CIRCUIT. EXPOSED CONDUIT IN FINISHED SPACES IS NOT ACCEPTABLE. COORDINATE WIRETECHNOLOGY TO INCLUDE DATA/VOICE JACKS IN WIREMOLD WHERE NECESSARY.
- EQUIPMENT SHOWN IS CONTROLLED VIA THE BUILDING MANAGEMENT SYSTEM. PROVIDE ALL NECESSARY WIRING BETWEEN THE CONTROLLER, EQUIPMENT, RELAYS, ETC. COORDINATE LOCATION OF POWER FOR EQUIPMENT SHOWN W/ASSOCIATED CONTRACTORS OF OTHER DISCIPLINES.
- INSTALL NEW SURFACE MOUNTED BOX EXTENSION WIRE RECEPTACLE TO EXISTING BACK BOX OF RECEPTACLE WHICH WAS REMOVED. INSTALL WIREMOLD TO INTERCONNECT THE DEVICES ON THE CIRCUIT SHOWN. COORDINATE WIRETECHNOLOGY TO INCLUDE DATA/VOICE JACKS IN WIREMOLD WHERE NECESSARY.
- INSTALL NEW SURFACE MOUNTED BOX EXTENSION WIRE FIRE ALARM DEVICE TO EXISTING BACK BOX OF FIRE ALARM DEVICE WHICH WAS REMOVED. INSTALL WIREMOLD TO INTERCONNECT DEVICE TO FIRE ALARM LOOP FOR THE AREA.
- RECEPTACLES SHOWN SHALL BE MOUNTED TO THE FURNITURE SHOWN FOR THE SPACE. POWER WILL COME FROM THE ASSOCIATED WALL OR VIA THE POKE THROUGH SHOWN. ALL SURFACE MOUNTED RECEPTACLES SHALL BE RUN IN WIREMOLD PAINTED TO MATCH THE SURFACE IT IS MOUNTED TO. COORDINATE WIRETECHNOLOGY TO INCLUDE DATA/VOICE JACKS IN WIREMOLD WHERE NECESSARY.
- FURNISH AND INSTALL NEW SURFACE MOUNTED ELECTRICAL PANEL TO EXISTING RECESSED PANEL BACK BOX. DO EVERYTHING NECESSARY DURING CONSTRUCTION TO MAINTAIN THE BACK BOX & CIRCUITS THAT WILL NEED TO BE EXTENDED INTO NEW PANEL. REFER TO ONE LINE DIAGRAM DRAWINGS E300-2 AND PANEL SCHEDULES ON E500 SERIES DRAWINGS FOR NEW WORK REQUIREMENTS.
- FAN COIL UNITS SHOWN WILL HAVE A HARD WIRED INTERNAL CONDENSATE PUMP. PROVIDE WIRING FOR PUMP. COORDINATE W/MECHANICAL CONTRACTOR.
- INSTALL NEW POWERED DOOR OPENERS AT THE DOOR SHOWN. INSTALL A TOGGLE DISCONNECT SWITCH AT THE MOTOR. INSTALL PUSH PLATE DOOR OPERATORS AT THE LOCATIONS SHOWN. COORDINATE W/ARCHITECT FOR EXACT LOCATIONS. PROVIDE ALL WIRING, CONDUIT, EQUIPMENT NECESSARY FOR A COMPLETE & WORKING INSTALLATION. ANY DEVICES WHICH ARE MOUNTED ON AN EXISTING WALL OR MULLION SHALL HAVE WIREMOLD PAINTED THE SAME COLOR AS THE WALL OR MULLION IT IS INSTALLED ON. POWER FOR CIRCUIT IS ASSUMED FOR A 1/2 HP MOTOR. IF THE MOTOR IS LARGER THE CIRCUIT BREAKER SERVING IT WILL NEED TO BE INCREASED, AS WELL AS THE WIRE SIZE.
- CONDENSATE PUMP FOR BCC'S & WALL MOUNTED FCU'S NEED WIRING/POWER PROVIDED TO THEM. CONDENSATE PUMP POWER SHALL COME FROM THE UNIT IT IS SERVING. DISCONNECT SWITCH WIRINGS SHALL BE CONNECTED TO THE UNIT SAFETY CONNECTORS. WIRING SHALL BE FIELD SUPPLIED & SHALL BE IN ACCORDANCE W/MANUFACTURERS REQUIREMENTS. REFER TO MECHANICAL DRAWINGS FOR MORE INFORMATION.

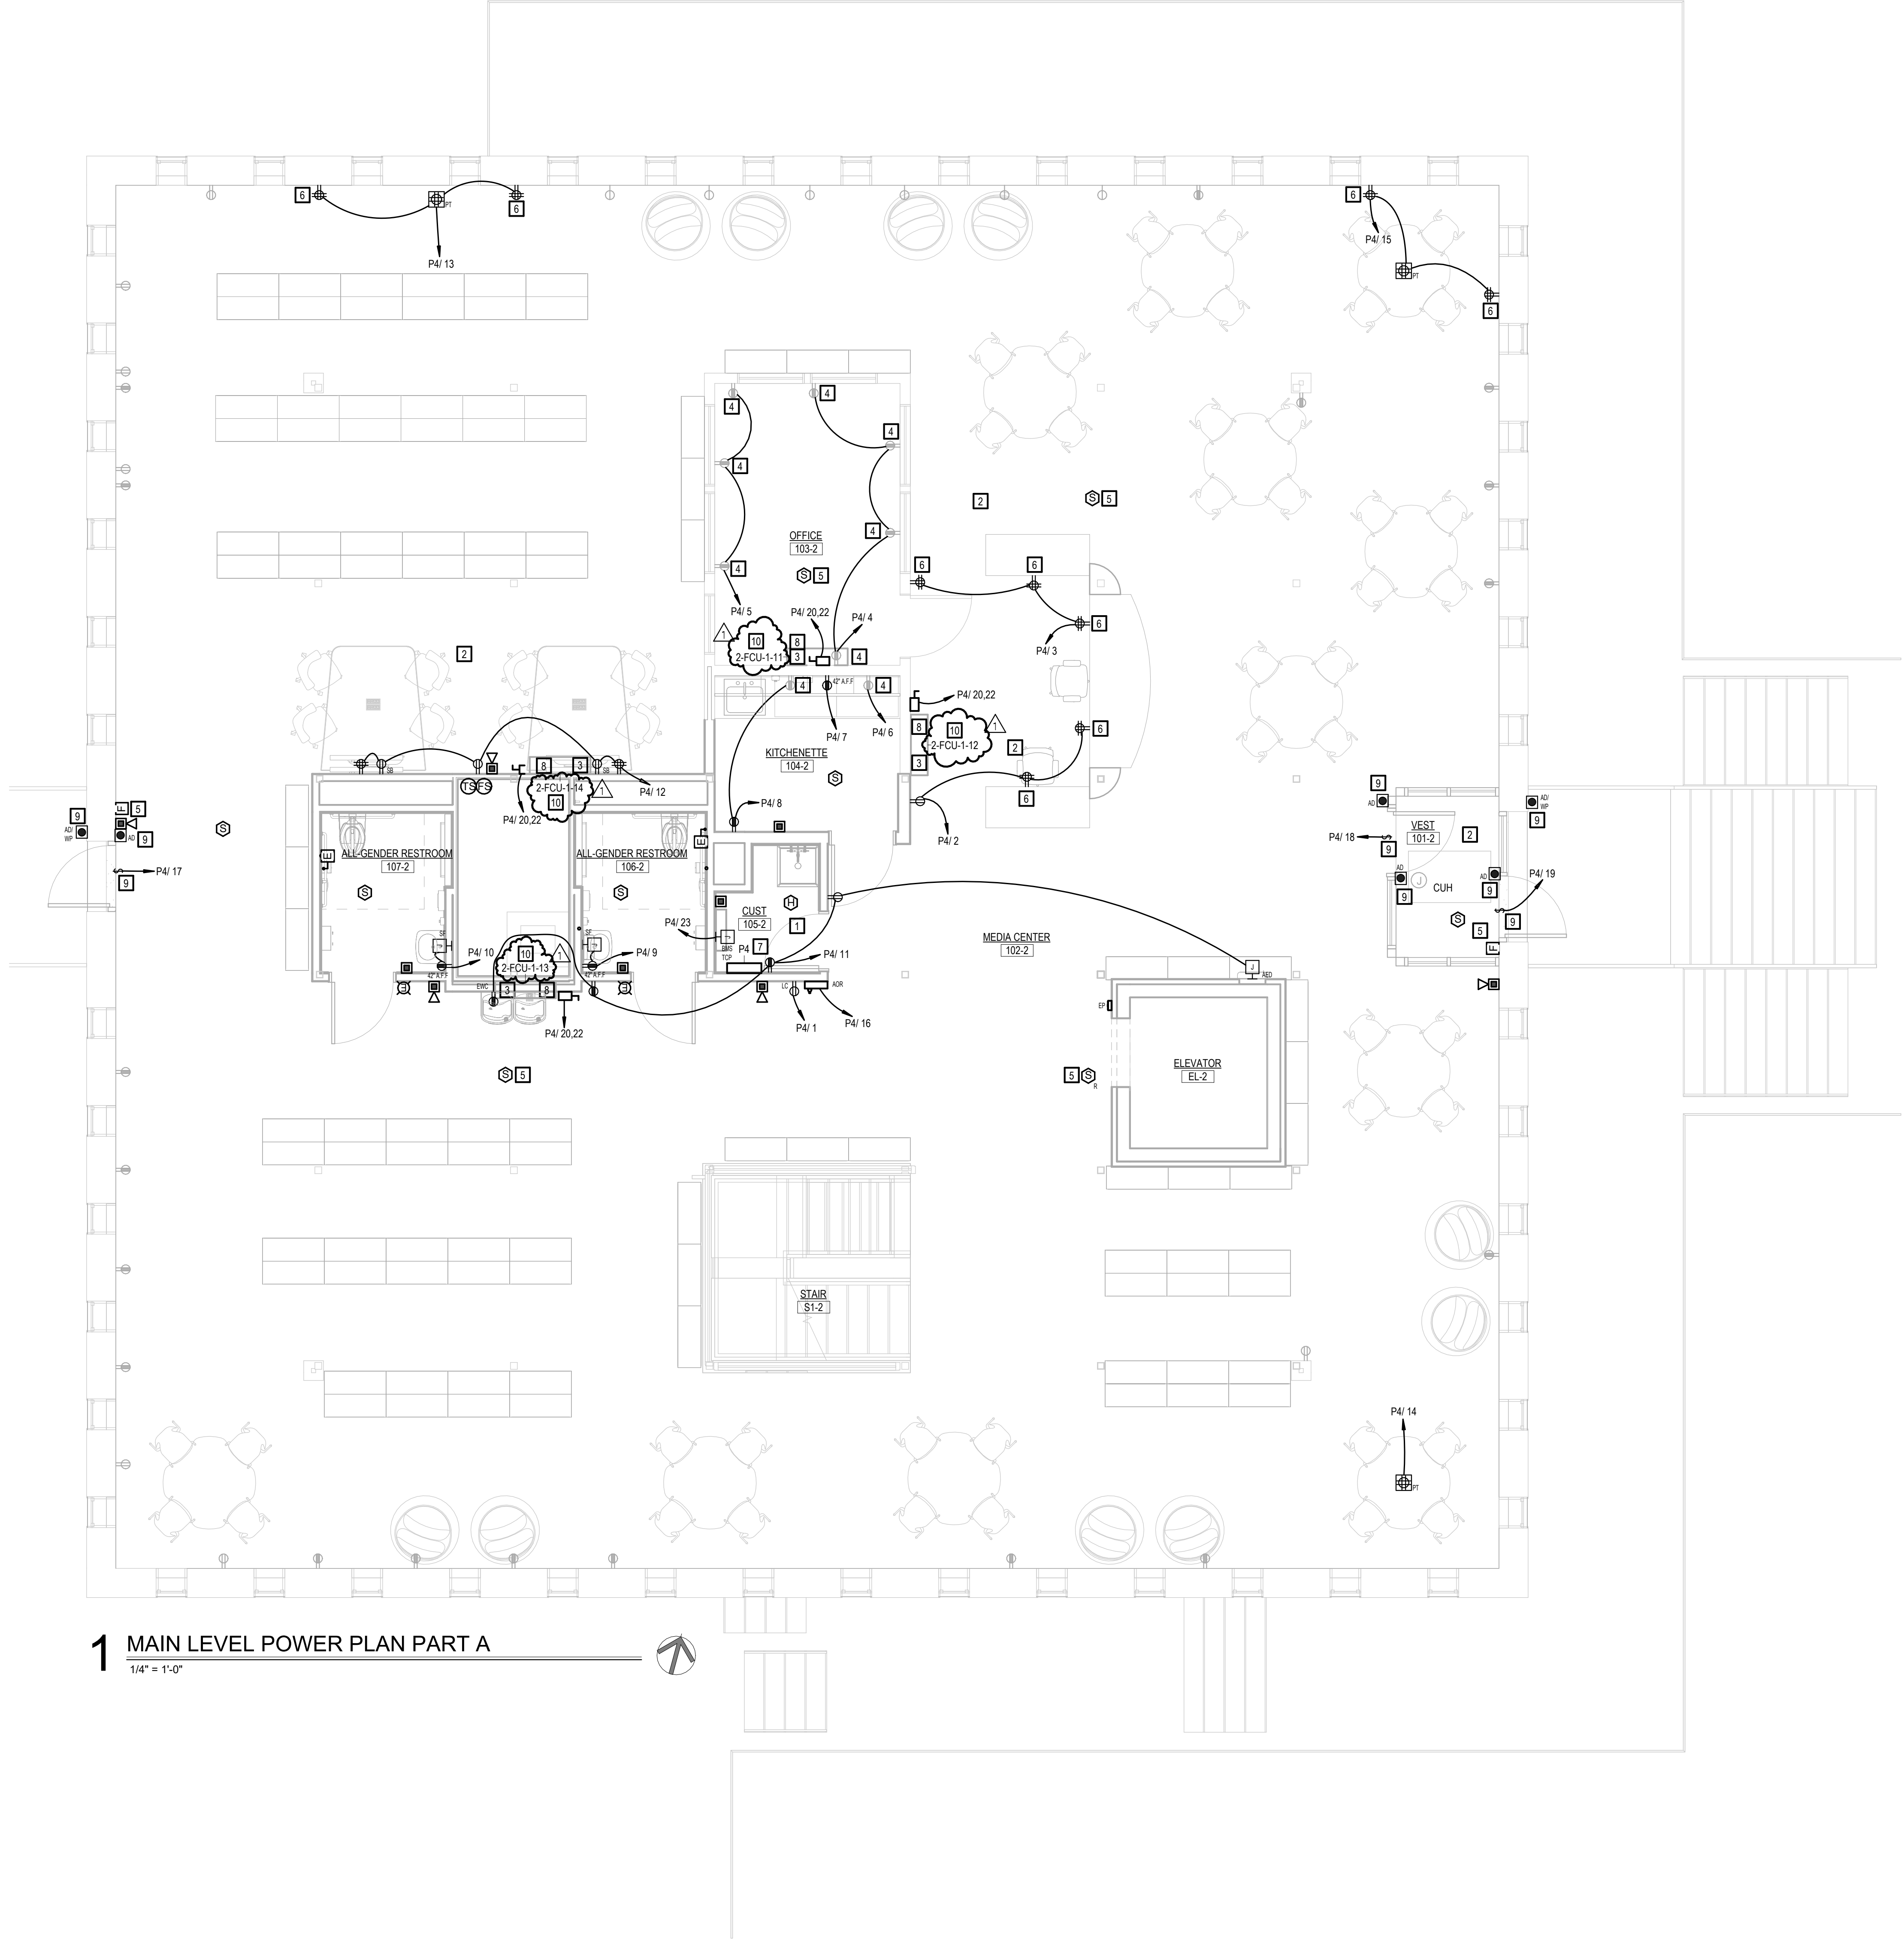

1 MAIN LEVEL POWER PLAN PART A  
1/4" = 1'-0"

KEY PLAN  
SCALE: NTS

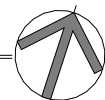

Project Title:  
**ALTERATIONS TO:  
ACES at Chase**  
565 Chase Parkway  
Waterbury, Connecticut 06708



SILVER PETRUCCELLI + ASSOCIATES

3190 WHITNEY AVENUE HAMDEN CT 06518  
311 STATE STREET NEW LONDON CT 06320  
203 230 9007 silverpetrucci.com

Revision:	Description:	Date:	Revised By:
1	Bulletin #1	12/16/25	MTC

Drawing Title:  
**BUILDING 2 - MAIN LEVEL POWER PLAN  
PART A**  
Project Phase:  
**ISSUED FOR BID - 11/03/2025**  
State Project Number:  
**#244-0044 MAG**

Date:  
AUGUST 12, 2025  
Scale:  
As indicated  
Drawn By:  
MTC  
Project Number:  
22.050

E210-2

12/16/2025 10:23:19 AM




GENERAL POWER NOTES

- REFER TO DRAWING E001-2 FOR ELECTRICAL SYMBOLS AND ABBREVIATIONS.
- ALL NEW RECEPTACLES SHALL BE TAMPER-PROOF TYPE PER NEC 406.12 UNLESS LOCATED MORE THAN 5'-6" ABOVE THE FLOOR OR SERVE A DEDICATED PIECE OF EQUIPMENT THAT CAN NOT BE EASILY MOVED TO EXPOSE THE PLUG.
- ALL DEVICES (RECEPTACLES, FIRE ALARM, CALL FOR AID, ETC.), AND ELECTRICAL EQUIPMENT (PANELBOARDS, DISCONNECT SWITCHES, ETC.) SHOWN DARK AND SOLID ARE TO BE NEW UNLESS OTHERWISE NOTED. ALL DEVICES AND EQUIPMENT SHOWN HALF TONE (LIGHT) AND SOLID ARE EXISTING TO REMAIN UNLESS OTHERWISE NOTED.


POWER KEY NOTES

- ALL DEVICES WHICH ARE MOUNTED ON EXISTING WALLS SHALL BE SURFACE MOUNTED DEVICES. THE RACEWAY SERVING THESE SPACES SHALL BE WIREMOLD PAINTED TO MATCH THE WALL. THE RACEWAY SHALL COME FROM THE CEILING & CONNECT ALL DEVICES SHOWN ON THE CIRCUIT. EXPOSED CONDUIT IN FINISHED SPACES IS NOT ACCEPTABLE. COORDINATE WIRETECHNOLOGY TO INCLUDE DATA/VOICE JACKS IN WIREMOLD WHERE NECESSARY.
- EQUIPMENT SHOWN IS CONTROLLED VIA THE BUILDING MANAGEMENT SYSTEM. PROVIDE ALL NECESSARY WIRING BETWEEN THE CONTROLLER, EQUIPMENT, RELAYS, ETC. COORDINATE LOCATION OF POWER FOR EQUIPMENT SHOWN WITH ASSOCIATED CONTRACTORS OF OTHER DISCIPLINES.
- DUCT SMOKE DETECTORS FOR DOAS. PROVIDE & INSTALL 1 FOR SUPPLY & 1 FOR RETURN. DETECTOR SHALL BE COMPATIBLE WITH FACP. COORDINATE EXACT LOCATIONS IN FIELD.
- INSTALL NEW RECEPTACLE IN EXISTING BACK BOX OF RECEPTACLE WHICH WAS REMOVED. FISH WIRE TO DEVICE & WIRE IT TO DEVICES ON CIRCUIT AS SHOWN.
- EXISTING SURFACE MOUNTED RECEPTACLE. INSTALL WIREMOLD TO INTERCONNECT DEVICES AS SHOWN & TO ACCESSIBLE CEILING SPACE. MINIMIZE AMOUNT OF WIREMOLD USED AS POSSIBLE. WIREMOLD SHALL BE PAINTED TO MATCH COLOR OF WALL INSTALLED ON.
- INSTALL NEW FIRE ALARM DEVICE IN EXISTING BACK BOX OF DEVICE WHICH WAS REMOVED. FISH WIRE TO DEVICE THROUGH EXISTING RACEWAY & INTERCONNECT DEVICE TO FIRE ALARM LOOP FOR THE AREA.
- FAN COIL UNITS SHOWN WILL HAVE A HARD WIRED INTERNAL CONDENSATE PUMP. PROVIDE WIRING FOR PUMP. COORDINATE WIREMECHANICAL CONTRACTOR.
- VRF HEAT RECOVERY BRANCH CIRCUIT CONTROLLER SHOWN WILL HAVE A HARD WIRED INTERNAL CONDENSATE PUMP. PROVIDE WIRING FOR PUMP. COORDINATE WIREMECHANICAL CONTRACTOR.
- FLOOR BOXES SHOWN ARE FOR POWER FEEDS TO THE FURNITURE THEY ARE SHOWN NEXT TO. FEED TO TABLES SHOULD BE A WHIP. COORDINATE WIFURNITURE VENDOR ON THE EXACT LOCATION THE FLOOR BOXES SHOULD BE INSTALLED. DON'T TRENCH OR INSTALL PRIOR TO CONFIRMING. COORDINATE WIRETECHNOLOGY TO INCLUDE DATA/VOICE JACKS IN FLOOR BOX WHERE NECESSARY.
- PROPOSED CONDUIT PATH FOR FLOOR BOXES. FLOOR MUST BE TRENCHED TO LOCATIONS SHOWN. COORDINATE WITH ARCHITECTURAL DRAWINGS. ANY PATHWAY WHICH IS TO BE LOCATED ON AN EXISTING WALL SHALL BE WIREMOLD, PAINTED TO MATCH COLOR OF WALL.
- FURNISH AND INSTALL ELECTRICAL PANEL. REFER TO ONE LINE DIAGRAM DRAWING E300-2 AND PANEL SCHEDULES ON E300 SERIES DRAWINGS FOR NEW WORK REQUIREMENTS.
- CONDENSATE PUMP FOR BCC'S & WALL MOUNTED FCU'S NEED WIRING POWER PROVIDED TO THEM. CONDENSATE PUMP POWER SHALL COME FROM THE UNIT IT IS SERVING. DISCONNECT SWITCH WIRING SHALL BE CONNECTED TO THE UNIT SAFETY CONNECTORS. WIRING SHALL BE FIELD SUPPLIED & SHALL BE IN ACCORDANCE WITH MANUFACTURERS REQUIREMENTS. REFER TO MECHANICAL DRAWINGS FOR MORE INFORMATION.

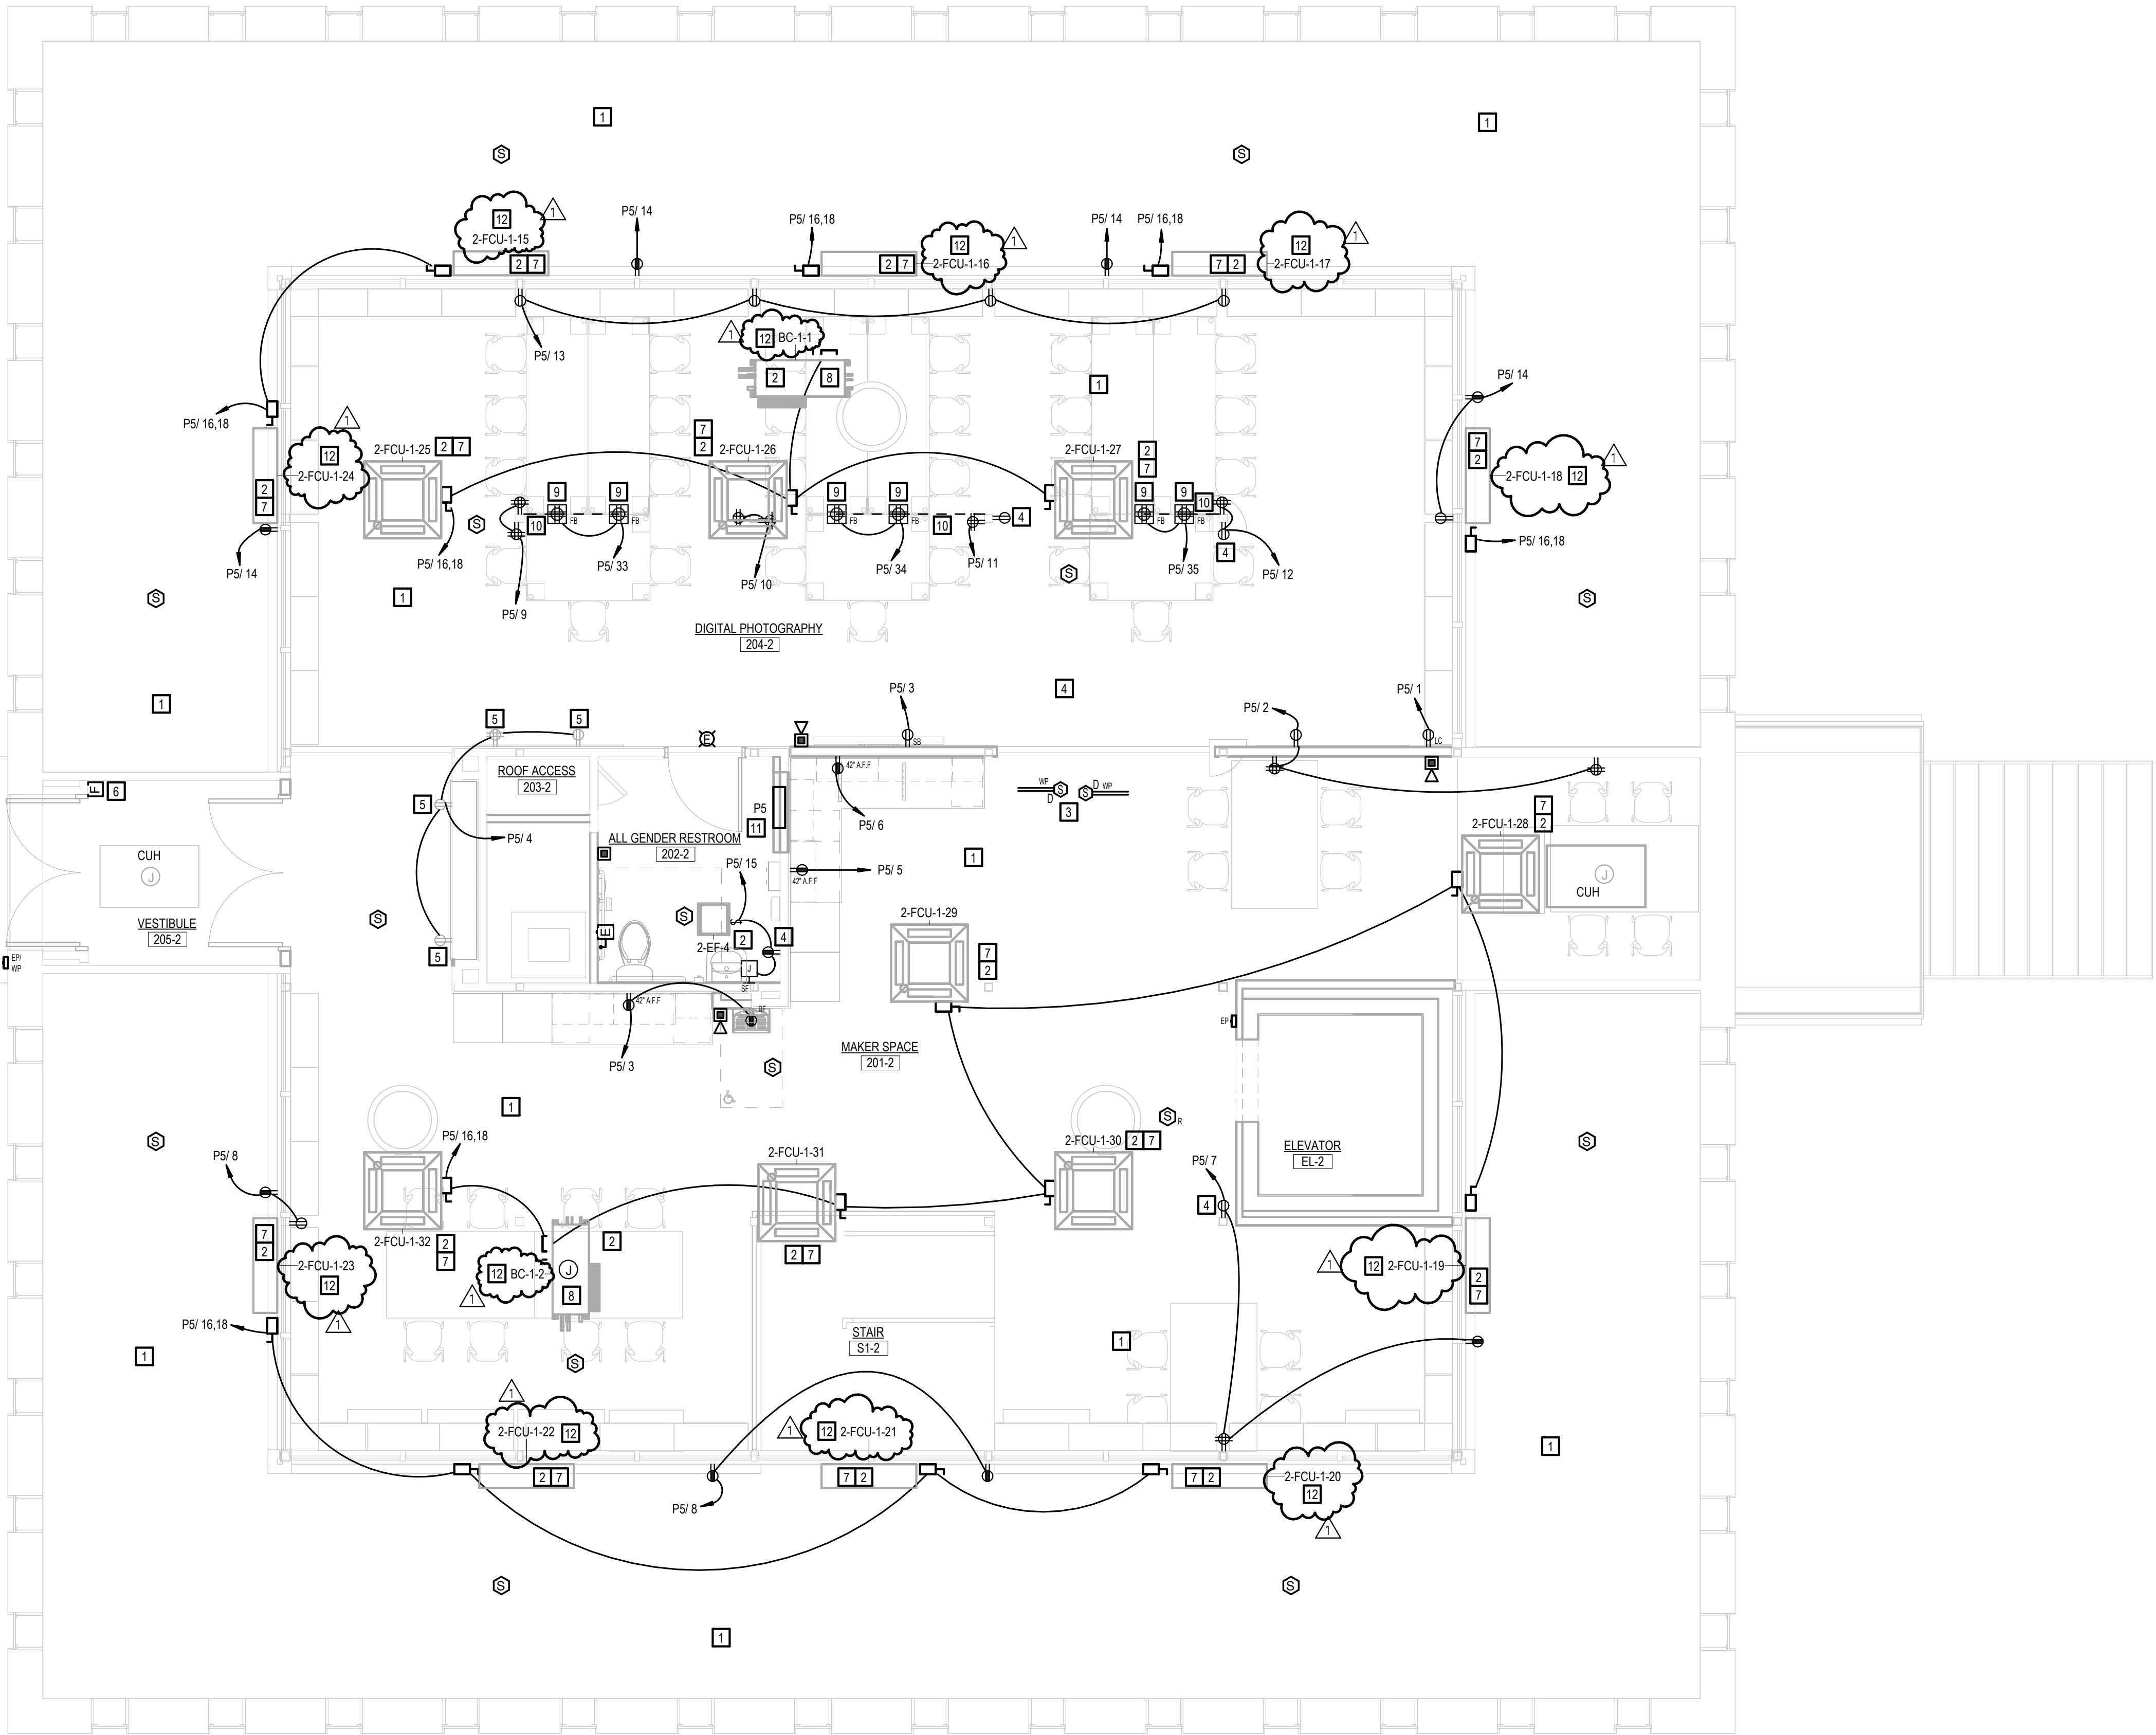


1 MEZZANINE LEVEL POWER PLAN PART A

1/4" = 1'-0"

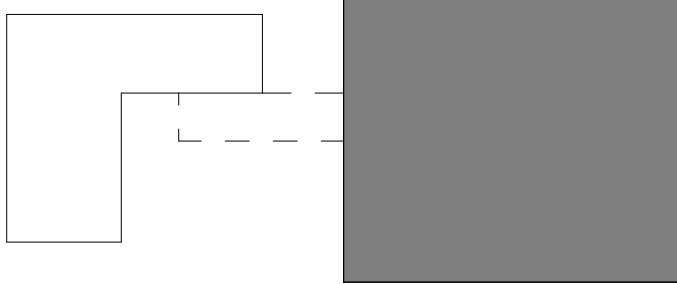

KEY PLAN  
SCALE: NTS

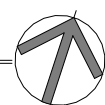

Project Title:  
**ALTERATIONS TO:  
ACES at Chase**  
565 Chase Parkway  
Waterbury, Connecticut 06708



**SILVER PETRUCCELLI + ASSOCIATES**

3190 WHITNEY AVENUE HAMDEN CT 06518  
311 STATE STREET NEW LONDON CT 06320  
203 230 9007 silverpetrucci.com


Revision:	Description:	Date:	Revised By:
1	Bulletin #1	12/16/25	MTC

Drawing Title:  
**BUILDING 2 - MEZZANINE LEVEL  
POWER PLAN PART A**  
Project Phase:  
**ISSUED FOR BID - 11/03/2025**  
State Project Number:  
**#244-0044 MAG**

Date:  
AUGUST 12, 2025  
Scale:  
As indicated  
Drawn By:  
MTC  
Project Number:  
22.050

**E220-2**

12/16/2025 10:23:20 AM

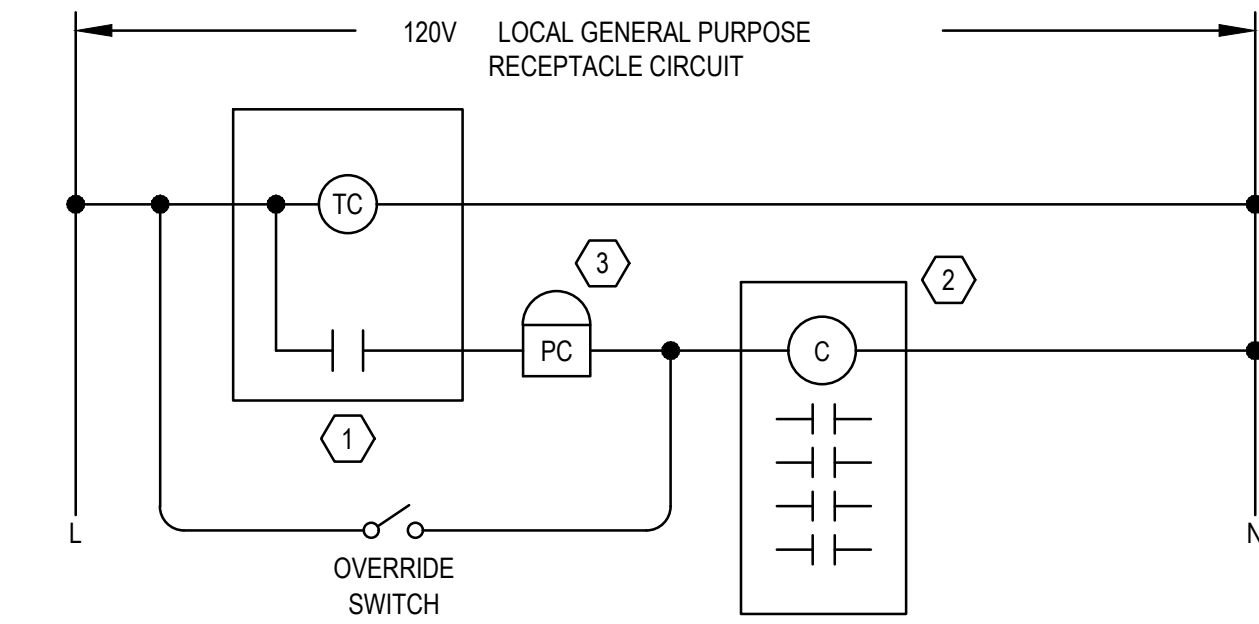


LOCATED ADJACENT TO TIME CLOCK  
#POLES: 8  
CIRCUIT#: REFER TO ELECTRICAL SITE PLAN SHEET E400

CONTACTOR SCHEDULE				
TAG	DESCRIPTION	MODEL NO.	REMARKS	
1	DIGITAL PROGRAMMABLE TIME CLOCK 24HR. 7DAY 365DAY. SEASONAL SCHEDULING. 99 ON/OFF POINTS. PERMANENT SCHEDULE RETENTION ON POWER LOSS. POWER OUTAGE BACKUP. AUTOMATIC LEAP YEAR AND DAYLIGHT SAVINGS TIME ADJ. MECHANICALLY HELED CONTACTS. MULTI VOLTAGE INPUT.	TORK D2S200A OR EQUIVALENT INTERMATIC OR SQUARE D	124	
2	CONTACTOR ELECTRICALLY OPERATED. MECHANICALLY HELED. 20A LIGHTING CONTACTOR. CONTROL VOLTAGE AS LISTED, FROM LOCAL GENERAL PURPOSE RECEPTACLE CIRCUIT.	ASCO 917 SERIES WITH 2 WIRE CONTROL OPTION OR EQUIVALENT GE OR SQUARE D		
3	PHOTOCELL 180W. 15A. 40 DEG. TO 140 DEG. SOLID STATE SPST DRY CONTACT. LIGHT LEVEL RANGE 1.5 TO 100C WITH ADJUSTMENT. TIME DELAY IS SEC. MINIMUM	TORK 2100 SERIES OR EQUIVALENT INTERMATIC OR SQUARE D	3	
NOTES: 1. TIMECLOCK SHALL BE PROGRAMMED TO TURN SITE LIGHTING ON AT DUSK (VIA PHOTOCELL) AND OFF WHENEVER THE OWNER WOULD LIKE IT OFF. 2. LOCATE TIME CLOCK ADJACENT TO ELECTRICAL PANEL. 3. PHOTOCELL TO BE LOCATED ON SOUTHERN EXPOSURE. 4. PROVIDE BACNET CAPABILITY TO TIE INTO BMS & ACCESS CONTROLS REMOTELY.				


## 1 LIGHTING TIME CLOCK & CONTACTOR DETAIL

SCALE: NONE

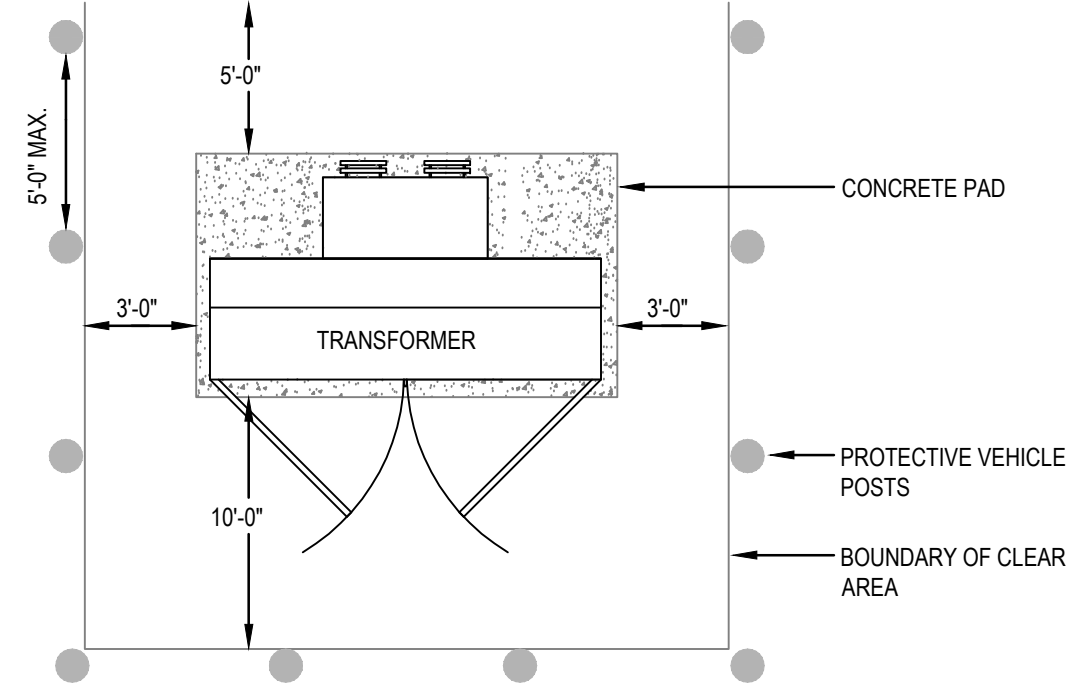

## 2 TYPICAL PAD MOUNTED TRANSFORMER

SCALE: NONE

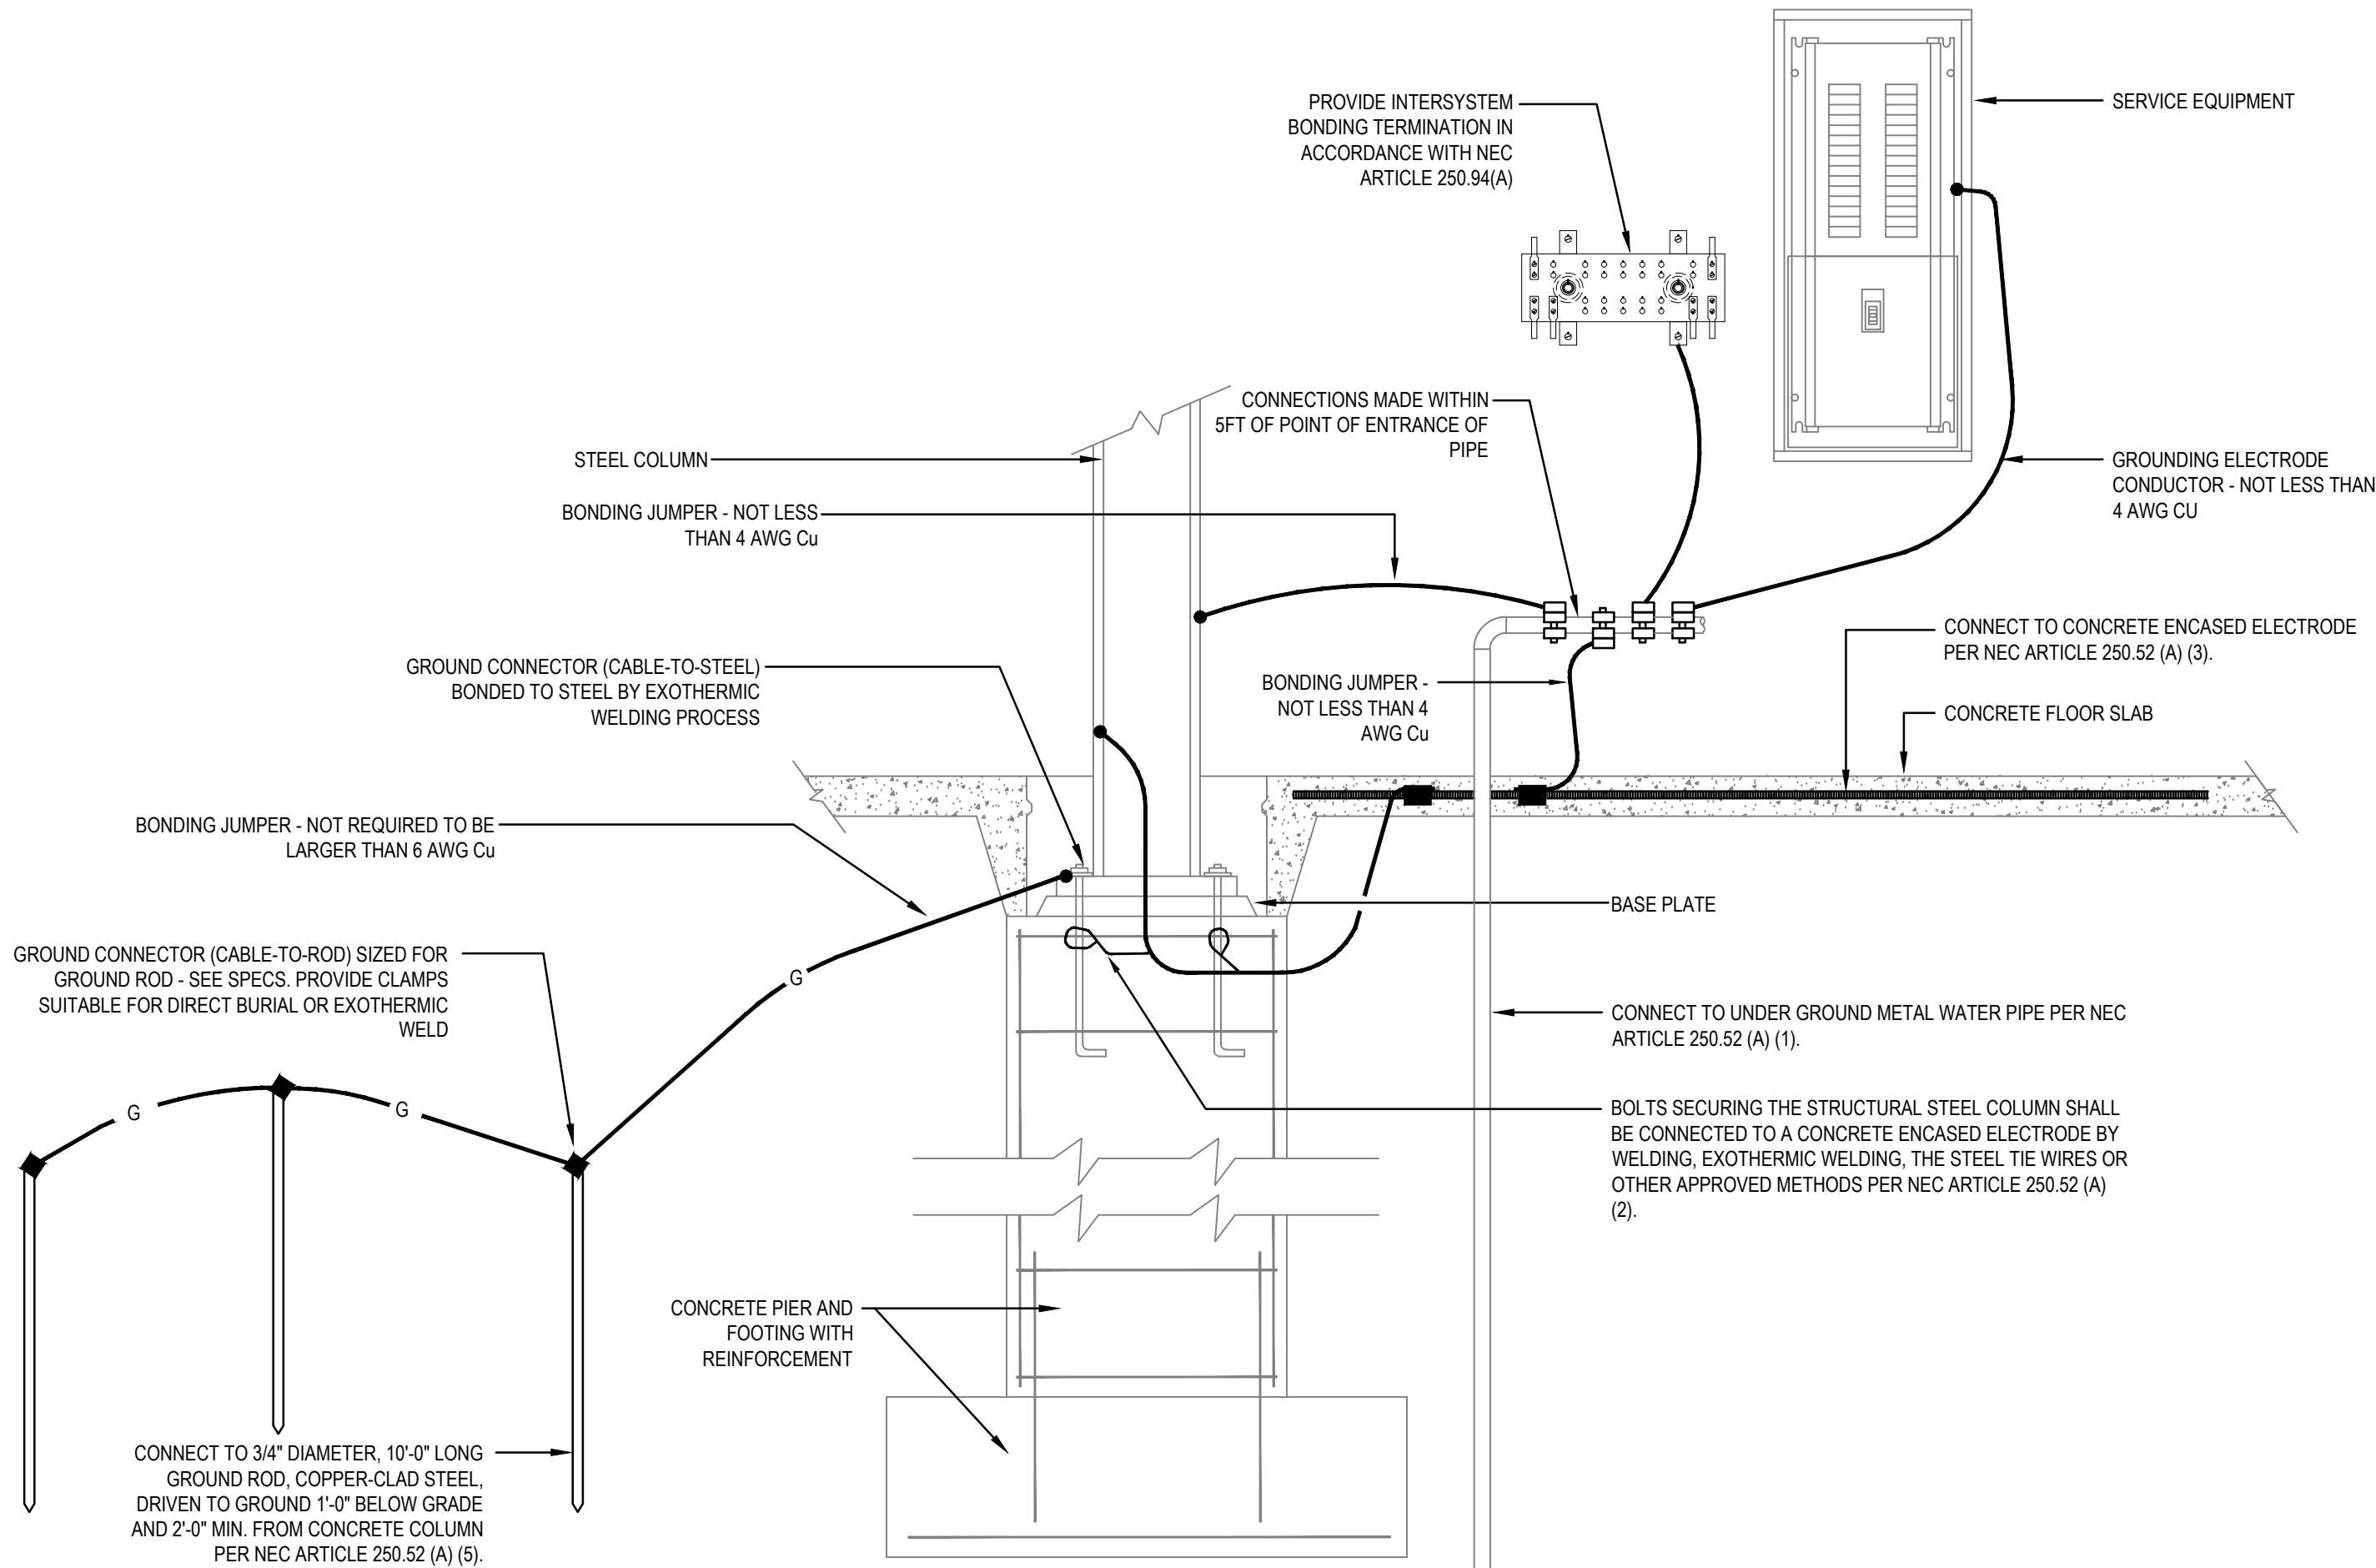


### GENERAL NOTES:

1. PROVIDE GROUNDING ELECTRODE SYSTEM PER NEC ARTICLE 250.50. ALL GROUNDING ELECTRODES AS DESCRIBED IN 250.52 (A) (1) THROUGH (A) (7) THAT ARE PRESENT AT EACH BUILDING OR STRUCTURE SERVED SHALL BE BONDED TOGETHER TO FORM THE GROUNDING ELECTRODE SYSTEM.


## 3 TYPICAL GROUNDING DETAIL

SCALE: NONE

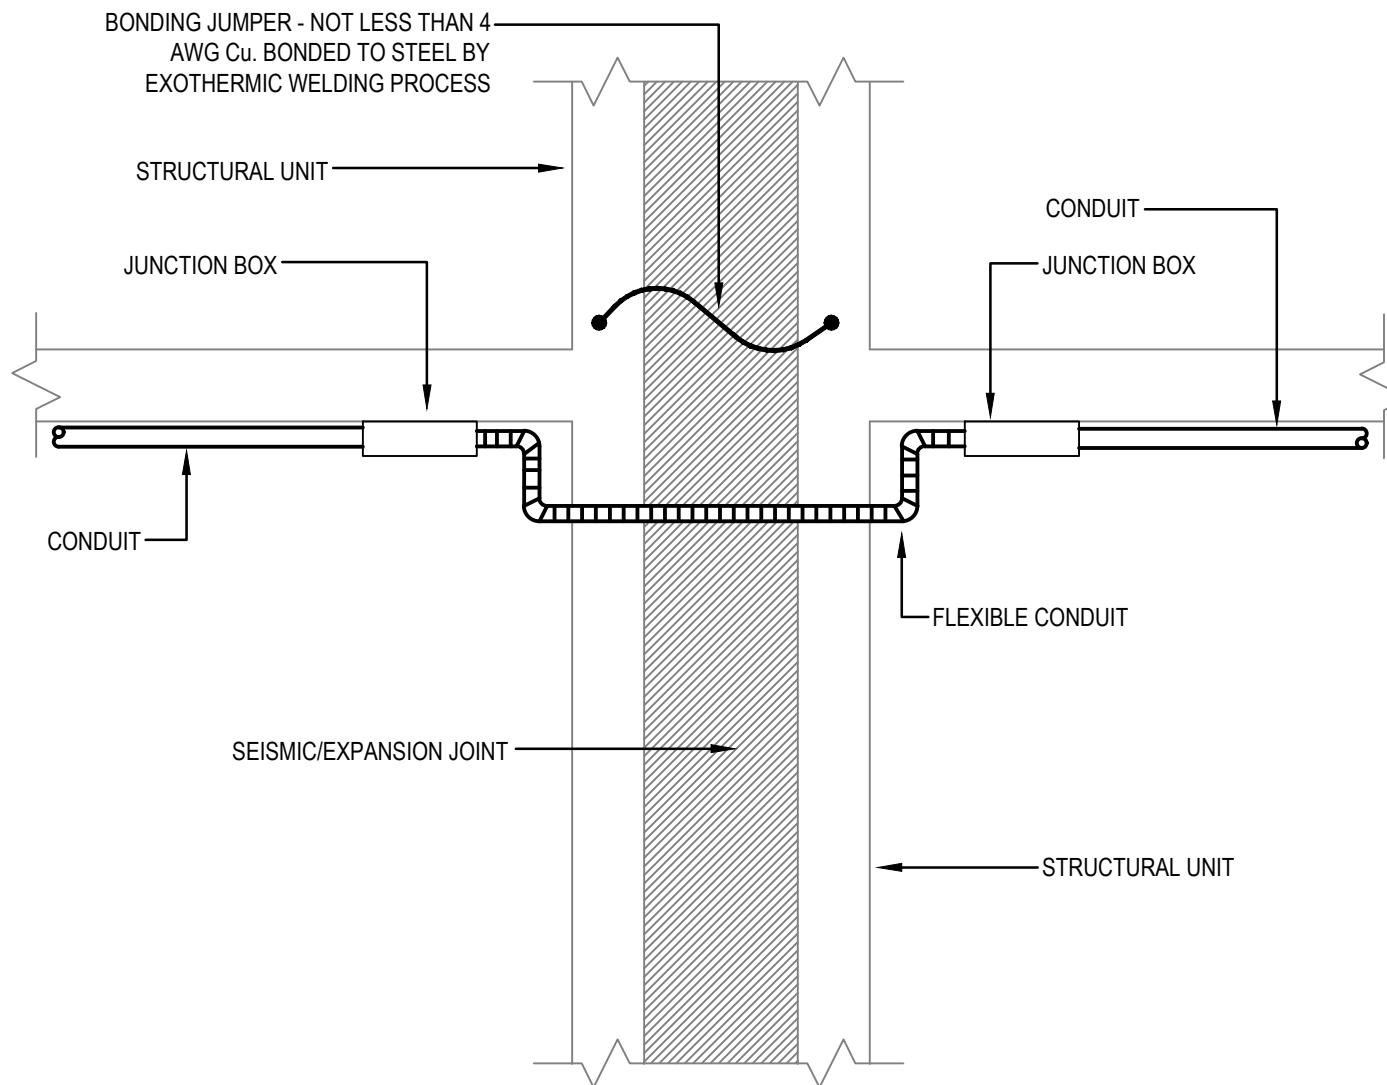

## 4 EXPANSION/SEISMIC JOINT FITTING DETAIL

SCALE: NONE

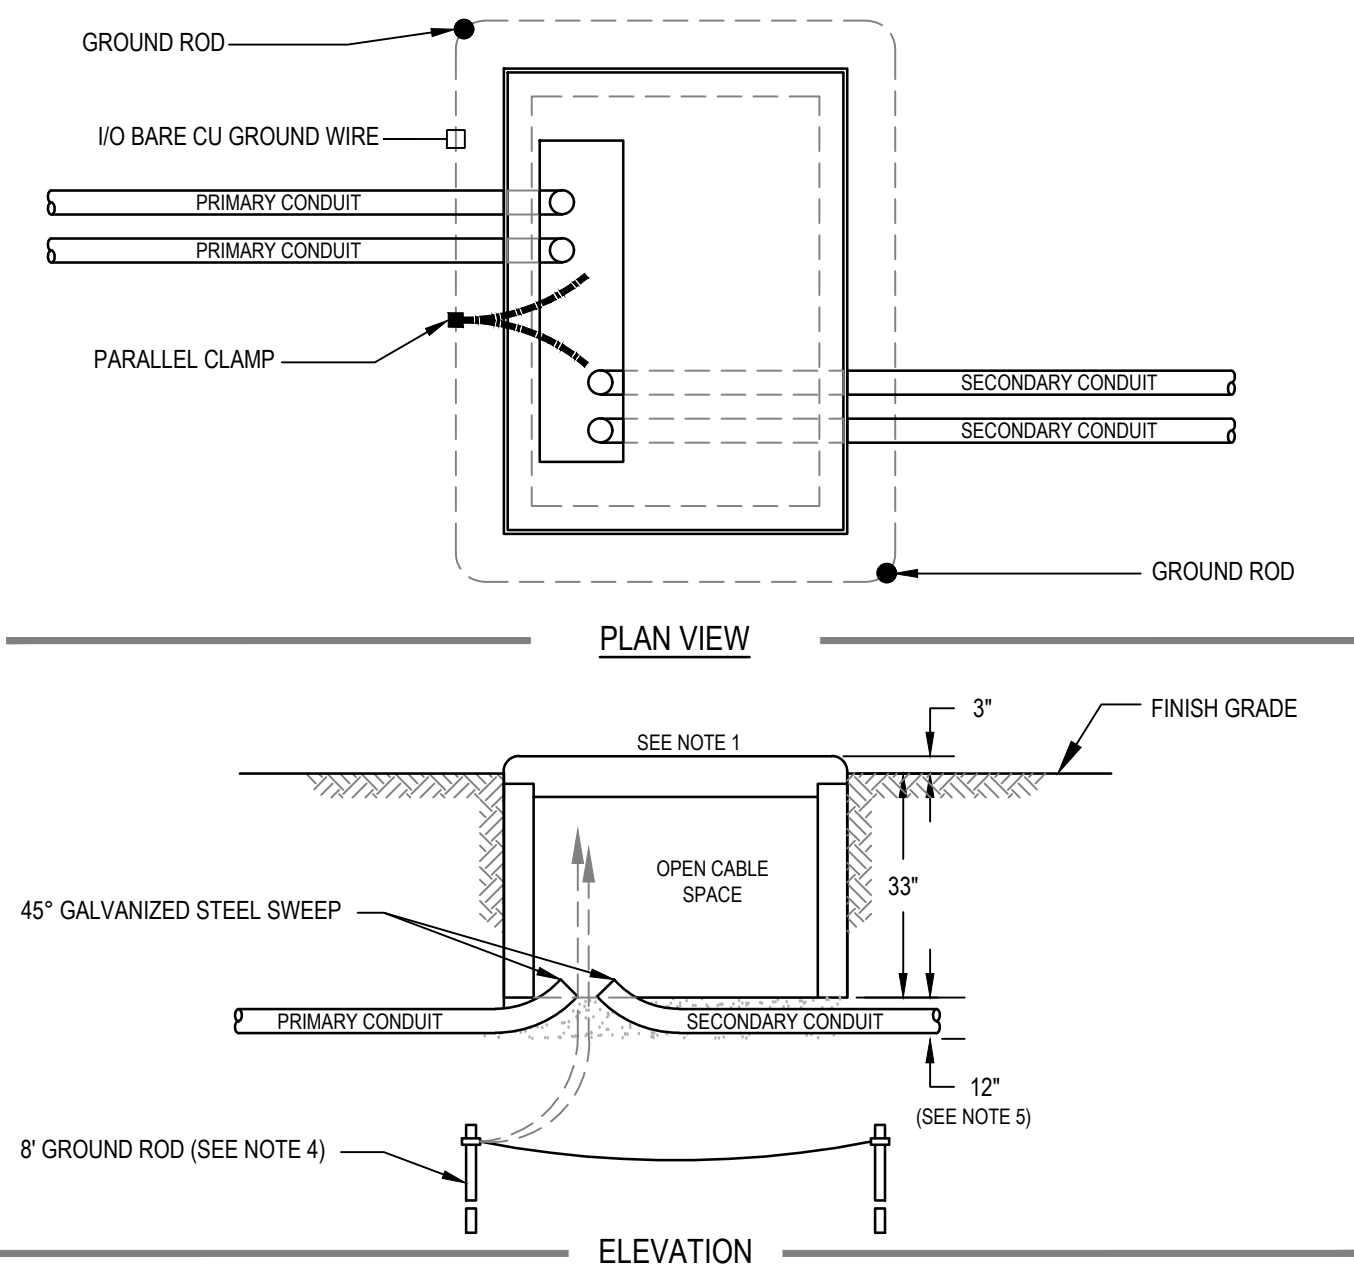

### NOTES:


1. 75-300 KVA: INSTALL 76" X 54" X 36" PAD PER SPC P-05, P-06.  
500-1500 KVA: INSTALL 76" X 70" X 36" PAD PER SPC P-07, P-08.
  2. PRIMARY CABLE:  
A. INSTALL CABLES IN CONDUIT A MINIMUM OF 30" BELOW GRADE.  
B. LOOP CABLES IN CABLE VAULT BEFORE MAKING CONNECTIONS.
  3. SECONDARY CABLE:  
LEAVE SLACK FOR FUTURE RECONNECTING TO TRANSFORMERS WITH HIGHER SECONDARY TERMINALS.
  4. COPPERWELD GROUND RODS: INSTALL IN TRENCH
- AND CONNECT A BARE I/O COPPER CONDUCTOR FROM RODS THROUGH PAD OPENING AND EXTENDING 5'-FT. ABOVE PAD.
5. THE EXCAVATION FOR THE PAD SHALL BE CARRIED TO A DEPTH OF 12" BELOW THE BOTTOM OF THE PAD WALLS. THE BACKFILL UNDER THE PAD WALLS SHALL BE A CLEAN GRAVEL, FREE OF FOREIGN MATTER AND CONSTRUCTION DEBRIS, AND IN ACCORDANCE WITH CONN. D.O.T. SPEC. M.02.06 GRADING "A". BACKFILL SHALL BE PLACED IN 6" LAYERS AND COMPACTED WITH MECHANICAL TAMPERS TO NOT LESS THAN 95% OF THE MAXIMUM DRY DENSITY AS DETERMINED BY STANDARD COMPACTION TESTS, AASHTO T180 OR ASTM D698.

## 5 PRECAST CONCRETE TRANSFORMER PAD DETAIL

SCALE: NONE


### GENERAL NOTES:

- PROVIDE UL LISTED FIRE/SMOKE PENETRATION ASSEMBLY IN ACCORDANCE W/ UL1479, ASTM E814 REQUIREMENTS FOR WALL TYPE, RATING, PIPE SIZE. INSTALLED.
- FIRE STOPPING SHALL HAVE A RATING EQUAL TO OR GREATER THAN THE WALL BEING PENETRATED - SEE SPECIFICATIONS. REFER TO ARCHITECTURAL DRAWINGS FOR WALL RATINGS AND LOCATIONS.

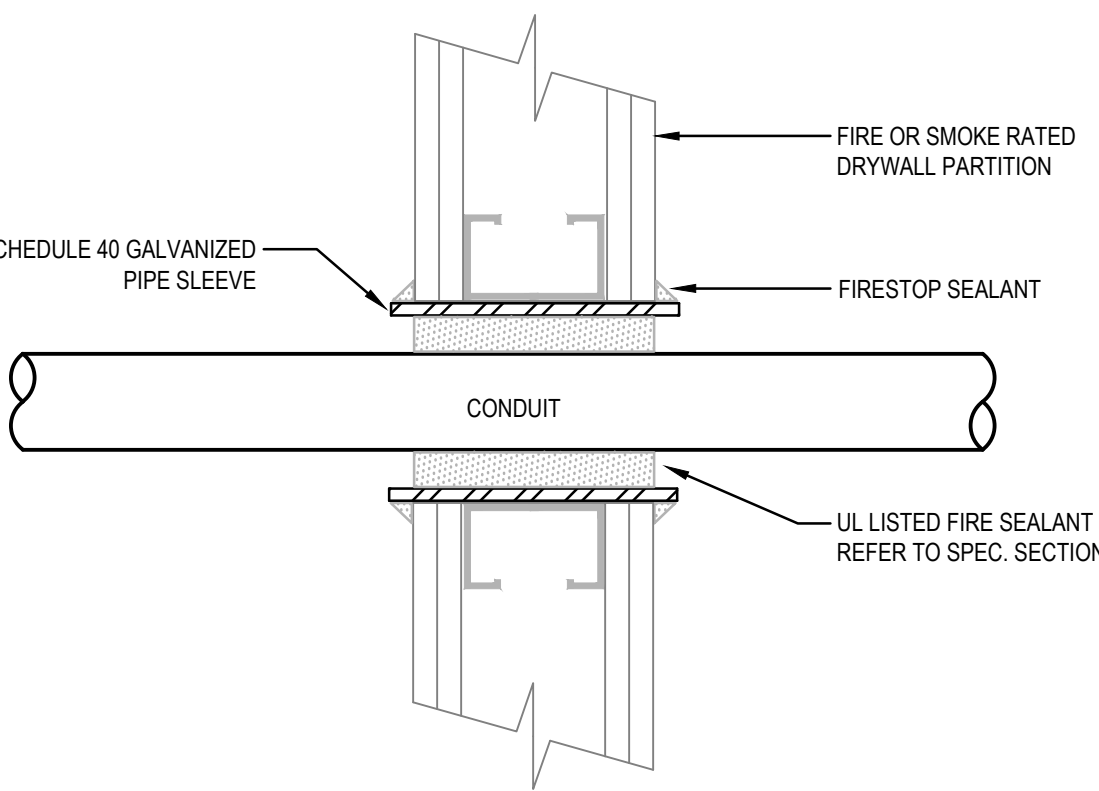


## 6 WALL PENETRATION W/FIRE-SMOKE SEAL DETAIL

SCALE: NONE

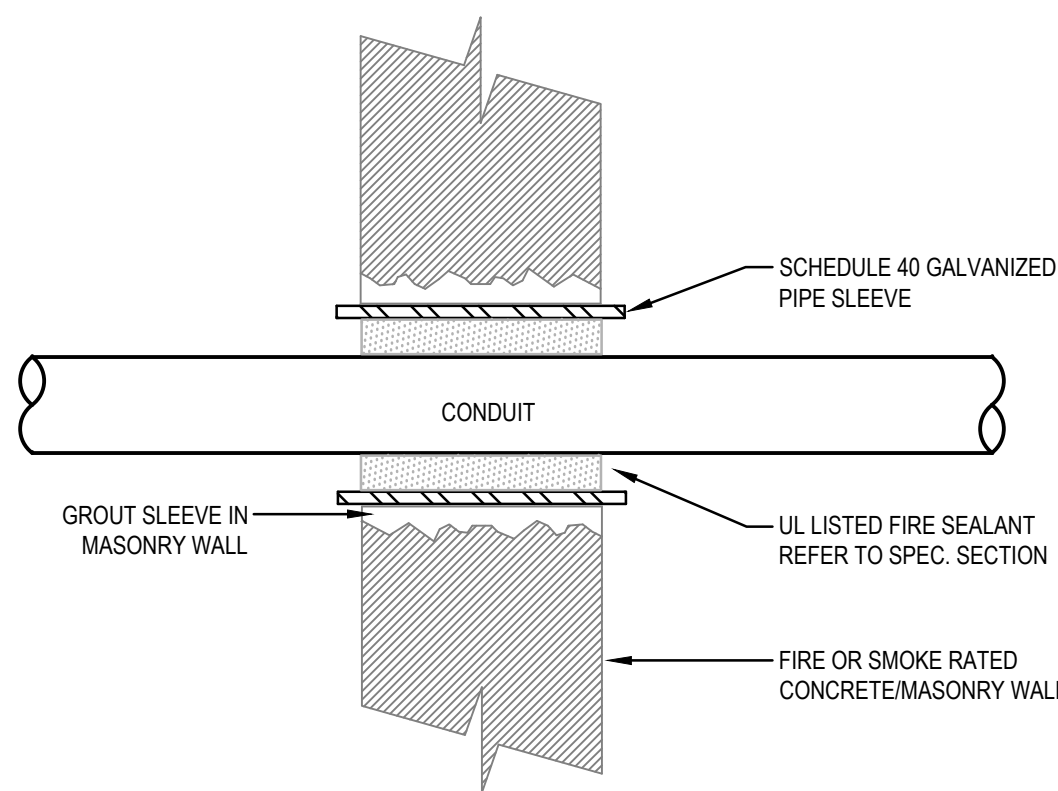

## 7 WATER-TIGHT WALL SLEEVE

SCALE: NONE

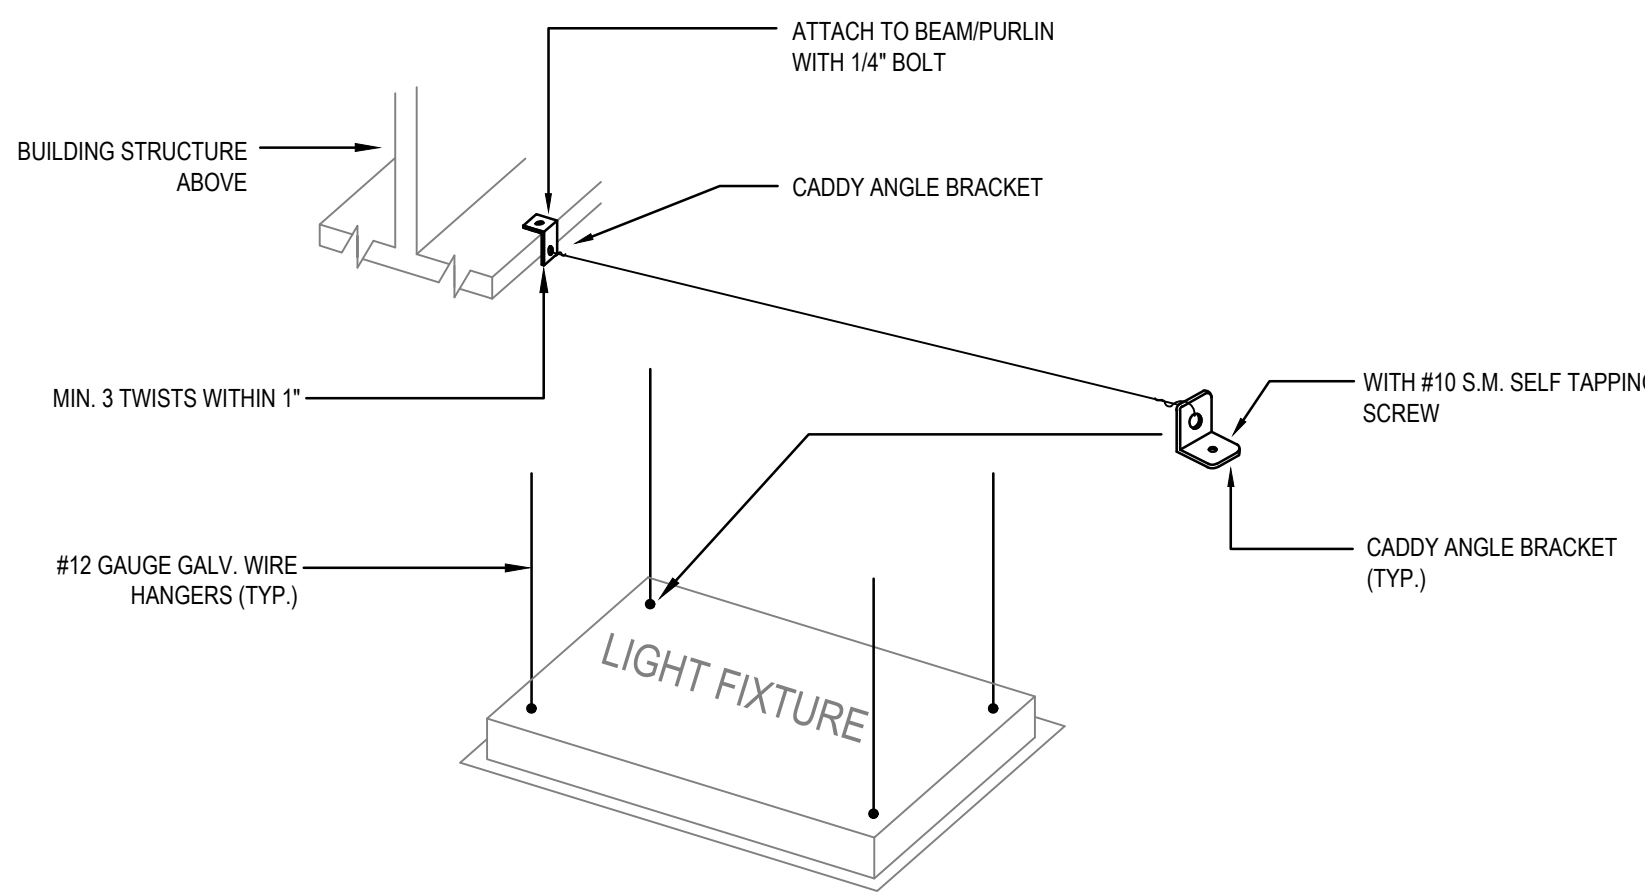

1. ALL LIGHTING FIXTURES SHALL BE SECURED TO THE STRUCTURE BY THE ELECTRICAL CONTRACTOR.
2. FLUSH OR RECESSED LIGHT FIXTURES LESS THAN 50 POUNDS SHALL HAVE 2 - 12 GA. SLACK SAFETY WIRES FROM DIAGONAL CORNERS TO BUILDING STRUCTURE BY TRADE CONTRACTOR.
3. FLUSH OR RECESSED LIGHT FIXTURES MORE THAN 50 POUNDS SHALL HAVE 4 - 12 GA. SLACK SAFETY WIRES FROM DIAGONAL CORNERS TO BUILDING STRUCTURE BY TRADE CONTRACTOR.
4. SECURE SURFACE MOUNTED LIGHT FIXTURES W/ MINIMUM OF 2 - POSITIVE CLAMPING DEVICES OF 1/4 GA. MINIMUM STEEL AND W/ 12 GA. WIRE TO BUILDING STRUCTURE.

## 8 TYPICAL LAY-IN GRID LIGHTING FIXTURE SUPPORT/MOUNTING DETAIL

SCALE: NONE

2 IT PART PLAN  
1/4" = 1'-0"

1 MAIN LEVEL POWER PLAN  
1/8" = 1'-0"

GENERAL POWER NOTES

- 1 REFER TO DRAWING E001-4 FOR ELECTRICAL SYMBOLS AND ABBREVIATIONS.
- 2 ALL NEW RECEPTACLES SHALL BE TAMPER-PROOF TYPE PER NEC 406.12 UNLESS LOCATED MORE THAN 5'-6" ABOVE THE FLOOR OR SERVE A DEDICATED PIECE OF EQUIPMENT THAT CAN NOT BE EASILY MOVED TO EXPOSE THE PLUG.
- 3 ALL DEVICES (RECEPTACLES, FIRE ALARM, CALL FOR AID, ETC.), AND ELECTRICAL EQUIPMENT (PANELBOARDS, DISCONNECT SWITCHES, ETC.) SHOWN DARK AND SOLID ARE TO BE NEW UNLESS OTHERWISE NOTED. ALL DEVICES AND EQUIPMENT SHOWN HALF TONE (LIGHT) AND SOLID ARE EXISTING TO REMAIN UNLESS OTHERWISE NOTED.

POWER KEY NOTES

- 1 FURNISH AND INSTALL ELECTRICAL PANEL AND REWORK EXISTING CIRCUITS TO THIS PANEL, WHICH ARE NOT BEING REMOVED. CONTRACTOR TO MAINTAIN ALL EXISTING ACTIVE BRANCH CIRCUITS. BALANCE LOADS AND INSTALL NEW TYPED PANEL DIRECTORY. REFER TO ONE LINE DIAGRAM DRAWING E300-4 AND PANEL SCHEDULE ON E300 SERIES DRAWINGS FOR NEW WORK REQUIREMENTS.
- 2 ALL DEVICES WHICH ARE MOUNTED ON EXISTING WALLS SHALL BE SURFACE MOUNTED DEVICES. THE RACEWAY SERVING THESE SPACES SHALL BE WIREMOLD PAINTED TO MATCH THE WALL. THE RACEWAY SHALL COME FROM THE CEILING & CONNECT ALL DEVICES SHOWN ON THE CIRCUIT. EXPOSED CONDUIT IN FINISHED SPACES IS NOT ACCEPTABLE. COORDINATE WIRETECHNOLOGY TO INCLUDE DATA/VOICE JACKS IN WIREMOLD WHERE NECESSARY.
- 3 EQUIPMENT SHOWN IS CONTROLLED VIA THE BUILDING MANAGEMENT SYSTEM. PROVIDE ALL NECESSARY WIRING BETWEEN THE CONTROLLER, EQUIPMENT, RELAYS, ETC. COORDINATE LOCATION OF POWER FOR EQUIPMENT SHOWN W/ASSOCIATED CONTRACTORS OF OTHER DISCIPLINES.
- 4 DUCT SMOKE DETECTORS FOR RTV'S. PROVIDE & INSTALL 1 FOR SUPPLY & 1 FOR RETURN. DETECTOR SHALL BE COMPATIBLE W/FAACP. COORDINATE EXACT LOCATIONS IN FIELD.
- 5 PROVIDE & INSTALL NEMA 1, 30A, 208V, 3 PHASE, SHUNT-TRIP FUSIBLE DISCONNECT SWITCH WITH AUXILIARY CONTACTS TO BE WIRED TO ELEVATOR BATTERY BACKUP. DISCONNECT SWITCH SHALL CONTAIN 30A FUSES. PROVIDE & INSTALL NEMA 1, 30A, 120V, SINGLE PHASE, FUSED DISCONNECT SWITCH W/30A FUSE FOR CAB LIGHTING/POWER.
- 6 INSTALL NEW FIRE ALARM DEVICE IN SAME LOCATION AS DEVICE WHICH WAS REMOVED. REUSE EXISTING RACEWAY TO FISH WIRES TO DEVICE FROM NEARBY FIRE ALARM LOOP. EXTEND RACEWAY AS NECESSARY TO REACH ACCESSIBLE CEILING SPACE.
- 7 BUILDING WILL BE OCCUPIED WHILE BEING RENOVATED. THE FIRE ALARM SYSTEM MUST BE FUNCTIONAL AT ALL TIMES. WORK ON THE FIRE ALARM SYSTEM SHOULD BE DONE DURING OFF HOURS, OR DURING TIMES WHEN THERE WILL BE MINIMAL INTERRUPTION TO THE BUILDING. IF NEEDED, A FIRE WATCH SHOULD BE PROVIDED.
- 8 FAN COIL UNITS SHOWN WILL HAVE A HARD WIRED INTERNAL CONDENSATE PUMP. PROVIDE WIRING FOR PUMP, COORDINATE W/MECHANICAL CONTRACTOR.
- 9 VRF HEAT RECOVERY BRANCH CIRCUIT CONTROLLER SHOWN WILL HAVE A HARD WIRED INTERNAL CONDENSATE PUMP. PROVIDE WIRING FOR PUMP, COORDINATE W/MECHANICAL CONTRACTOR.
- 10 PROPOSED CONDUIT PATH FOR FLOOR BOXES. FLOOR MUST BE TRENCHED TO LOCATIONS SHOWN, COORDINATE W/ARCHITECTURAL DRAWINGS. RACEWAY MUST BE CONCEALED.
- 11 INSTALL NEW POWERED DOOR OPENERS AT THE DOOR SHOWN. INSTALL A TOGGLE DISCONNECT SWITCH AT THE MOTOR. INSTALL PUSH PLATE DOOR OPERATORS AT THE LOCATIONS SHOWN. COORDINATE W/ARCHITECT FOR EXACT LOCATIONS. PROVIDE ALL WIRING, CONDUIT, EQUIPMENT NECESSARY FOR A COMPLETE & WORKING INSTALLATION. ANY DEVICES WHICH ARE MOUNTED ON AN EXISTING WALL OR MULLION SHALL HAVE WIREMOLD PAINTED THE SAME COLOR AS THE WALL OR MULLION IT IS INSTALLED ON. POWER FOR CIRCUIT IS ASSUMED FOR A 1/2 HP MOTOR. IF THE MOTOR IS LARGER THE CIRCUIT BREAKER SERVING IT WILL NEED TO BE INCREASED, AS WELL AS THE WIRE SIZE.
- 12 FURNISH AND INSTALL ELECTRICAL EQUIPMENT. REFER TO ONE-LINE DIAGRAM DRAWING E300-4 FOR NEW WORK REQUIREMENTS.
- 13 INSTALL RELOCATED LIGHTING CONTROL, TERMINATION STATION, DISCONNECT SWITCH, WIRING AND CONDUIT TO PANEL/CIRCUIT AS INDICATED.
- 14 COORDINATE PAD FOR HP'S & PAD FOR UTILITY TRANSFORMER W/MECHANICAL & CIVIL CONTRACTORS. TRANSFORMER IS SHOWN 5' AWAY FROM HP. REFER TO TYPICAL PAD MOUNTED TRANSFORMER & PRECAST CONCRETE TRANSFORMER PAD DETAIL ON E400-4.
- 15 CONDENSATE PUMP FOR RCC'S & WALL MOUNTED FCU'S NEED WIRING/POWER PROVIDED TO THEM. CONDENSATE PUMP POWER SHALL COME FROM THE UNIT IT IS SERVING. DISCONNECT SWITCH WIRING SHALL BE CONNECTED TO THE UNIT SAFETY CONNECTORS. WIRING SHALL BE FIELD SUPPLIED & SHALL BE IN ACCORDANCE W/MANUFACTURER'S REQUIREMENTS. REFER TO MECHANICAL DRAWINGS FOR MORE INFORMATION.

KEY PLAN  
SCALE: NTS

Project Title:  
**ALTERATIONS TO:  
ACES at Chase**  
565 Chase Parkway  
Waterbury, Connecticut 06708



**SILVER PETRUCCELLI + ASSOCIATES**  
3190 WHITNEY AVENUE HAMDEN CT 06518  
311 STATE STREET NEW LONDON CT 06320  
203 230 9007 silverpetrucci.com

Revision:	Description:	Date:	Revised By:
1	Bulletin #1	12/16/25	MTC

Drawing Title:  
**BUILDING 4 - MAIN LEVEL POWER PLAN**  
Project Phase:  
**ISSUED FOR BID - 11/03/2025**  
State Project Number:  
**#244-0044 MAG**

Date:  
AUGUST 12, 2025  
Scale:  
As indicated  
Drawn By:  
MTC  
Project Number:  
22.050

Drawing Number:

**E200-4**


12/16/2025 10:27:43 AM

1	FURNISH AND INSTALL ELECTRICAL PANEL AND REMOVAL EXISTING CIRCUITS TO THIS PANEL, WHICH ARE NOT BEING REUSED. CONTRACTOR TO MAINTAIN ALL EXISTING ACTIVE BRANCH CIRCUIT BALANCE LOADS AND INSTALL NEW TYPED PANEL DIRECTORY. REFER TO ONE LINE DIAGRAM DRAWING E300-4 AND PANEL SCHEDULE ON E500 SERIES DRAWINGS FOR NEW WORK REQUIREMENTS.
2	ALL DEVICES WHICH ARE MOUNTED ON EXISTING WALLS SHALL BE SURFACE MOUNTED DEVICES. THE RACEWAY SERVING THESE SPACES SHALL BE WIREMOLD PAINTED TO MATCH THE WALL. THE RACEWAY SHALL COME FROM THE CEILING A CONNECT ALL DEVICES SHOWN ON THE CIRCUIT. EXPOSED CONDUIT IN FINISHED SPACES IS NOT ACCEPTABLE. COORDINATE WIT/ELECTRICAL TO INCLUDE DATA/VOICE JACKS IN WIREMOLD WHERE NECESSARY.
3	EQUIPMENT SHOWN IS CONTROLLED VIA THE BUILDING MANAGEMENT SYSTEM. PROVIDE ALL NECESSARY WIRING BETWEEN THE CONTROLLER, EQUIPMENT, RELAYS, ETC. COORDINATE LOCATION OF POWER FOR EQUIPMENT SHOWN W/ASSOCIATED CONTRACTORS OF OTHER DISCIPLINES.
4	INSTALL NEW FIRE ALARM DEVICE IN SAME LOCATION AS DEVICE WHICH WAS REMOVED. REUSE EXISTING RACEWAY TO FISH WIRES TO DEVICE FROM NEARBY FIRE ALARM LOU. EXTEND RACEWAY AS NECESSARY TO REACH ACCESSIBLE CEILING SPACE.
5	FAN COIL UNITS SHOWN WILL HAVE A HARD WIRED INTERLOCK CONDENSATE PUMP. PROVIDE WIRING FOR PUMP. COORDINATE W/MECHANICAL CONTRACTOR.
6	VWF HEAT RECOVERY BRANCH CIRCUIT CONTRACTOR SHOWN WILL HAVE A HARD WIRED INTERLOCK CONDENSATE PUMP. PROVIDE WIRING FOR PUMP. COORDINATE W/MECHANICAL CONTRACTOR.
7	LOUVER SHOWN HAS A MOTORIZED DAMPER. PROVIDE POWER TO DAMPER FROM NEARBY GENERAL PURPOSE RECEPTACLE CIRCUIT AS SHOWN. COORDINATE W/MECHANICAL CONTRACTOR FOR EXACT LOCATION.
8	EXHAUST FAN SHOWN IS INTERLOCKED W/IRROG/CONTACTS SENSORS FOR ROOMS DENOTED ON E100-4 & E101-4. PROVIDE NECESSARY WIRING/CONTACTS IN ORDER TO ACCOMPLISH COORDINATE W/MECHANICAL CONTRACTOR FOR EXACT LOCATION.
9	ERV'S SHOWN ARE INTERLOCKED W/ASSOCIATED FAN COIL UNITS. PROVIDE NECESSARY WIRING/CONTACTS IN ORDER TO ACCOMPLISH. COORDINATE W/MECHANICAL CONTRACTOR FOR EXACT LOCATION.
10	FURNISH AND INSTALL ELECTRICAL EQUIPMENT. REFER TO ONE-LINE DIAGRAM DRAWING E300-4 FOR NEW WORK REQUIREMENTS.
11	FURNISH AND INSTALL ELECTRICAL LIGHTING INVERTER PANEL. REFER TO ONE-LINE DIAGRAM DRAWING E300-4 AND PANEL SCHEDULE ON E500 SERIES DRAWINGS FOR NEW WORK REQUIREMENTS.

The floor plan illustrates the second floor of a building, featuring a variety of functional spaces and their interconnections. Key areas include:

- Office and Support Spaces:** OFFICE (206.4), TOILET (207.4), STORAGE (202.1-4), MECHANICAL (208.4), and ELEVATOR LOBBY (200.4).
- Performance and Practice Areas:** KEYBOARDING (202.4), CHORUS (201.4), PRACTICE (203.4, 204.4, 204.1), and STAIR (S2.4).
- Mechanical and Utility Rooms:** ERV2.4, ERV3.4, ERV1.4, and various FCU (Fan Coil Unit) and P (Pump) units.
- Corridors and Stairs:** CORRIDOR (210.4) and STAIR (S2.4).
- Alternate Stage Area:** A large, open area on the right side of the plan, labeled 'ALTERNATE - STAGE', which includes two smaller stage areas (STAGE 102.4 and STAGE 101.4) and a large open space (STAGE 102.4).

The plan is densely populated with numbered points (e.g., P2/43.45, P3/32, P3/25) and lines indicating connections or paths between them, suggesting a complex network of systems or movement.

[illegible]

Date: AUGUST 12, 2025

Scale:  $1/8" = 1'-0"$

Drawn By: MTC


Project Number: 22.050

Drawing Number: E210

E210-4


12/16/2025 10:27:45 AM



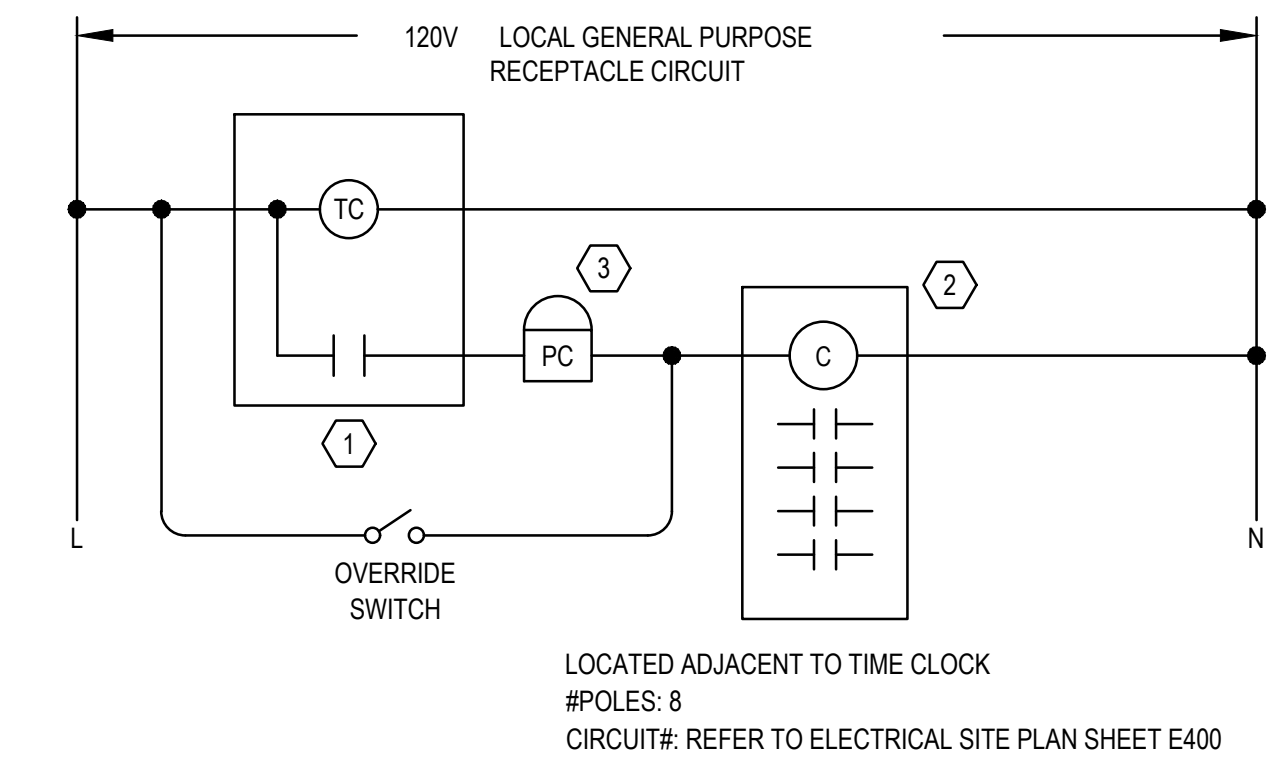


CONTACTOR SCHEDULE			
YAG	DESCRIPTION	MODEL NO.	REMARKS
①	DIGITAL PROGRAMMABLE TIME CLOCK 24HR, 7DAY 365DAY, SEASONAL SCHEDULING, 99 ON/OFF POINTS, PERMANENT SCHEDULE RETENTION ON POWER LOSS, POWER OUTAGE BACKUP, AUTOMATIC LEAP YEAR AND DAYLIGHT SAVINGS TIME ADJ, MECHANICALLY WELDED CONTACTS, MULTI VOLTAGE INPUT.	TORK 02S200A OR EQUIVALENT INTERMATIC OR SQUARE D	12.4
②	CONTACTOR ELECTRICALLY OPERATED, MECHANICALLY WELDED, 250A LIGHTING CONTACTOR, CONTROL VOLTAGE AS LISTED, FROM LOCAL GENERAL PURPOSE RECEPTACLE CIRCUIT.	ASCO 917 SERIES WITH 2 WIRE CONTROL, OPTION OR EQUIVALENT GE OR SQUARE	
③	PHOTOCELL 1800V, 18A, 40 DEG. TO 140 DEG., SOLID STATE SPST DRY CONTACT, LIGHT LEVEL RANGE 1.5 TO 10IC WITH ADJUSTMENT, TIME DELAY 15 SEC. MINIMUM	TORK 2100 SERIES OR EQUIVALENT INTERMATIC OR SQUARE D	3
NOTES: 1. TIMECLOCK SHALL BE PROGRAMMED TO TURN SITE LIGHTING ON AT DUSK (VIA PHOTOCELL) AND OFF WHENEVER THE OWNER WOULD LIKE IT OFF. 2. LOCATE TIME CLOCK ADJACENT TO ELECTRICAL PANEL. 3. PHOTOCELL TO BE LOCATED ON SOUTHERN EXPOSURE. 4. PROVIDE BACKUP CAPABILITY TO TIE INTO BMS & ACCESS CONTROLS REMOTELY.			

**1 LIGHTING TIME CLOCK & CONTACTOR DETAIL**  
SCALE: NONE

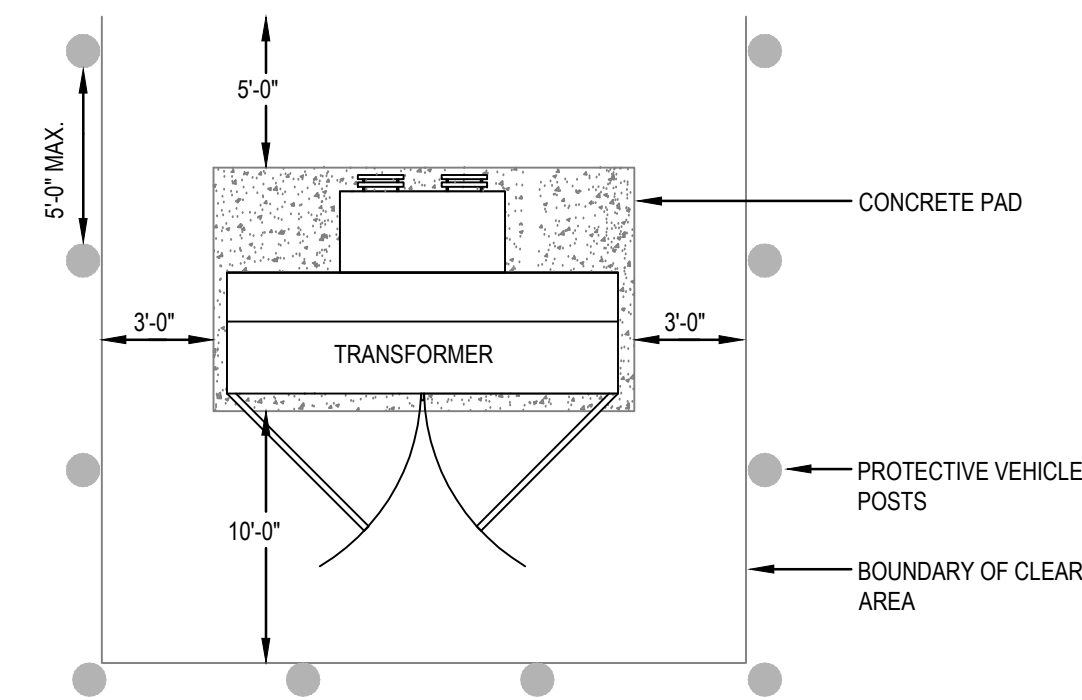


**2 TYPICAL PAD MOUNTED TRANSFORMER**  
SCALE: NONE

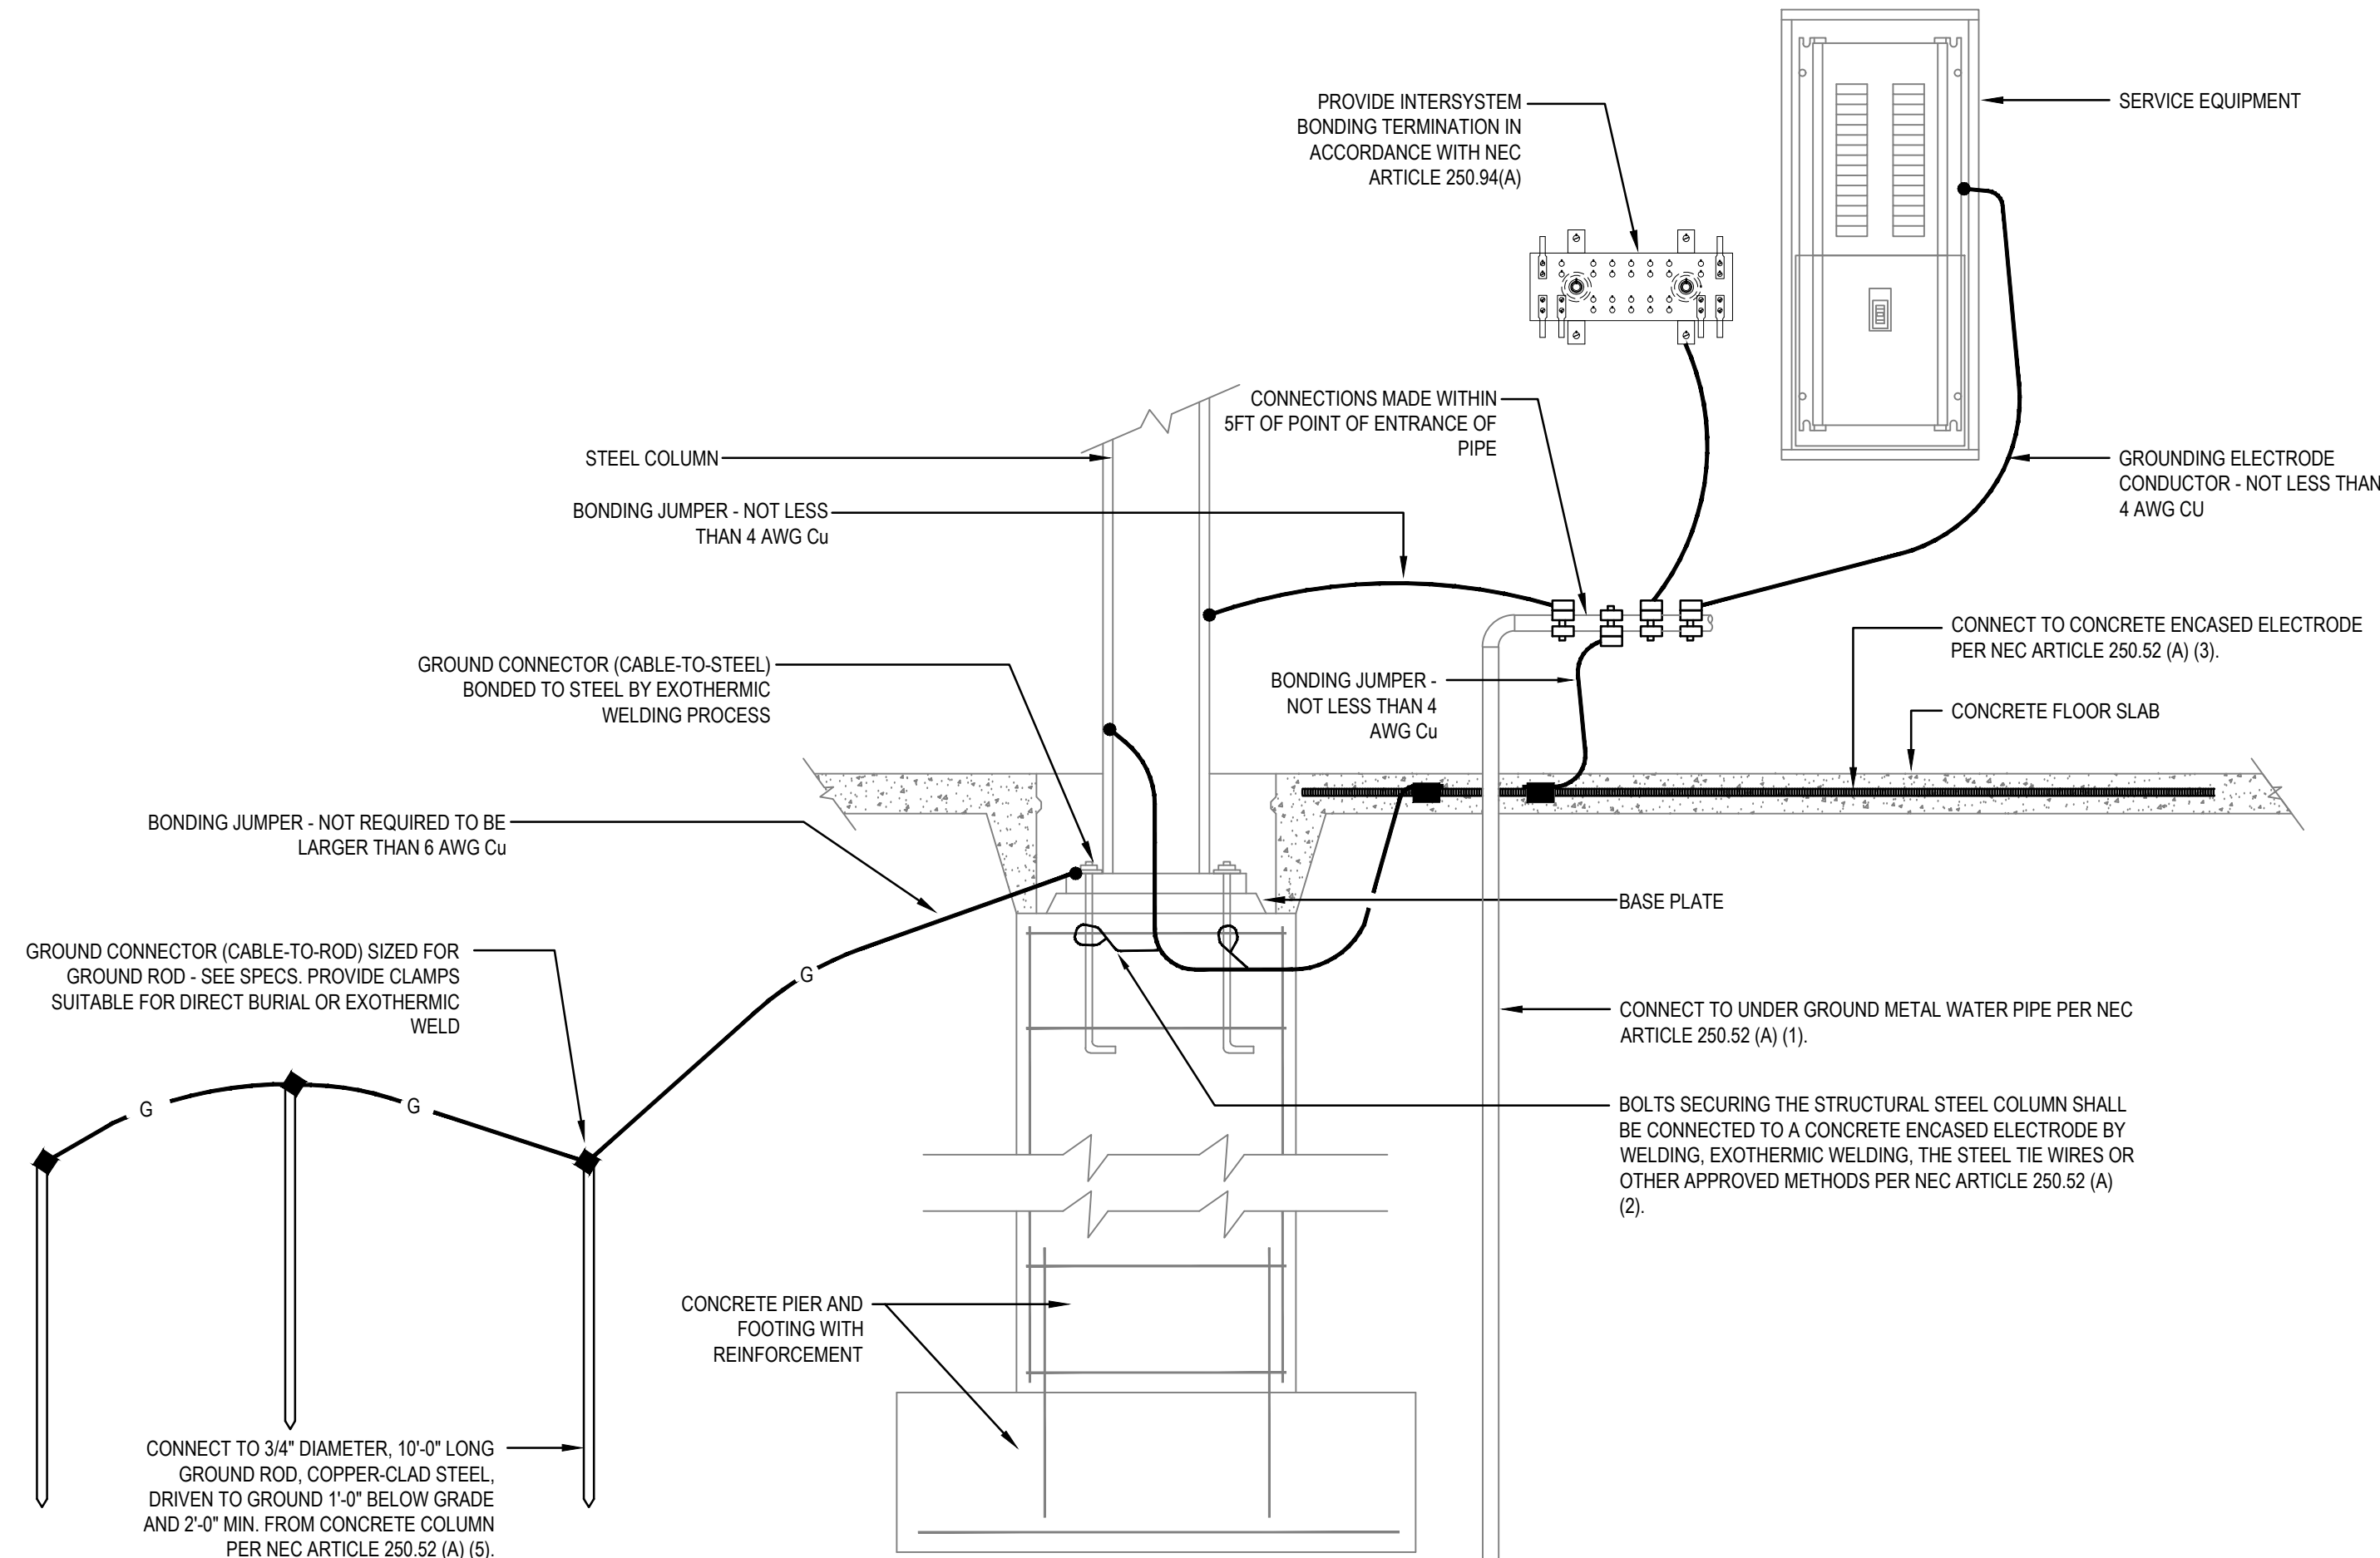


GENERAL NOTES:  
1. PROVIDE GROUNDING ELECTRODE SYSTEM PER NEC ARTICLE 250.50. ALL GROUNDING ELECTRODES AS DESCRIBED IN 250.52 (A) (1) THROUGH (A) (7) THAT ARE PRESENT AT EACH BUILDING OR STRUCTURE SERVED SHALL BE BONDED TOGETHER TO FORM THE GROUNDING ELECTRODE SYSTEM.

**3 TYPICAL GROUNDING DETAIL**  
SCALE: NONE

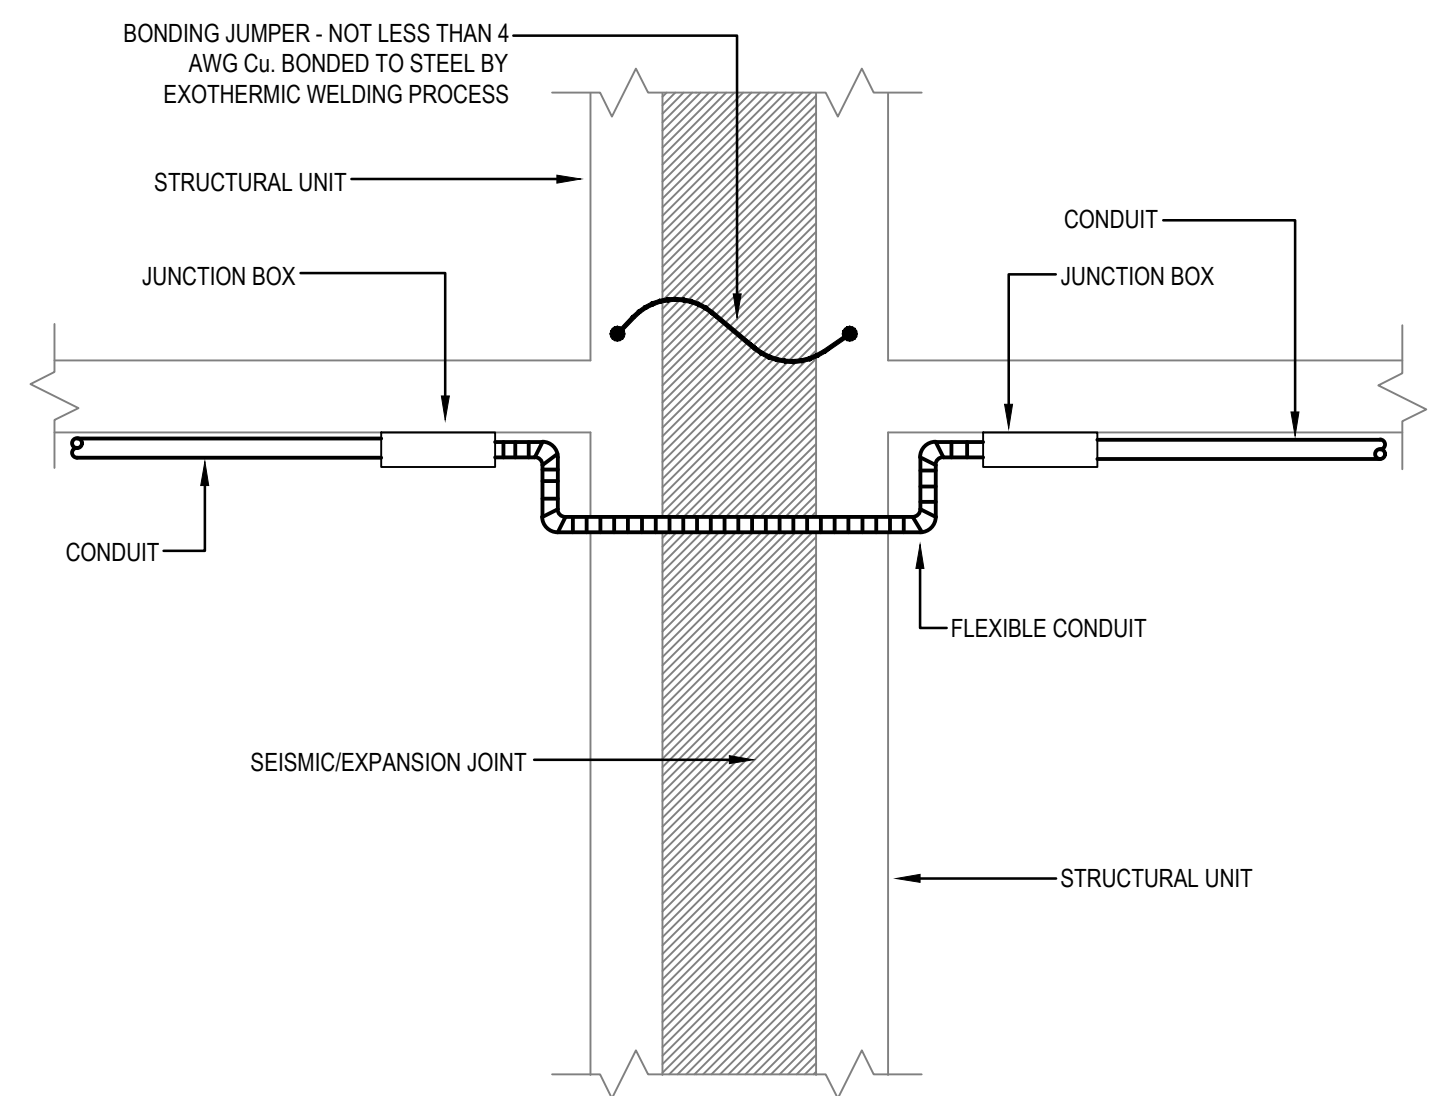

**4 EXPANSION/SEISMIC JOINT FITTING DETAIL**  
SCALE: NONE

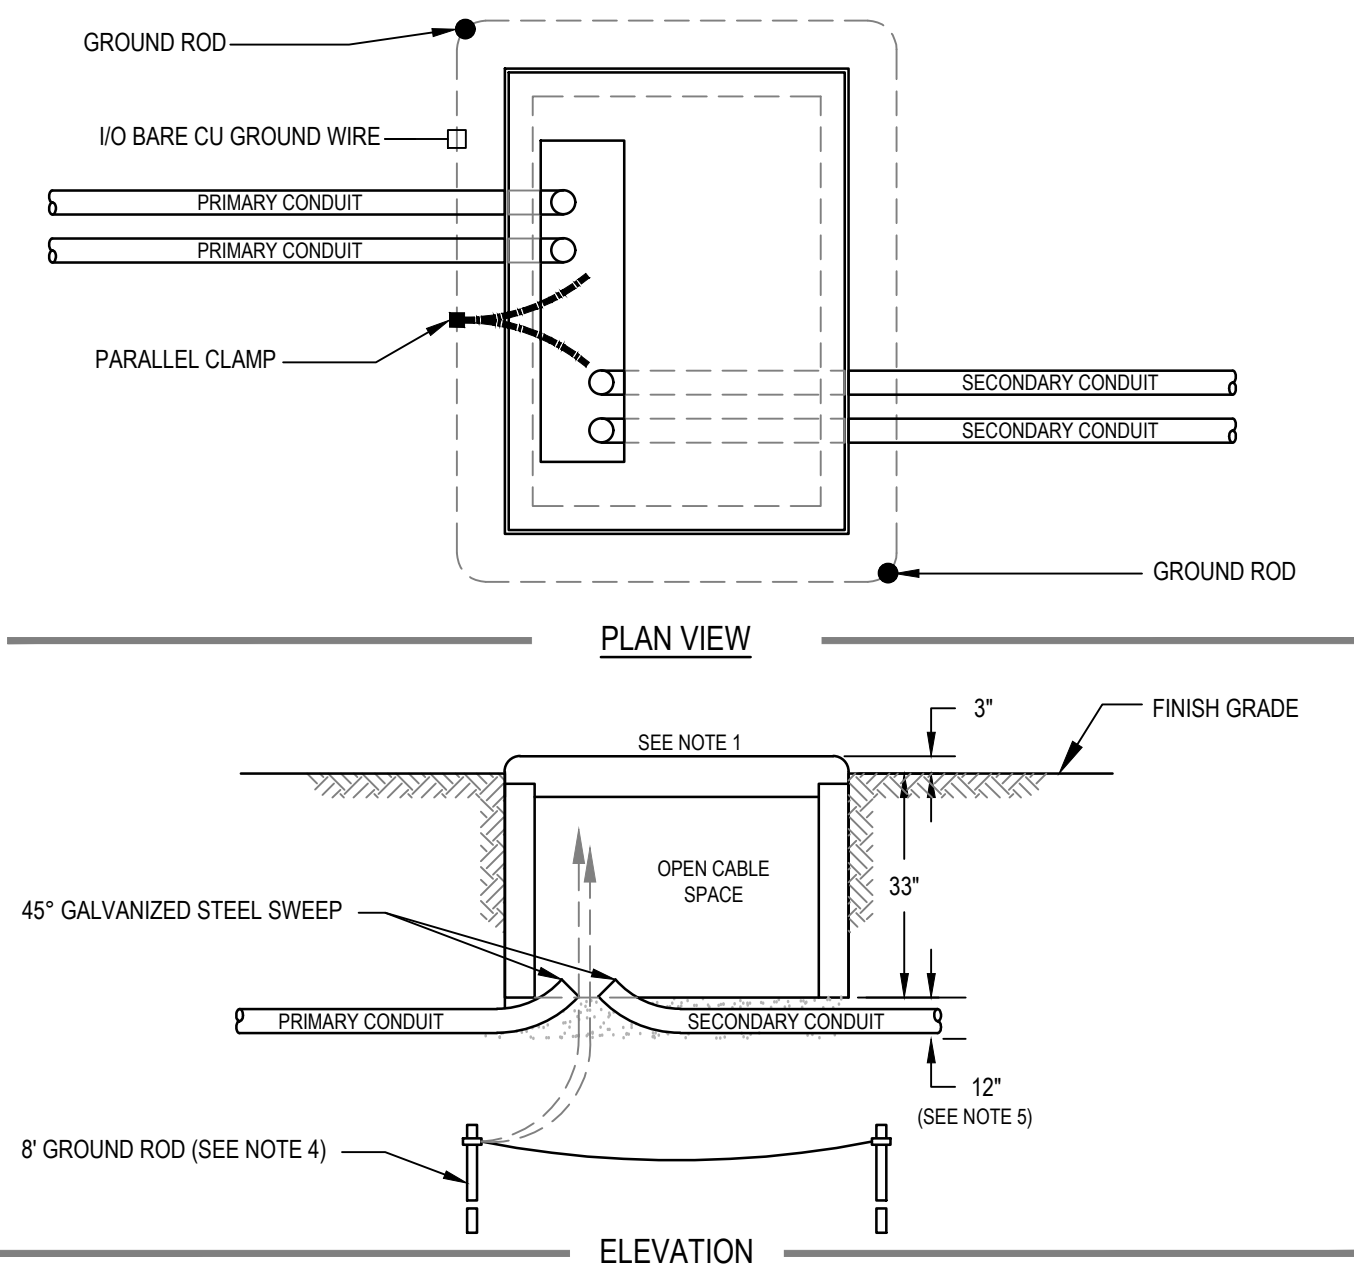


NOTES:  
1. 75-300 KVA: INSTALL 76" X 54" X 36" PAD PER SPC P-05, P-06.  
500-1500 KVA: INSTALL 76" X 70" X 36" PAD PER SPC P-07, P-08.  
2. PRIMARY CABLE:  
A. INSTALL CABLES IN CONDUIT A MINIMUM OF 3" BELOW GRADE.  
B. LOOP CABLES IN CABLE VAULT BEFORE MAKING CONNECTIONS.  
3. SECONDARY CABLE:  
LEAVE SLACK FOR FUTURE RECONNECTING TO TRANSFORMERS WITH HIGHER SECONDARY TERMINALS.  
4. COPPERWELDED GROUND RODS: INSTALL IN TRENCH


AND CONNECT A BARE 1/0 COPPER CONDUCTOR FROM RODS THROUGH PAD OPENING AND EXTENDING 5 FT. ABOVE PAD.  
5. THE EXCAVATION FOR THE PAD SHALL BE CARRIED TO A DEPTH OF 12" BELOW THE BOTTOM OF THE PAD WALLS. THE BACKFILL UNDER THE PAD WALLS SHALL BE A CLEAN GRAVEL, FREE OF FOREIGN MATTER AND CONSTRUCTION DEBRIS, AND IN ACCORDANCE WITH CONN D.O.T. SPEC. M.02.06 GRADING "A". BACKFILL SHALL BE PLACED IN 6" LAYERS AND COMPACTED WITH MECHANICAL TAMPERS TO NOT LESS THAN 95% OF THE MAXIMUM DRY DENSITY AS DETERMINED BY STANDARD COMPACTION TESTS, AASHTO T180 OR ASTM D698.

**5 PRECAST CONCRETE TRANSFORMER PAD DETAIL**  
SCALE: NONE


GENERAL NOTES:  
PROVIDE UL LISTED FIRE/SMOKE PENETRATION ASSEMBLY IN ACCORDANCE W/ UL1479, ASTM E814 REQUIREMENTS FOR WALL TYPE, RATING, PIPE SIZE, INSTALLED.  
FIRE STOPPING SHALL HAVE A RATING EQUAL TO OR GREATER THAN THE WALL BEING PENETRATED - SEE SPECIFICATIONS. REFER TO ARCHITECTURAL DRAWINGS FOR WALL RATINGS AND LOCATIONS.

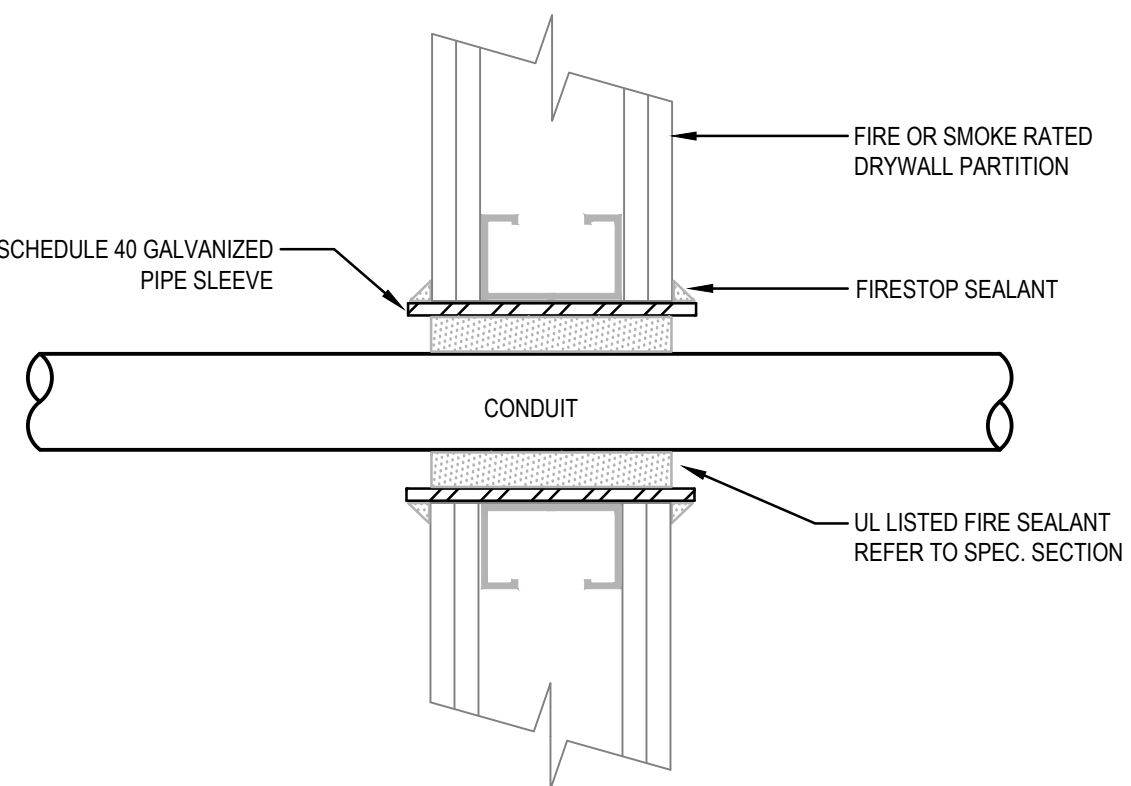

**6 WALL PENETRATION W/FIRE-SMOKE SEAL DETAIL**  
SCALE: NONE

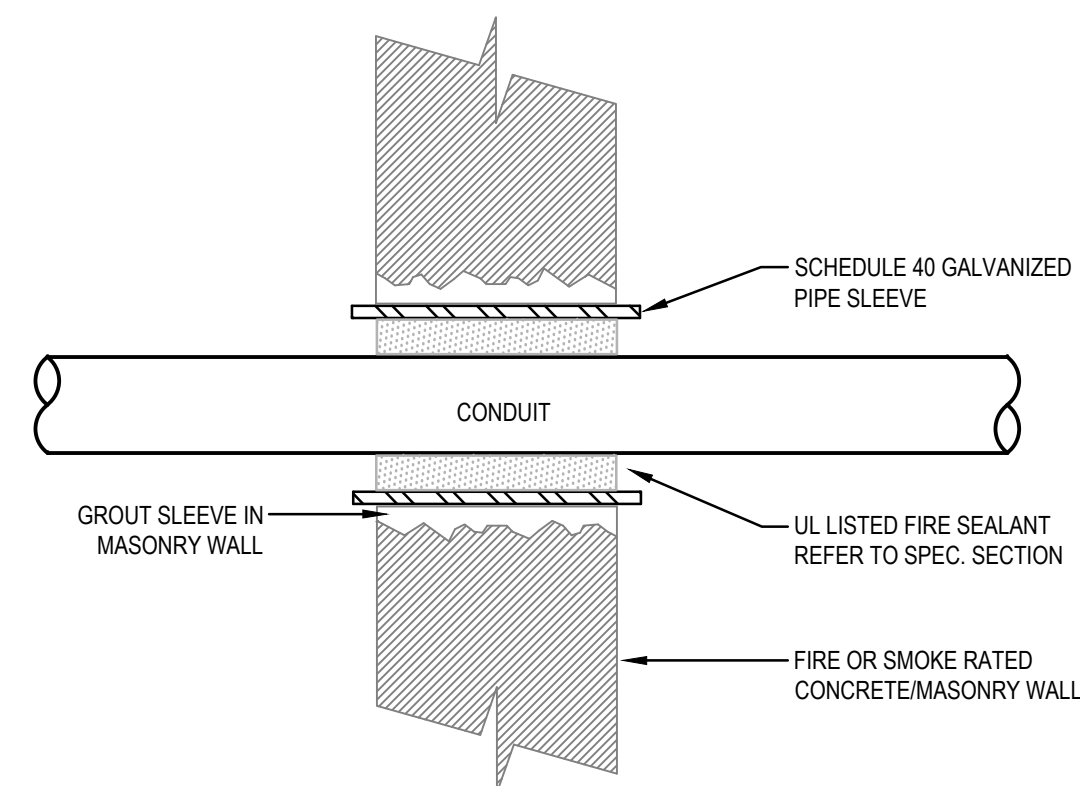


**7 WATER-TIGHT WALL SLEEVE**  
SCALE: NONE

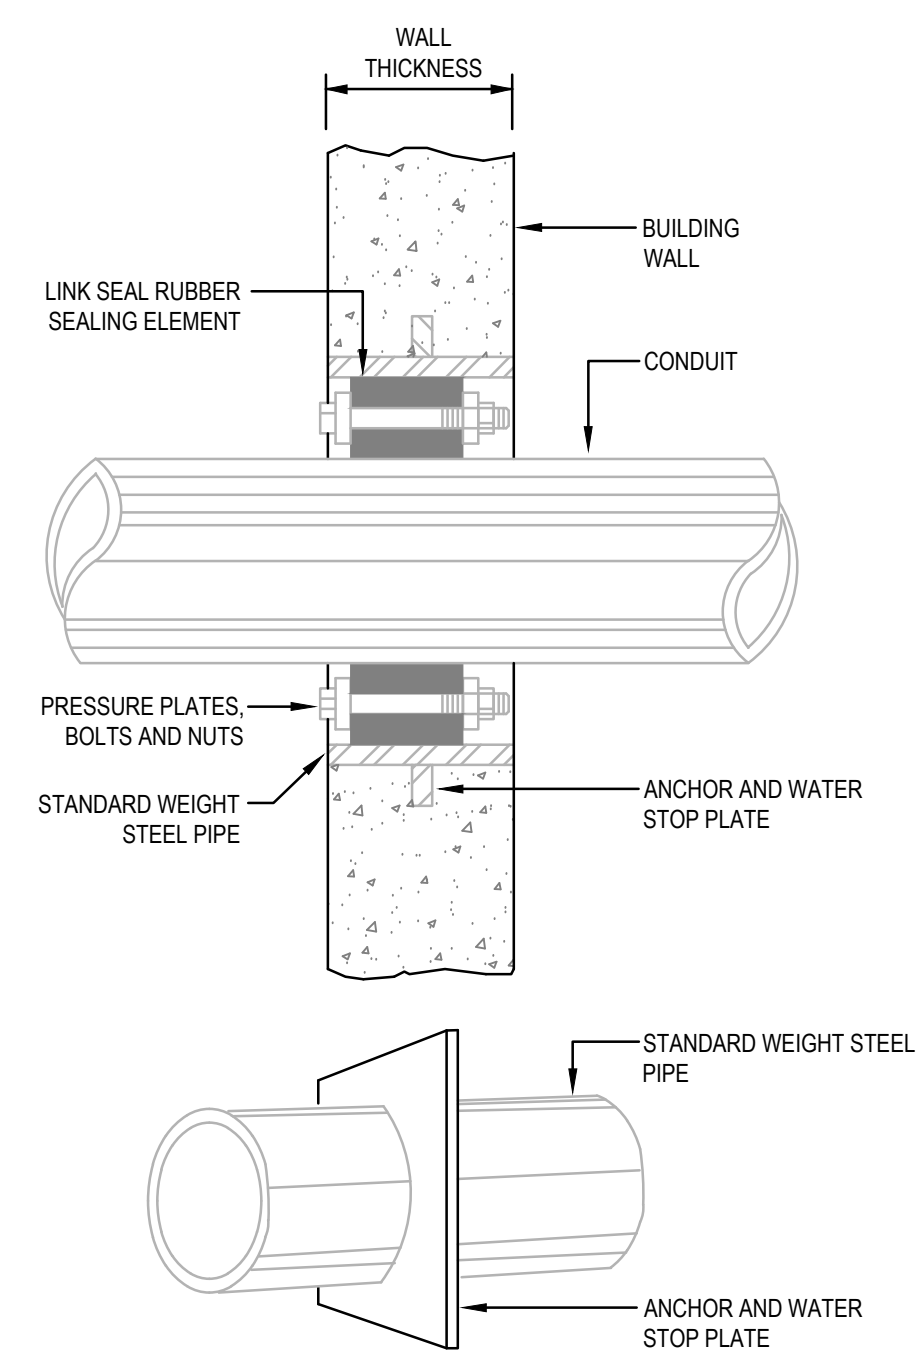


**8 TYPICAL LAY-IN GRID LIGHTING FIXTURE SUPPORT/MOUNTING DETAIL**  
SCALE: NONE

- ALL LIGHTING FIXTURES SHALL BE SECURED TO THE STRUCTURE BY THE ELECTRICAL CONTRACTOR.
- FLUSH OR RECESSED LIGHT FIXTURES LESS THAN 56 POUNDS SHALL HAVE 2-12 GA. SLACK SAFETY WIRES FROM DIAGONAL CORNERS TO BUILDING STRUCTURE BY TRADE CONTRACTOR.
- FLUSH OR RECESSED LIGHT FIXTURES MORE THAN 56 POUNDS SHALL HAVE 4-12 GA. SLACK SAFETY WIRES FROM DIAGONAL CORNERS TO BUILDING STRUCTURE BY TRADE CONTRACTOR.
- SECURE SURFACE MOUNTED LIGHT FIXTURES W/ MINIMUM OF 2- POSITIVE CLAMPING DEVICES OF 1/4 GA. MINIMUM STEEL AND W/ 1/2 GA. WIRE TO BUILDING STRUCTURE.


**8 TYPICAL LAY-IN GRID LIGHTING FIXTURE SUPPORT/MOUNTING DETAIL**  
SCALE: NONE

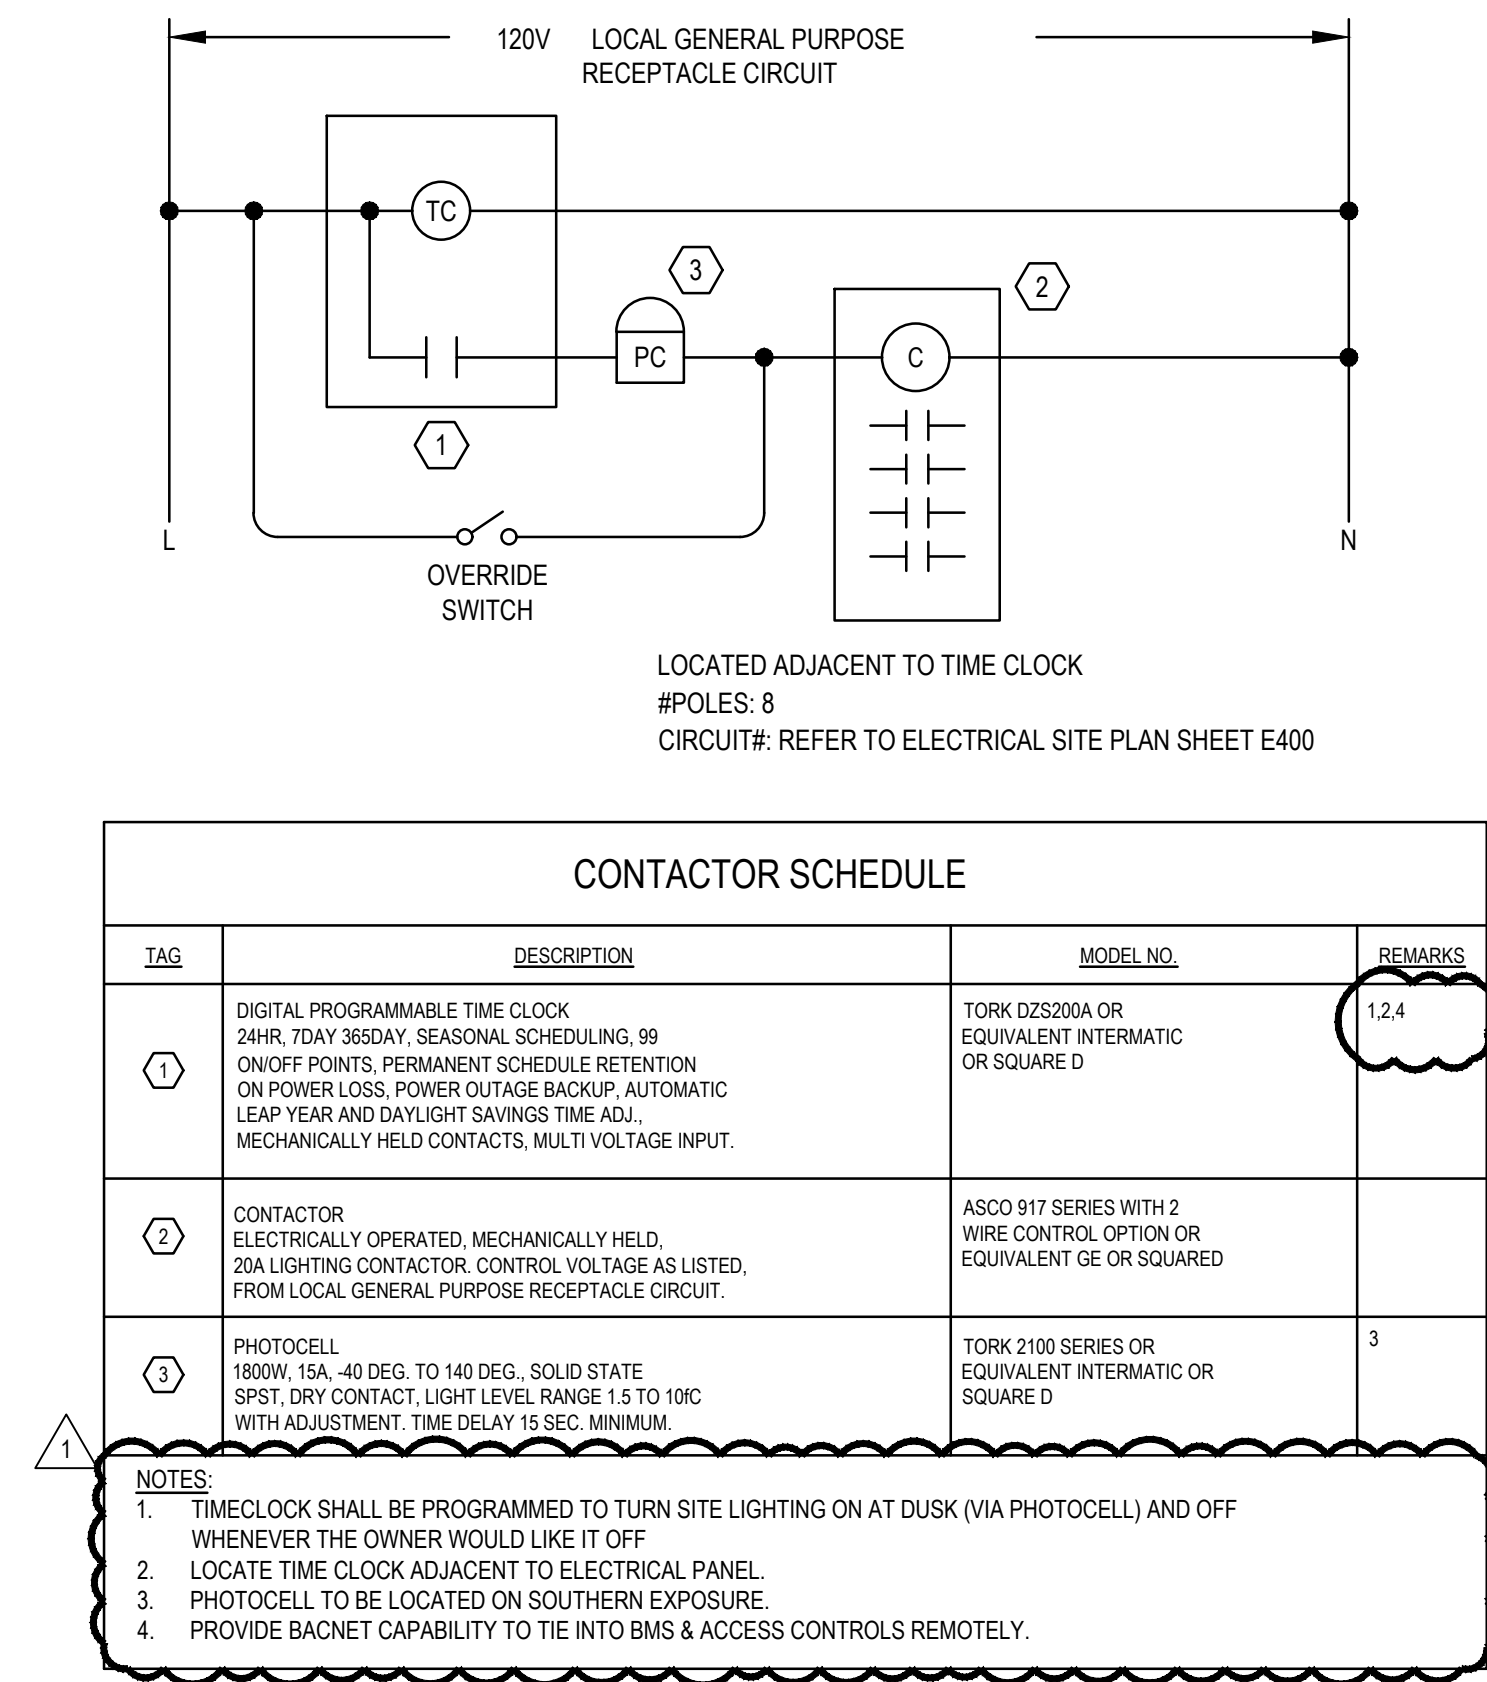

1 LIGHTING TIME CLOCK & CONTACTOR DETAIL  
SCALE: NONE

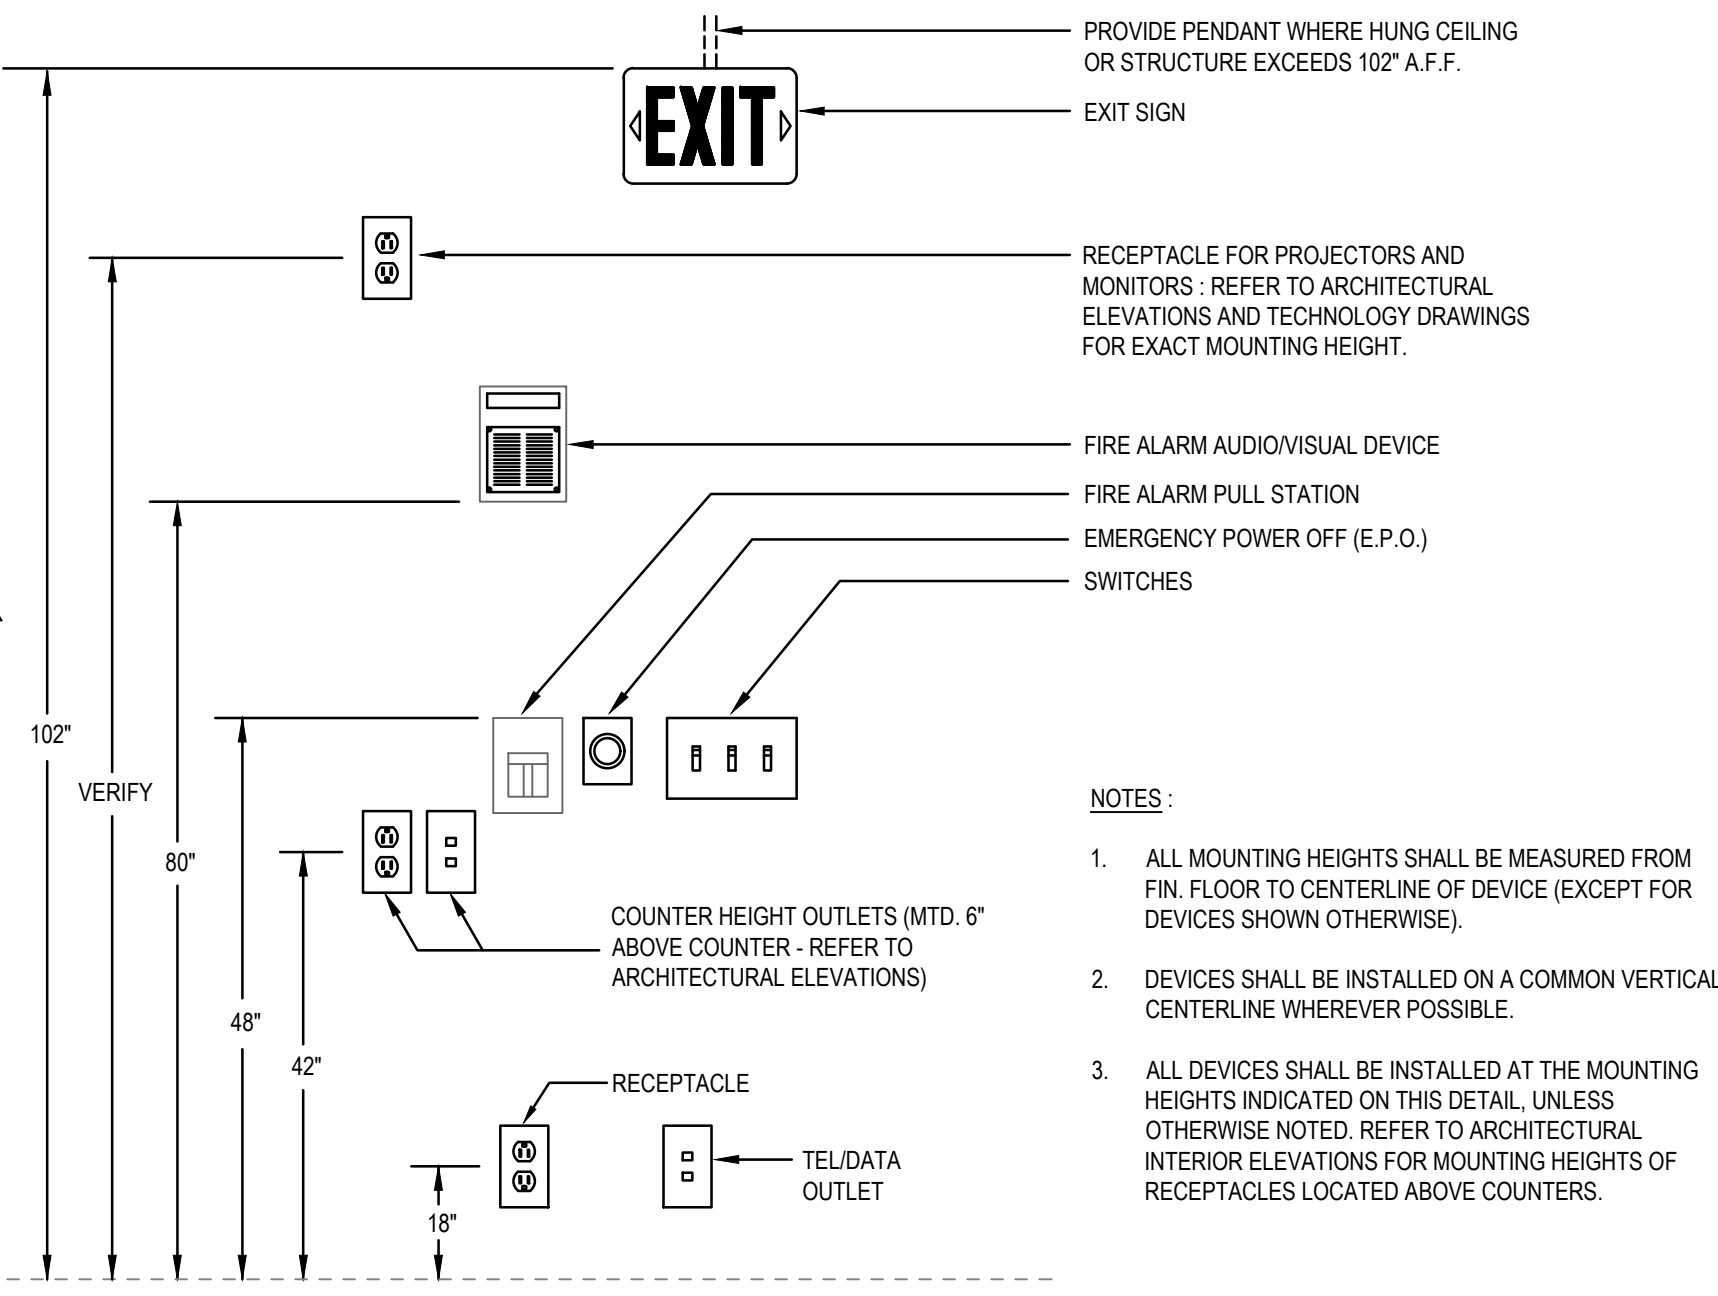

2 TYPICAL DEVICE MOUNTING HEIGHT DETAIL  
SCALE: NONE

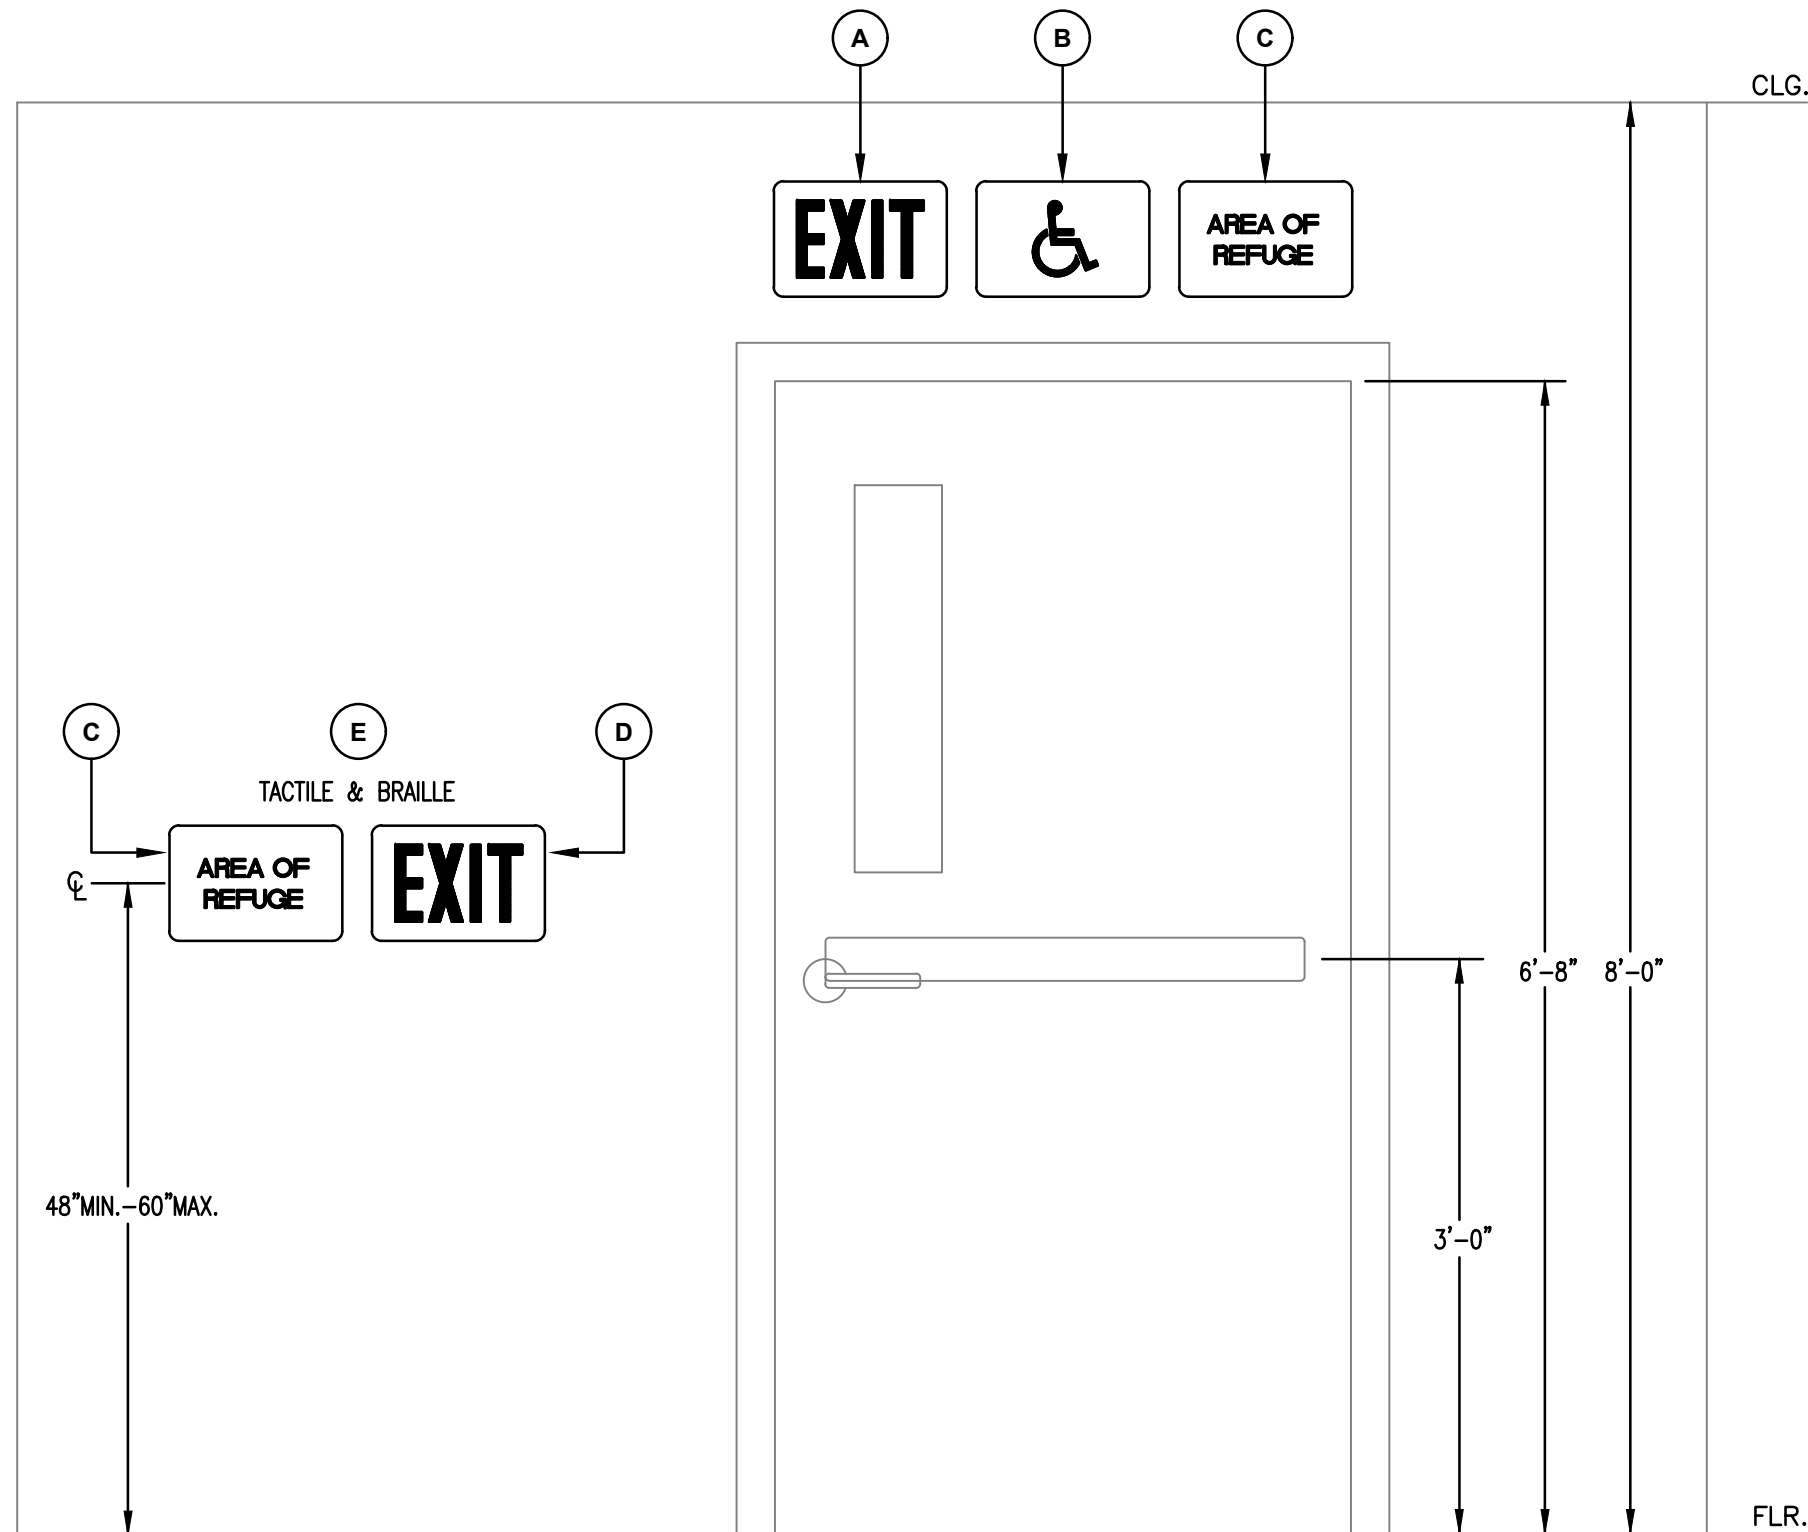

3 EXIT SIGN MOUNTING DETAIL  
SCALE: NONE

NOTES IN ACCORDANCE WITH 2022 CONNECTICUT STATE BUILDING CODE:

SECTION 1011.1: WHERE REQUIRED, EXITS AND EXIT ACCESS DOORS SHALL BE MARKED BY AN APPROVED EXIT SIGN READILY VISIBLE FROM ANY DIRECTION OF EGRESS TRAVEL. ACCESS TO EXITS SHALL BE MARKED BY READILY VISIBLE EXIT SIGNS IN CASES WHERE THE EXIT OR THE PATH OF EGRESS TRAVEL IS NOT IMMEDIATELY VISIBLE TO THE OCCUPANTS. EXIT SIGN PLACEMENT SHALL BE SUCH THAT NO POINT IN AN EXIT ACCESS CORRIDOR IS MORE THAN 100 FEET OF THE LISTED VIEWING DISTANCE FOR THE SIGN, WHICH IS LESS, FROM THE NEAREST VISIBLE EXIT SIGN.

SECTION 1011.2: ILLUMINATION. EXIT SIGNS SHALL BE INTERNALLY OR EXTERNALLY ILLUMINATED. EXCEPTION: TACTILE SIGNS REQUIRED BY SECTION 1011.3 NEED NOT BE PROVIDED WITH ILLUMINATION.

CT 2022 AMENDMENT

SECTION 1011.2 ACCESSIBLE EXITS: WHERE EXIT SIGNS ARE REQUIRED BY SECTION 1011.1 OF THIS CODE, ACCESSIBLE EXIT DOORS AT THE LEVEL OF EXIT DISCHARGE THAT LEAD DIRECTLY TO ACCESSIBLE PATHS OF EXIT DISCHARGE SHALL ADDITIONALLY BE MARKED BY THE INTERNATIONAL SYMBOL OF ACCESSIBILITY. SUCH SYMBOL SHALL BE NOT LESS THAN 6 INCHES HIGH AND SHALL BE INCORPORATED INTO THE REQUIRED EXIT SIGN OR SHALL BE LOCATED DIRECTLY ADJACENT TO IT. SUCH SYMBOL SHALL MEET THE REQUIREMENTS OF SECTION 1011.


SECTION 1007.6.5: IDENTIFICATION. EACH DOOR PROVIDING ACCESS TO AN AREA OF REFUGE FROM AN ADJACENT FLOOR AREA SHALL BE IDENTIFIED BY A SIGN COMPLYING WITH ICC A117.1, STATING: AREA OF REFUGE AND INCLUDING THE INTERNATIONAL SYMBOL OF ACCESSIBILITY. WHERE EXIT SIGN ILLUMINATION IS REQUIRED BY SECTION 1011.2, THE AREA OF REFUGE SIGN SHALL BE ILLUMINATED.

ADDITIONALLY, TACTILE SIGNAGE COMPLYING WITH ICC A117.1 SHALL BE LOCATED AT EACH DOOR TO AN AREA OF REFUGE. (TACTILE AND BRAILLE IS REQUIRED ON TACTILE SIGNAGE. ANSI A117.1-2003, 703.3 AND 703.4.)


SECTION 1011.3: TACTILE EXIT SIGNS. A TACTILE EXIT SIGN STATING EXIT AND COMPLYING WITH ICC A117.1 SHALL BE PROVIDED ADJACENT TO EACH DOOR TO AN EGRESS STAIRWAY, AN EXIT PASSAGEWAY AND THE EXIT DISCHARGE. (TACTILE AND BRAILLE IS REQUIRED ON TACTILE SIGNAGE. ANSI A117.1-2003, 703.3 AND 703.4.)

CT 2022 AMENDMENT


SECTION 1110.4: INTERIOR SIGNAGE. INTERIOR SIGNS DESIGNATE PERMANENT ROOMS AND SPACES SHALL BE RAISED TEXT CHARACTERS AND BRAILLE, DESIGNED AND LOCATED IN ACCORDANCE WITH ICC/ANSI A117.1-2003. MOUNTING LOCATION FOR SIGNAGE SHALL BE SUCH THAT ANY PERSON APPROACHING THE SIGNAGE WILL NOT ENCOUNTER PROTRUDING OBJECTS, OR STAND WITHIN THE SWING OF ANY DOOR. (STAIR INFORMATION SIGNAGE IS REQUIRED IN TACTILE AND BRAILLE. ANSI A117.1-2003, 703.3 AND 703.4.)

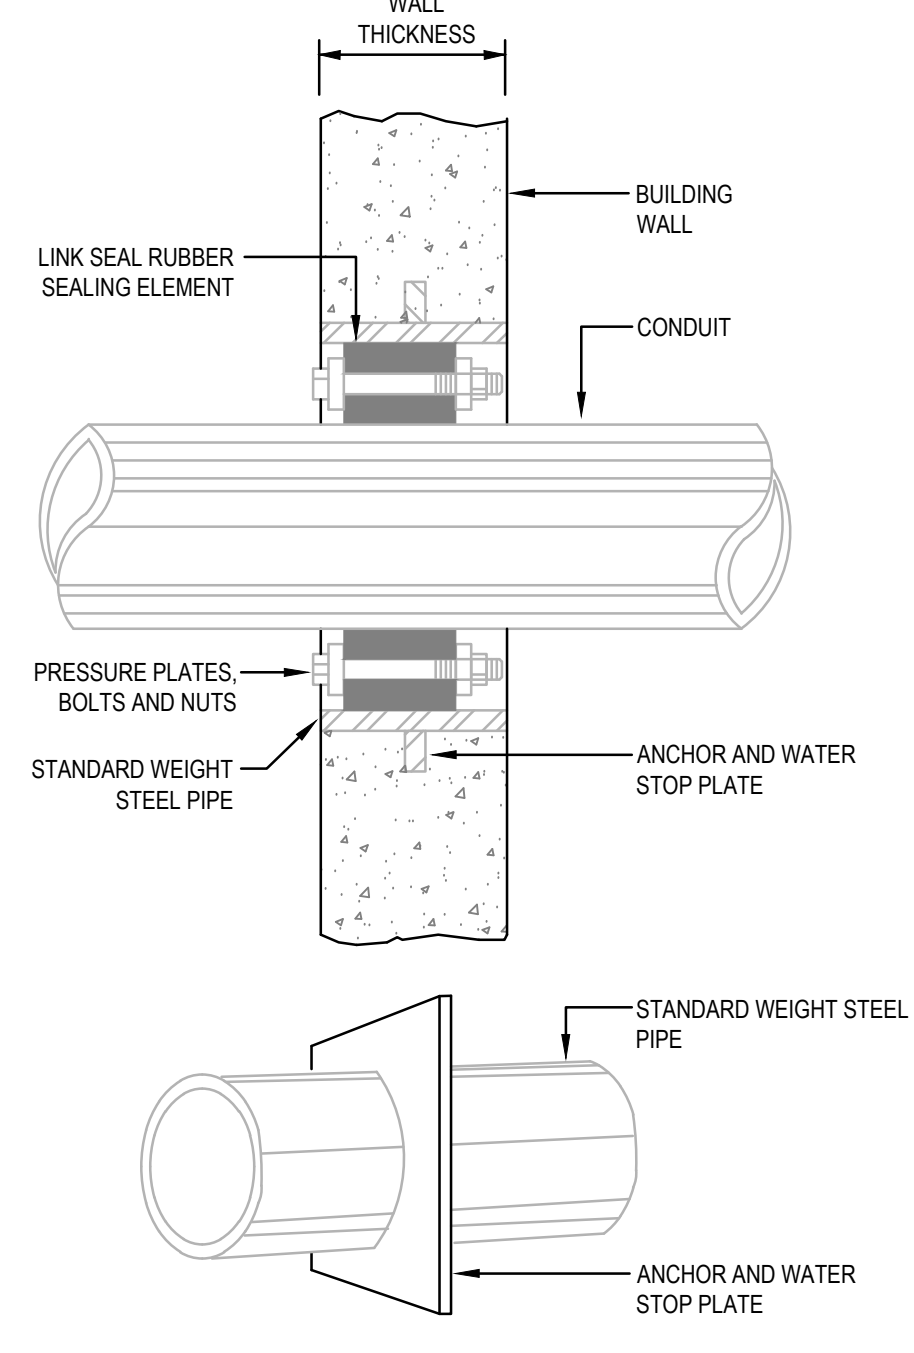


4 WATER-TIGHT WALL SLEEVE  
SCALE: NONE

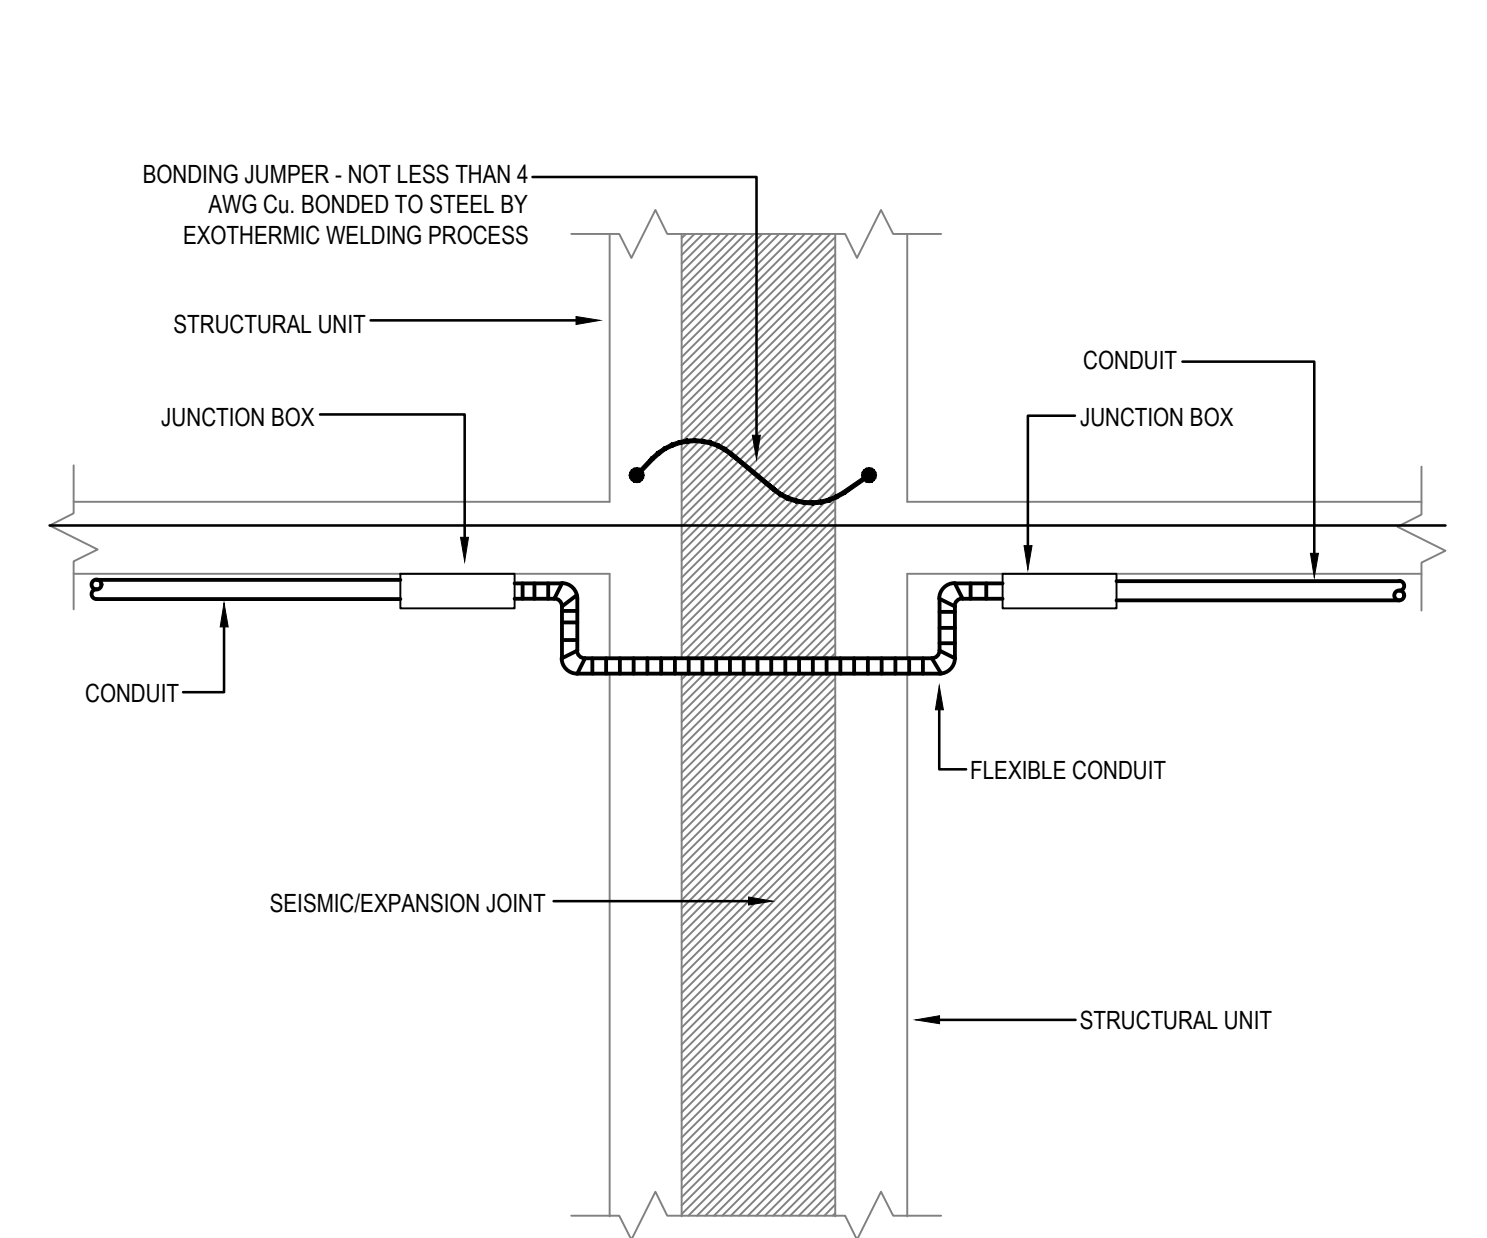


5 EXPANSION/SEISMIC JOINT FITTING DETAIL  
SCALE: NONE

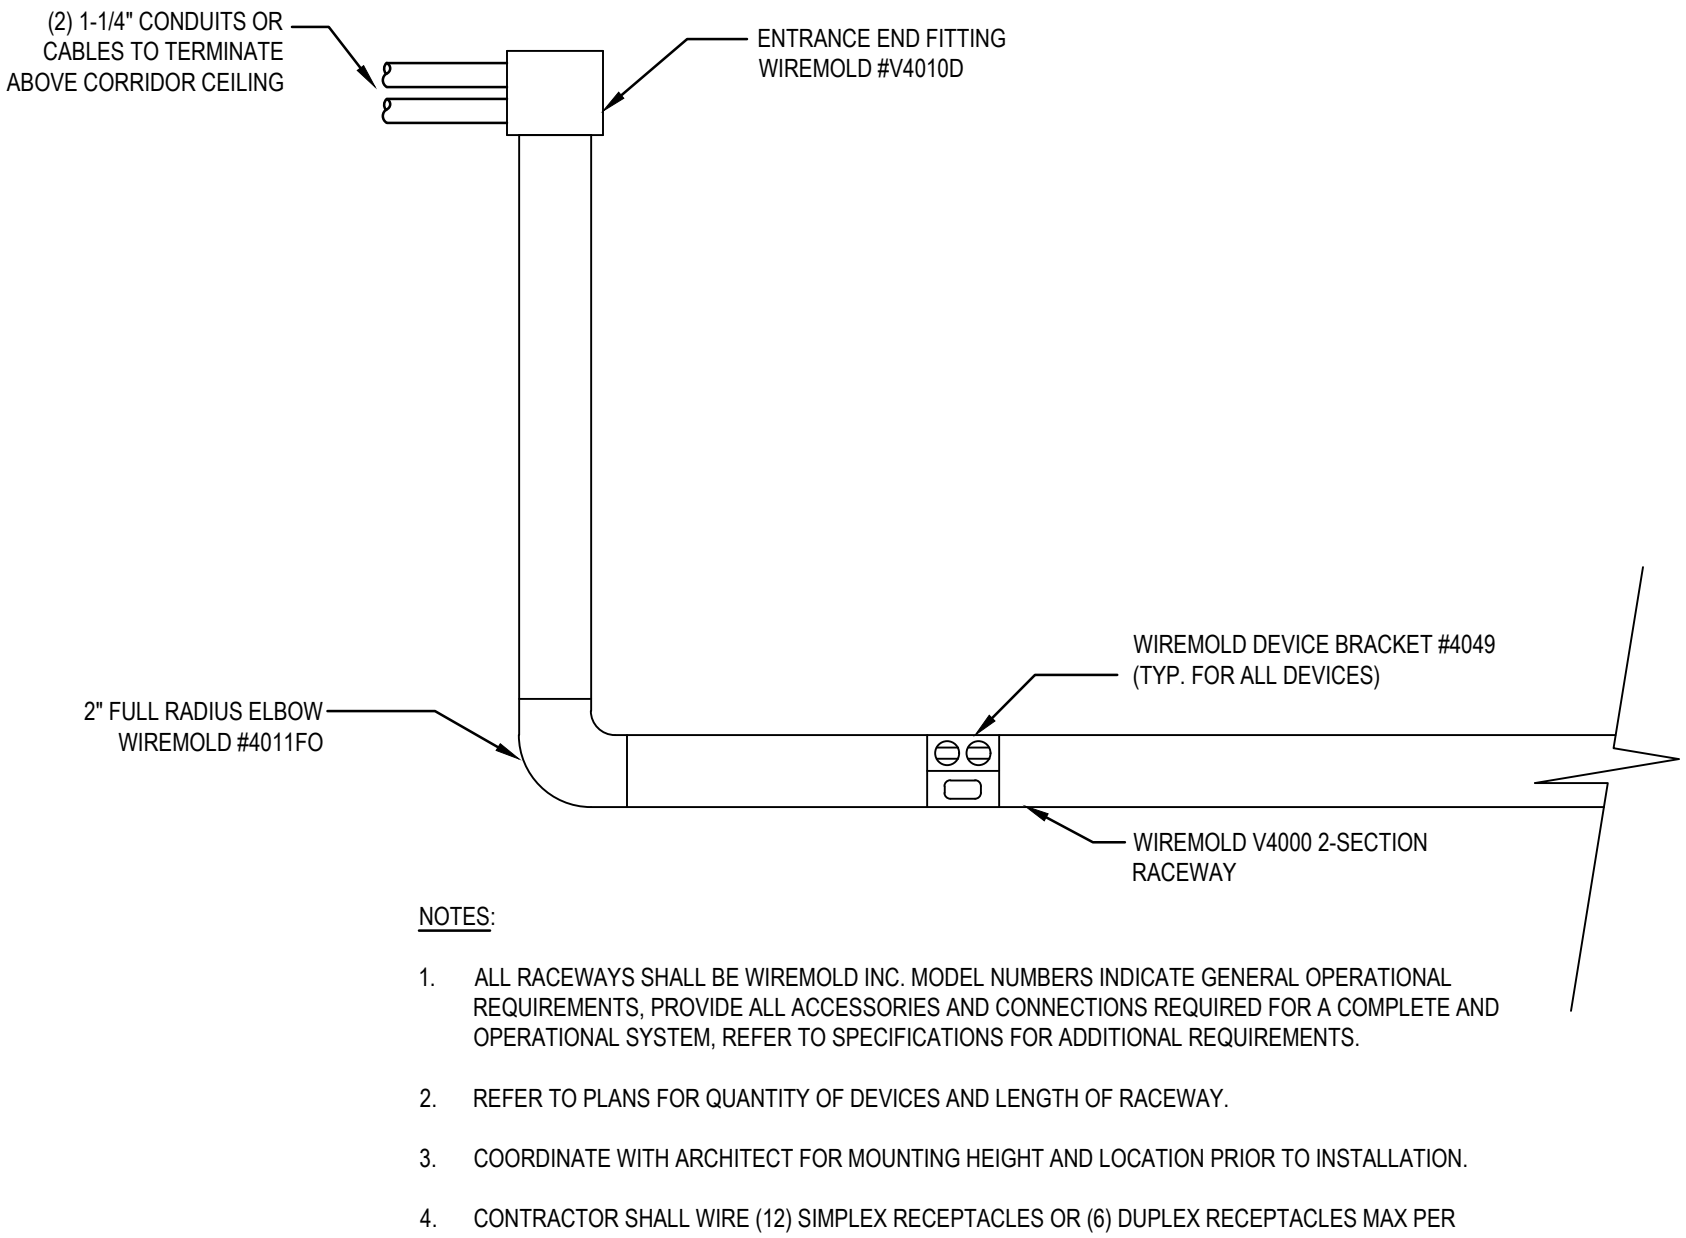


6 TYPICAL MULTI SERVICE RACEWAY DETAIL  
SCALE: NONE

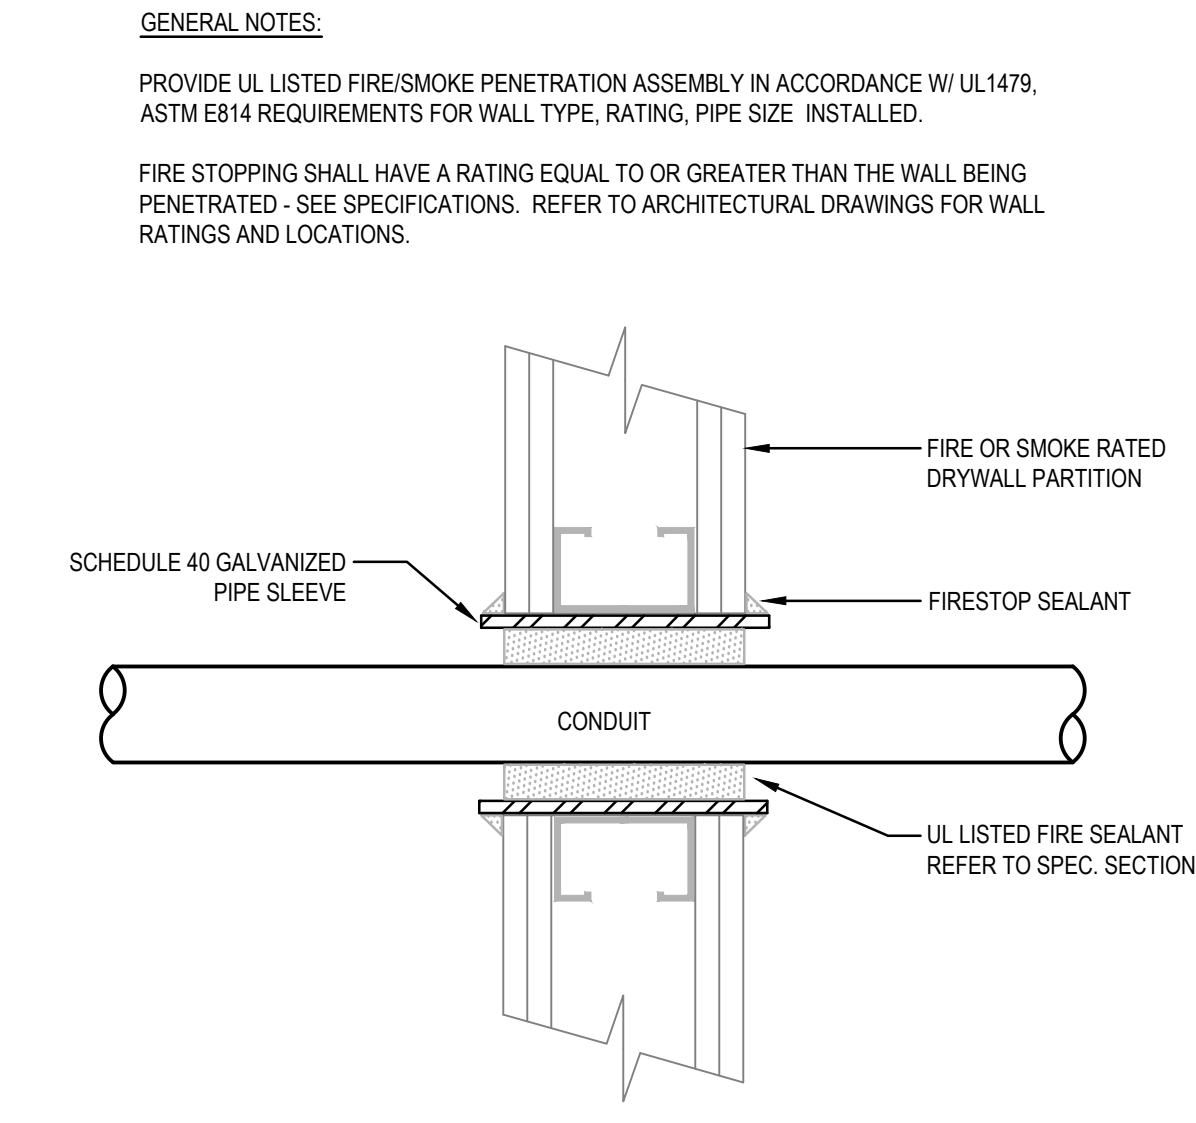


7 WALL PENETRATION W/FIRE-SMOKE SEAL DETAIL  
SCALE: NONE

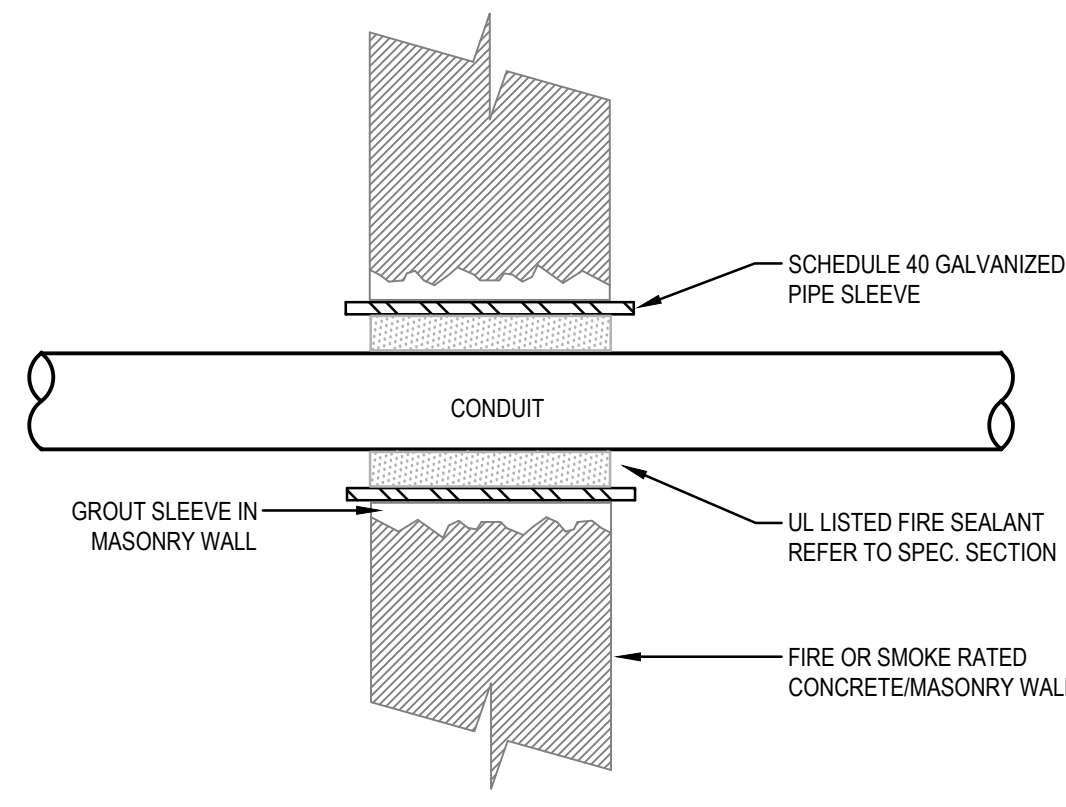


8 TYPICAL LAY-IN GRID LIGHTING FIXTURE  
SUPPORT/MOUNTING DETAIL  
SCALE: NONE

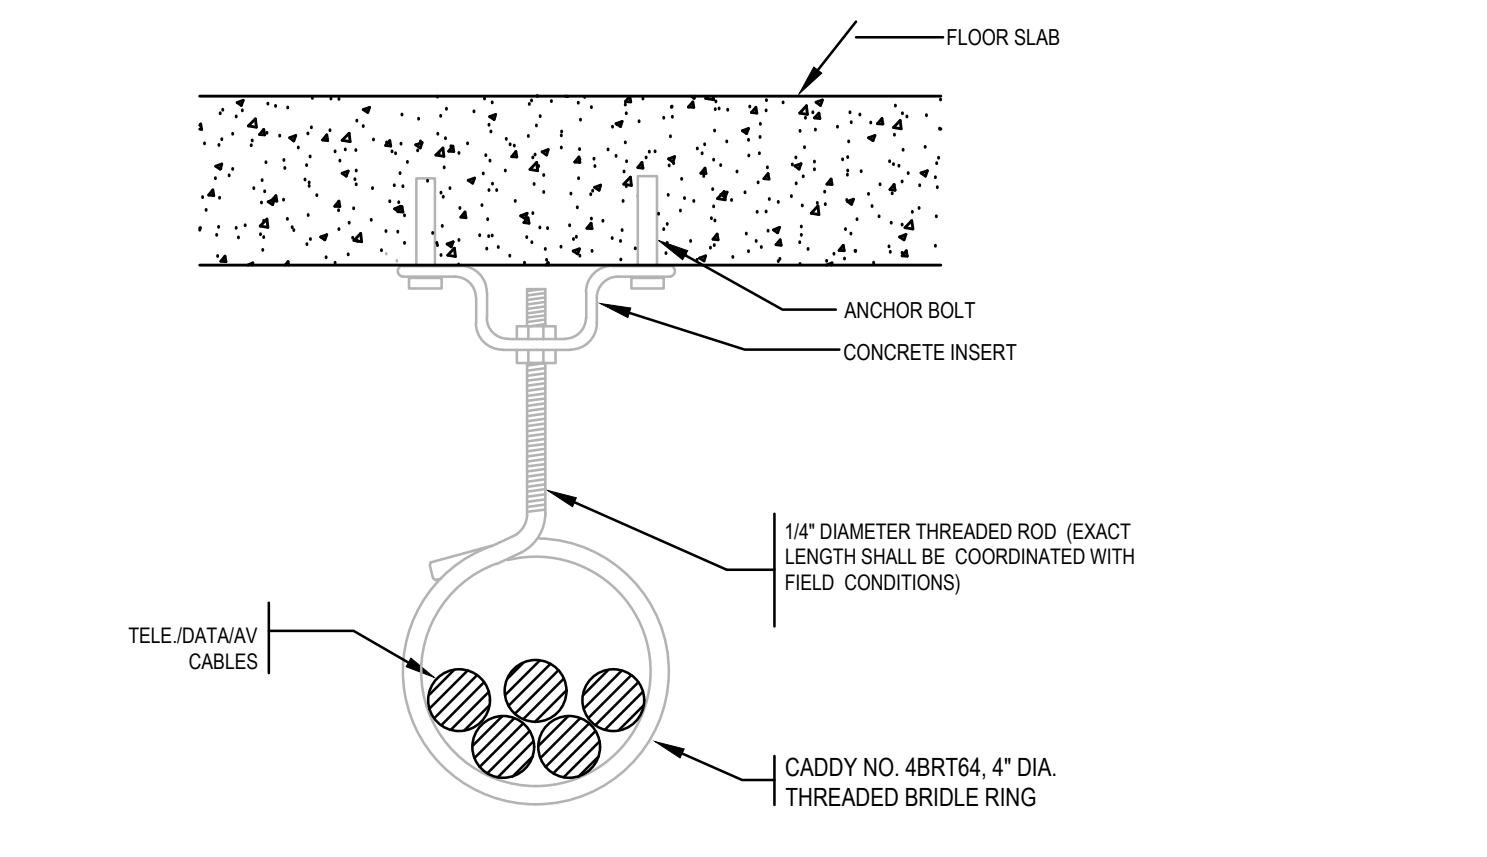


9 CABLE RING DETAIL  
SCALE: NONE

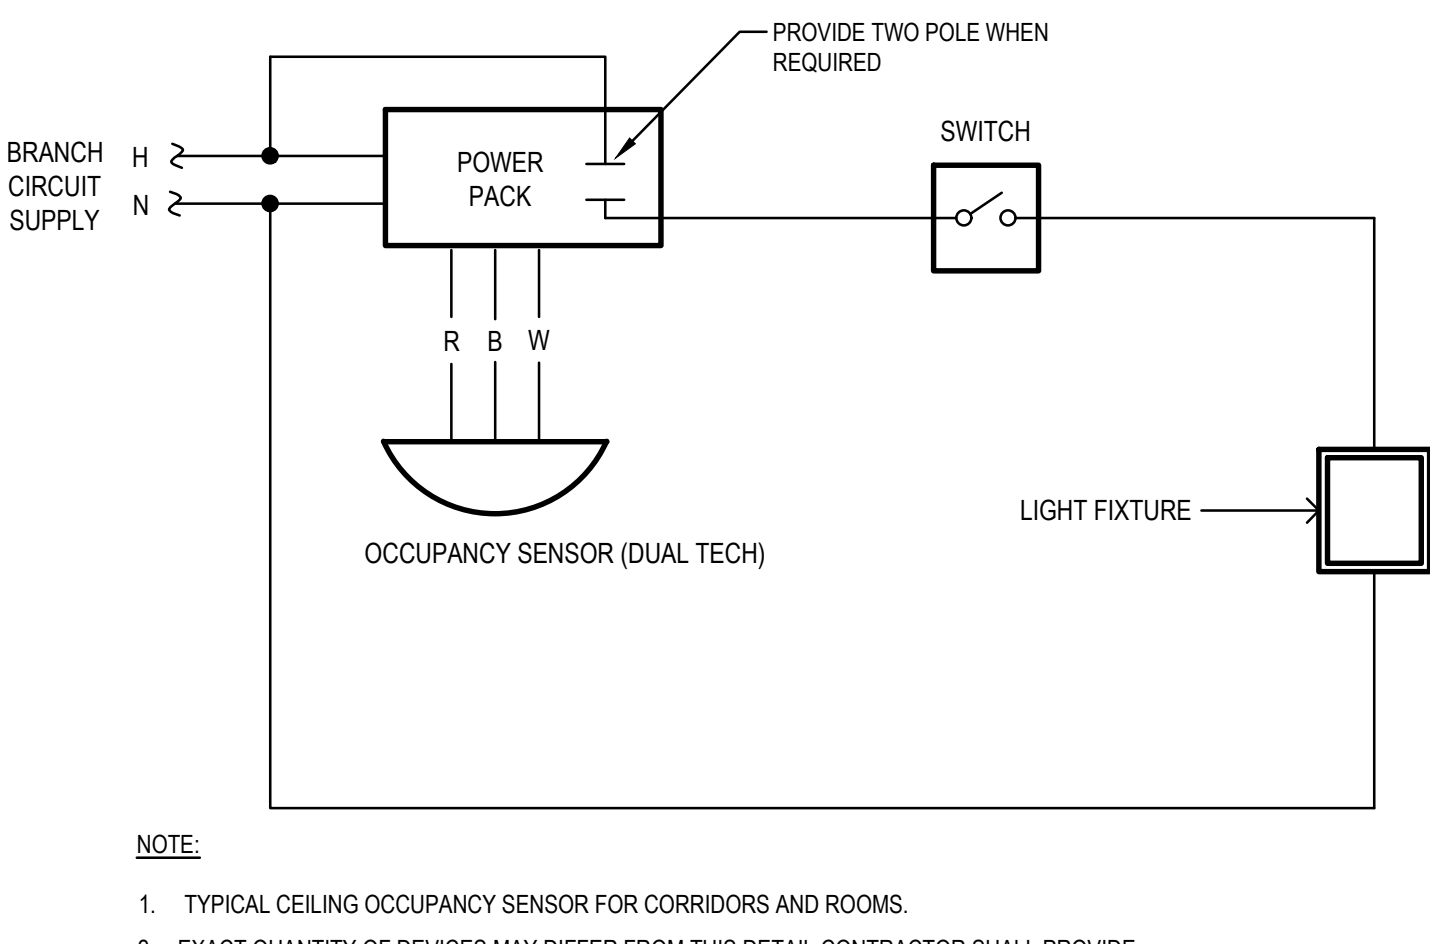


10 CEILING OCCUPANCY SENSOR DETAIL  
SCALE: NONE

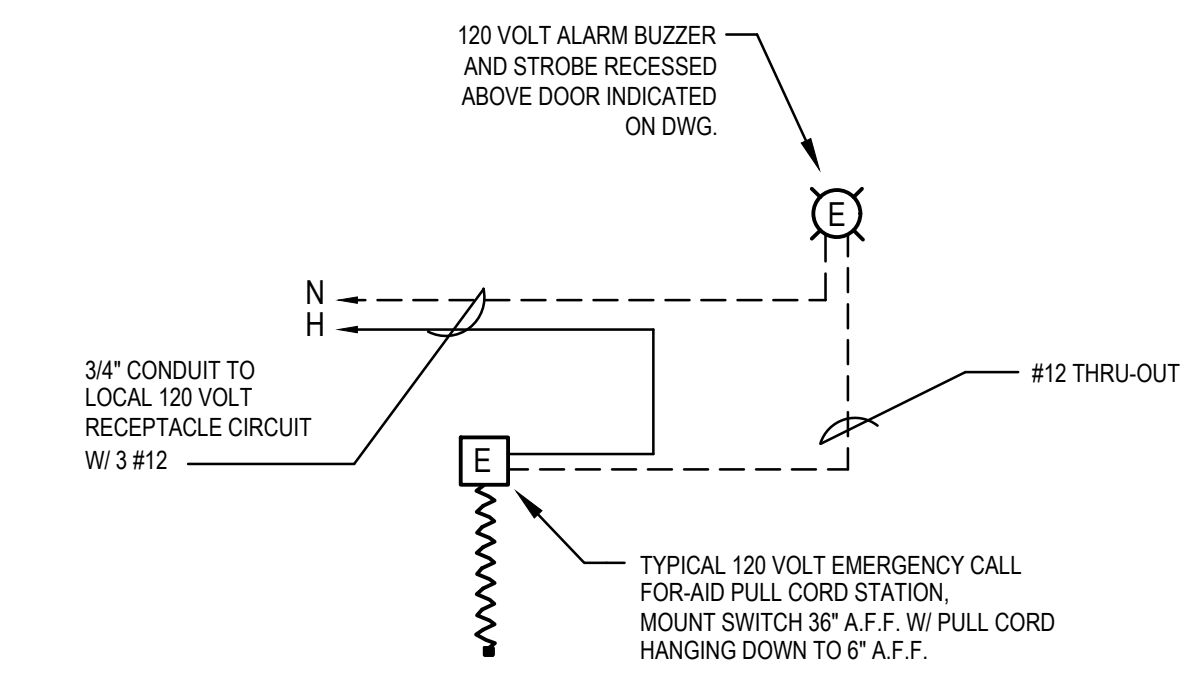

11 HANDICAPPED CALL-FOR-AID SYSTEM  
SCALE: NONE

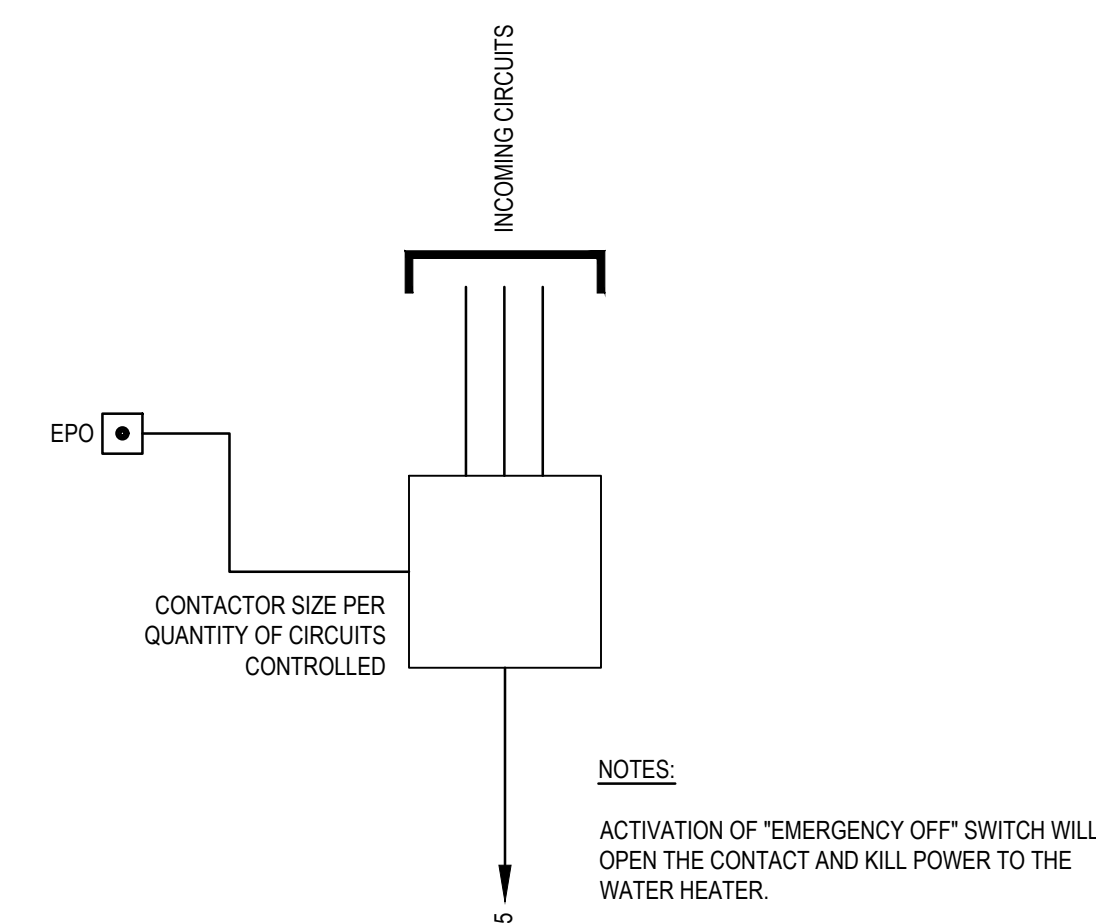


12 GAS WATER HEATER E.P.O. WIRING DIAGRAM  
SCALE: NONE

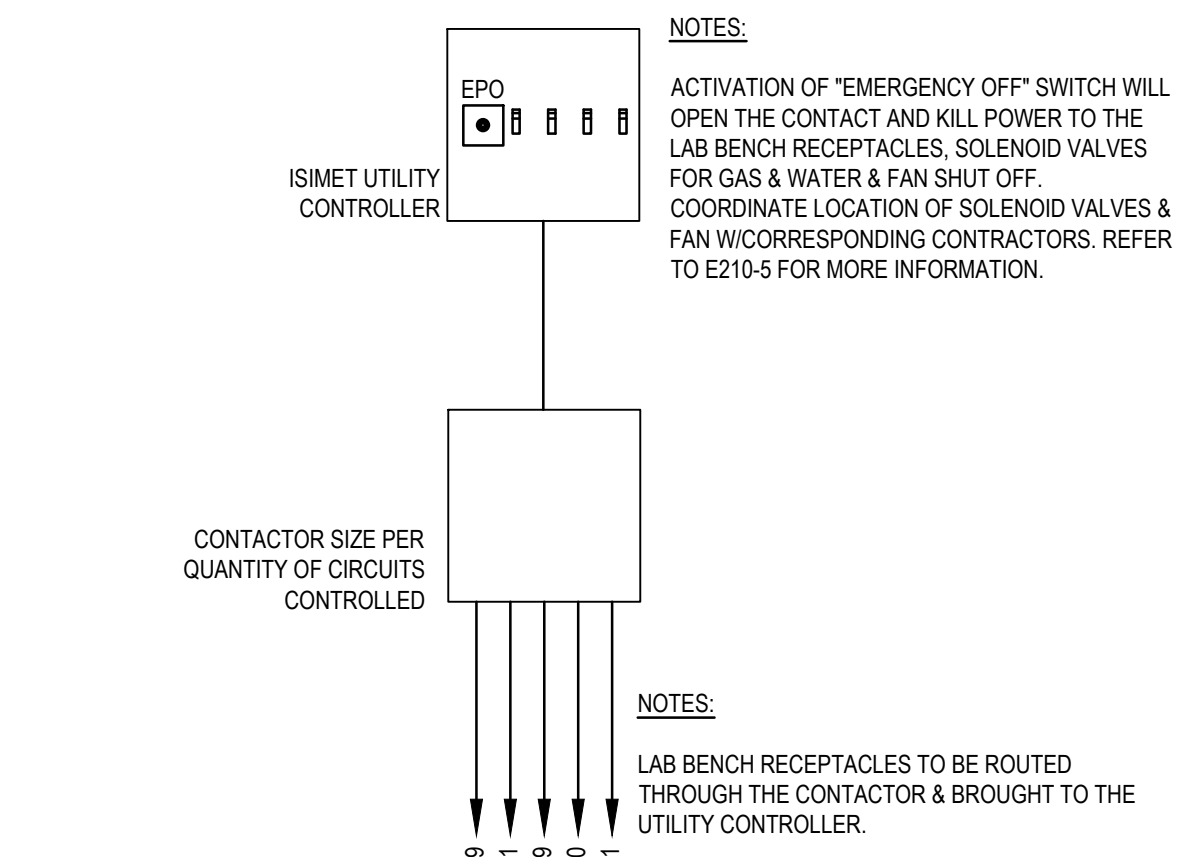

13 BIOMEDICAL LAB UTC E.P.O. WIRING DIAGRAM  
SCALE: NONE

Project Title:  
ALTERATIONS TO:  
ACES at Chase  
565 Chase Parkway  
Waterbury, Connecticut 06708

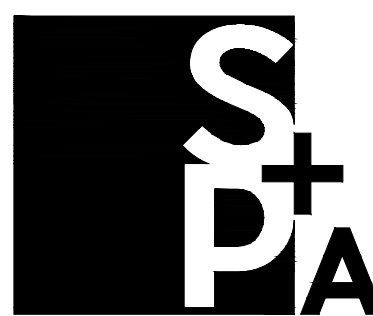

SILVER PETRUCCELLI + ASSOCIATES  
3190 WHITNEY AVENUE HAMDEN CT 06518  
311 STATE STREET NEW LONDON CT 06320  
203 230 9007 silverpetrucci.com


Revision:	Description:	Date:	Revised By:
1	Bulletin #1	12/16/25	MTC

Drawing Title:  
BUILDING 5 - DETAILS


Project Phase:  
ISSUED FOR BID - 11/03/2025  
State Project Number:  
#244-0044 MAG

Date:  
AUGUST 12, 2025  
Scale:  
AS NOTED  
Drawn By:  
MTC  
Project Number:  
22.050


E400-5

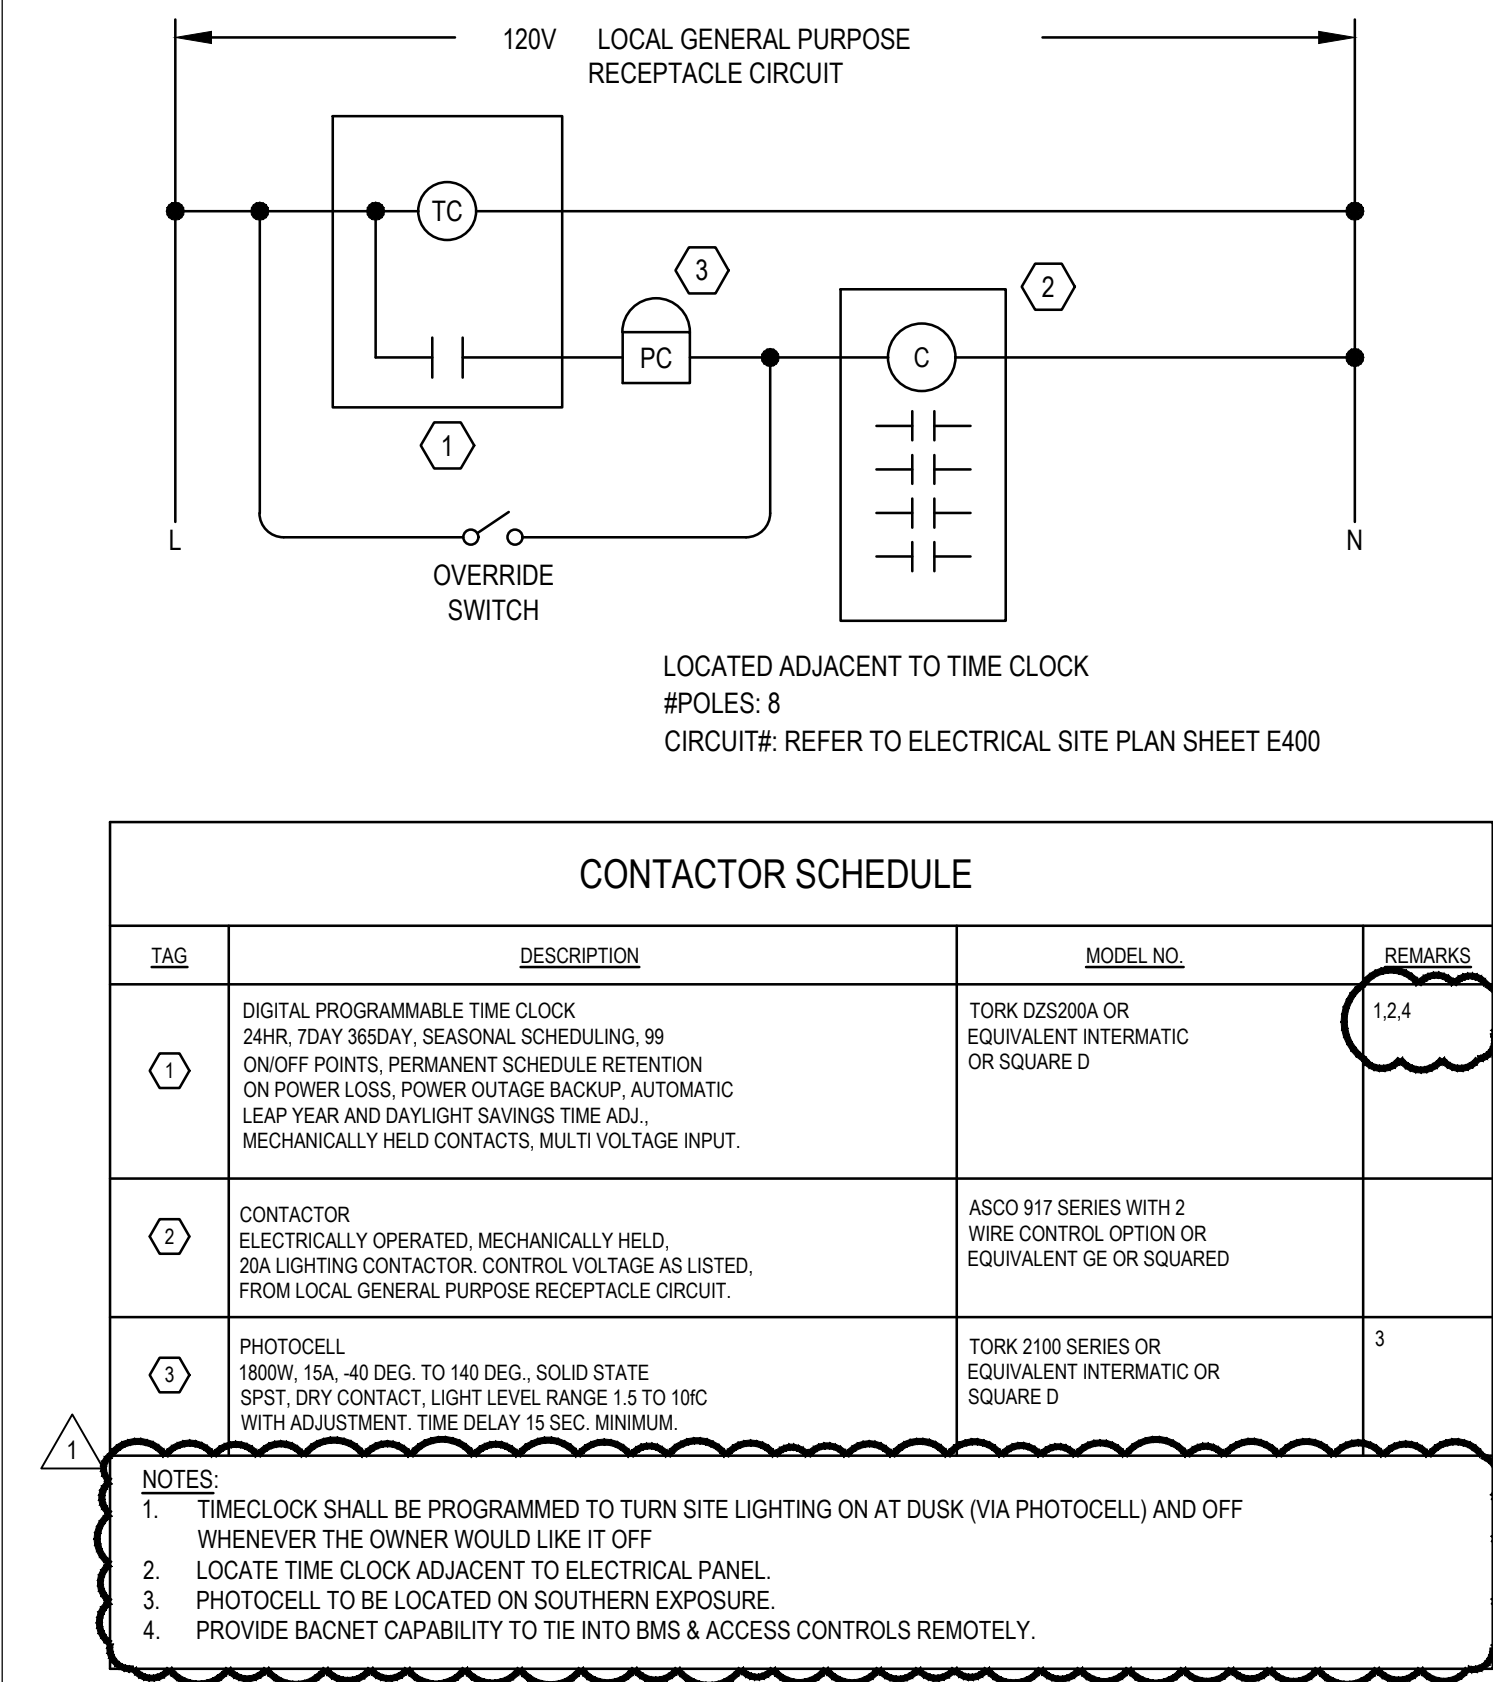

1 LIGHTING TIME CLOCK & CONTACTOR DETAIL  
SCALE: NONE

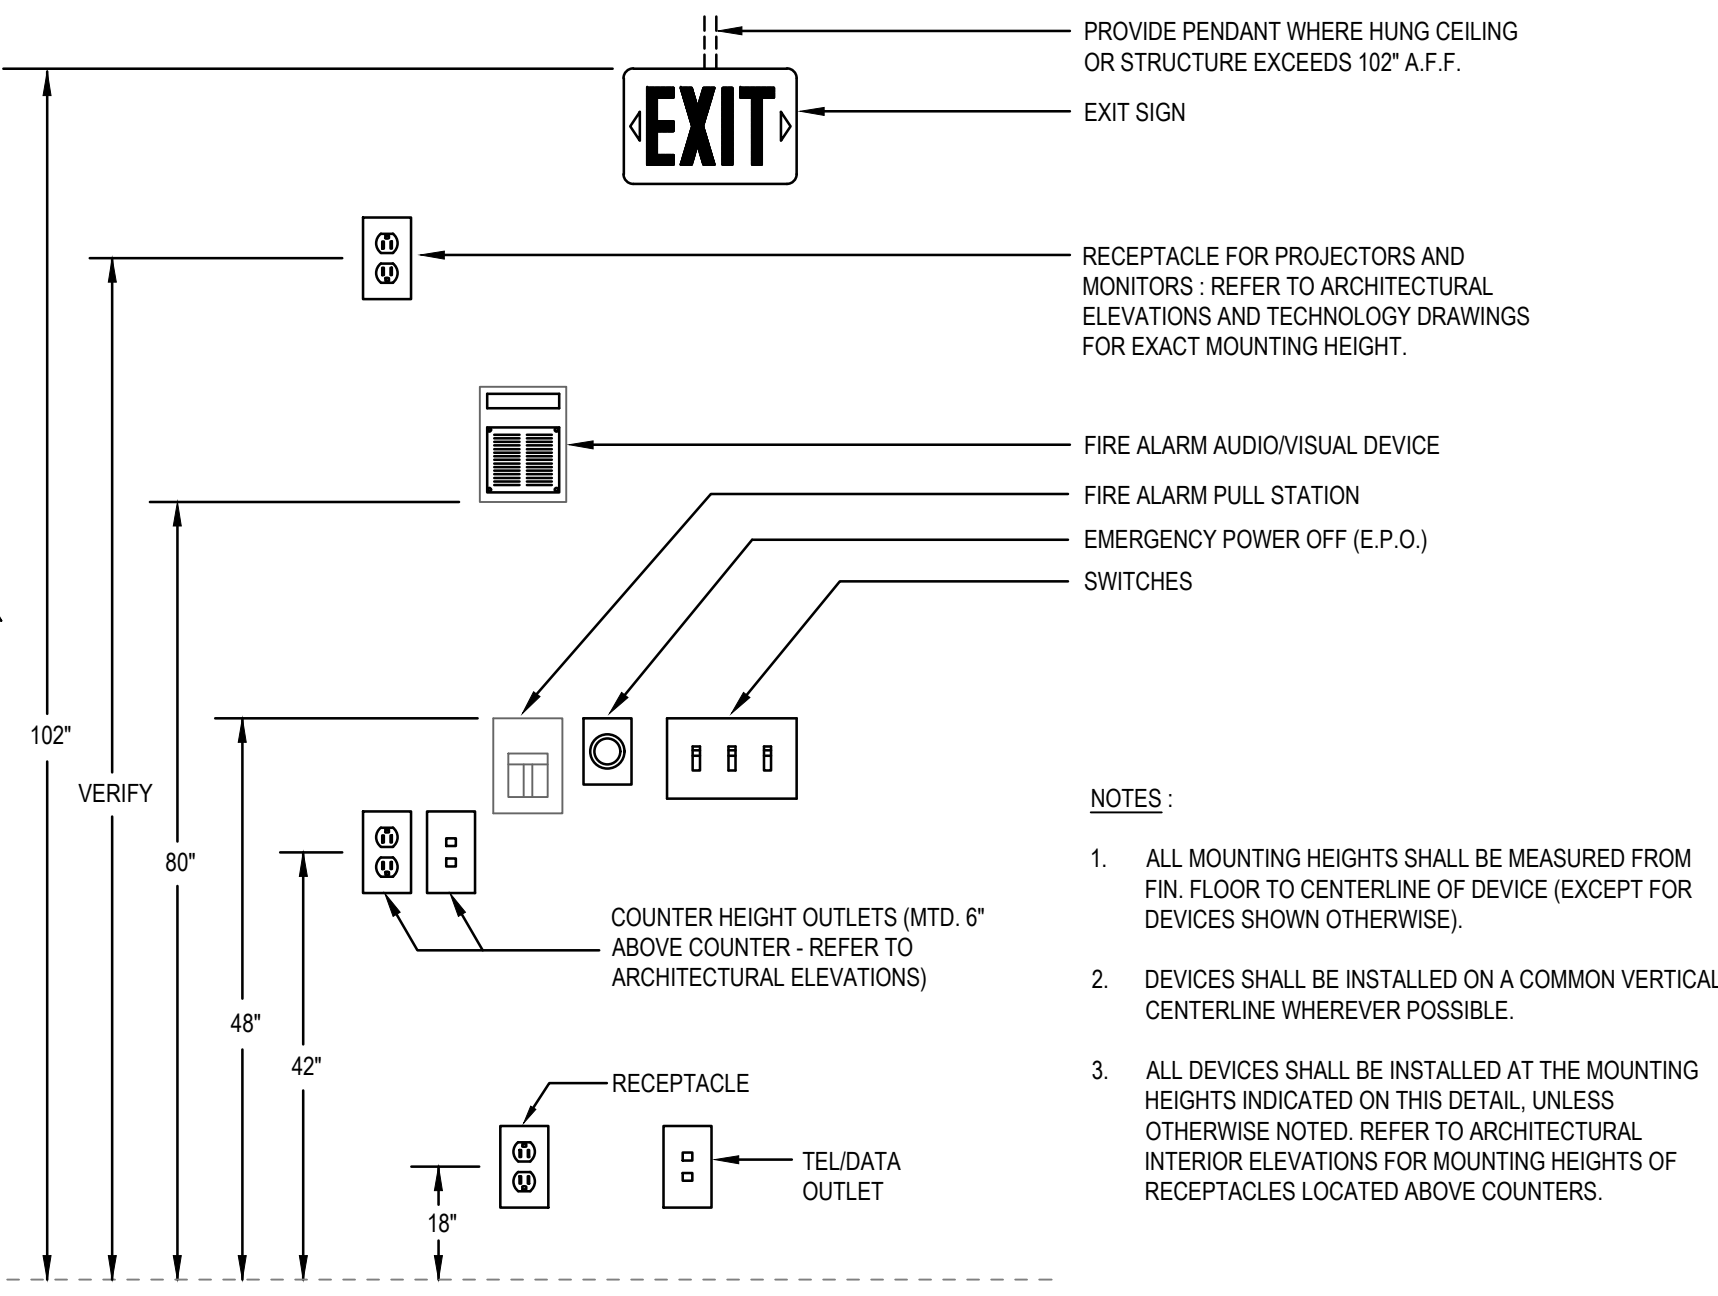

2 TYPICAL DEVICE MOUNTING HEIGHT DETAIL  
SCALE: NONE

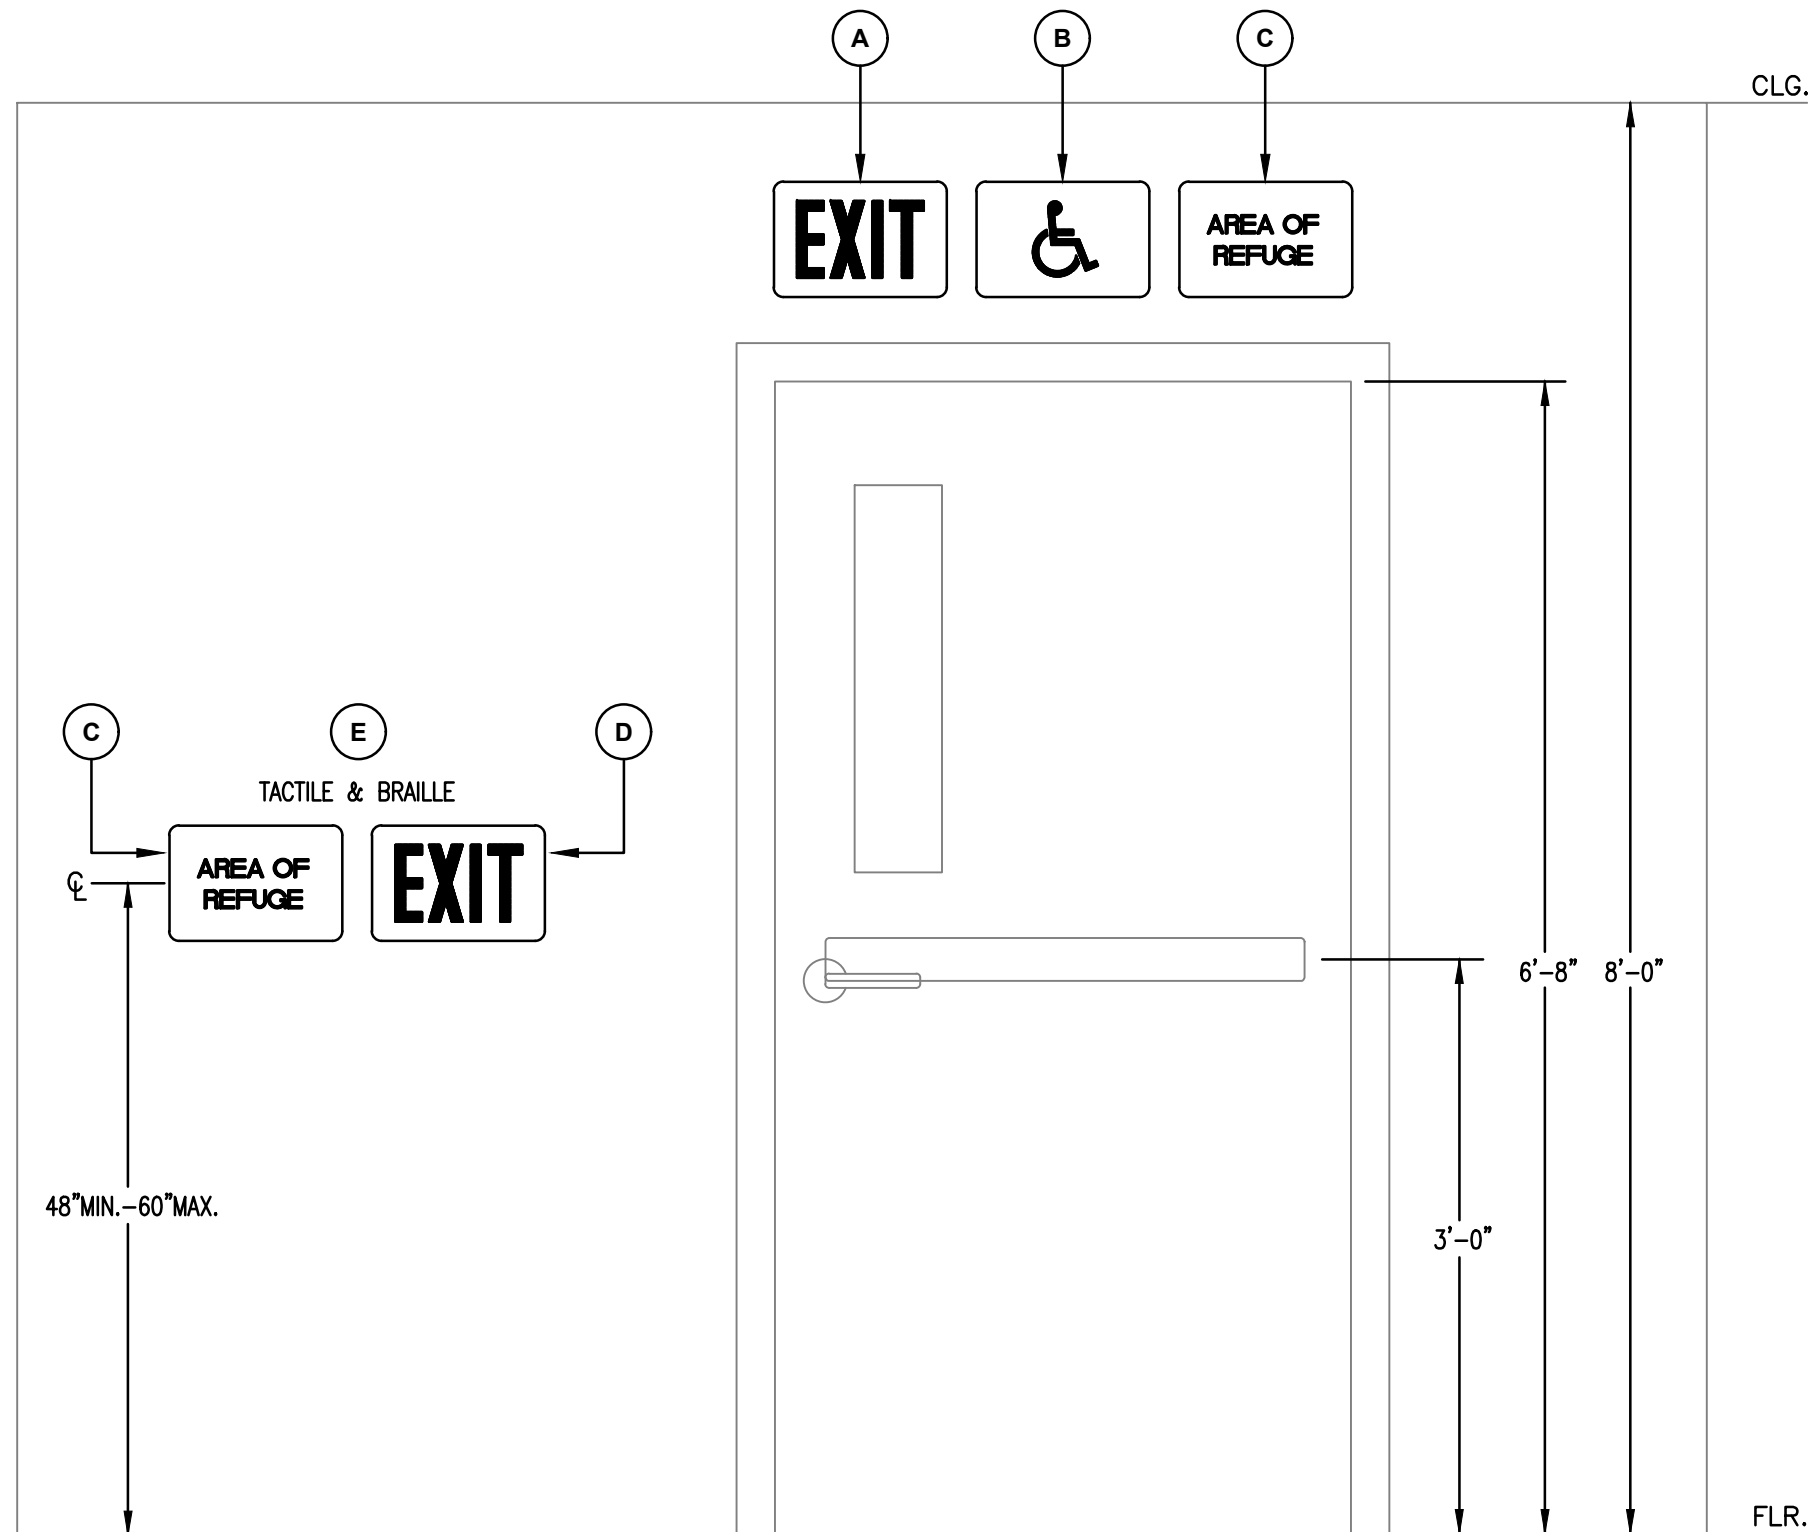

3 EXIT SIGN MOUNTING DETAIL  
SCALE: NONE

NOTES IN ACCORDANCE WITH 2022 CONNECTICUT STATE BUILDING CODE:

(A) SECTION 1011.1: WHERE REQUIRED, EXITS AND EXIT ACCESS DOORS SHALL BE MARKED BY AN APPROVED EXIT SIGN READILY VISIBLE FROM ANY DIRECTION OF EGRESS TRAVEL. ACCESS TO EXITS SHALL BE MARKED BY READILY VISIBLE EXIT SIGNS IN CASES WHERE THE EXIT OR THE PATH OF EGRESS TRAVEL IS NOT IMMEDIATELY VISIBLE TO THE OCCUPANTS. EXIT SIGN PLACEMENT SHALL BE SUCH THAT NO POINT IN AN EXIT ACCESS CORRIDOR IS MORE THAN 100 FEET OF THE LISTED VIEWING DISTANCE FOR THE SIGN, WHICH IS LESS, FROM THE NEAREST VISIBLE EXIT SIGN.

(B) SECTION 1011.2: ILLUMINATION. EXIT SIGNS SHALL BE INTERNALLY OR EXTERNALLY ILLUMINATED. EXCEPTION: TACTILE SIGNS REQUIRED BY SECTION 1011.3 NEED NOT BE PROVIDED WITH ILLUMINATION.


(C) CT 2022 AMENDMENT SECTION 1011.1.2 ACCESSIBLE EXITS: WHERE EXIT SIGNS ARE REQUIRED BY SECTION 1011.1 OF THIS CODE, ACCESSIBLE EXIT DOORS AT THE LEVEL OF EXIT DISCHARGE THAT LEAD DIRECTLY TO ACCESSIBLE PATHS OF EXIT DISCHARGE SHALL ADDITIONALLY BE MARKED BY THE INTERNATIONAL SYMBOL OF ACCESSIBILITY. SUCH SYMBOL SHALL BE NOT LESS THAN 6 INCHES HIGH AND SHALL BE INCORPORATED INTO THE REQUIRED EXIT SIGN OR SHALL BE LOCATED DIRECTLY ADJACENT TO IT. SUCH SYMBOL SHALL MEET THE REQUIREMENTS OF SECTION 1011.

(D) SECTION 1007.6.5: IDENTIFICATION. EACH DOOR PROVIDING ACCESS TO AN AREA OF REFUGE FROM AN ADJACENT FLOOR AREA SHALL BE IDENTIFIED BY A SIGN COMPLYING WITH ICC A117.1, STATING: AREA OF REFUGE AND INCLUDING THE INTERNATIONAL SYMBOL OF ACCESSIBILITY. WHERE EXIT SIGN ILLUMINATION IS REQUIRED BY SECTION 1011.2, THE AREA OF REFUGE SIGN SHALL BE ILLUMINATED.


(E) ADDITIONALLY, TACTILE SIGNAGE COMPLYING WITH ICC A117.1 SHALL BE LOCATED AT EACH DOOR TO AN AREA OF REFUGE. (TACTILE AND BRAILLE IS REQUIRED ON TACTILE SIGNAGE. ANSI A117.1-2003, 703.3 AND 703.4).

(F) SECTION 1011.3: TACTILE EXIT SIGNS. A TACTILE EXIT SIGN STATING EXIT AND COMPLYING WITH ICC A117.1 SHALL BE PROVIDED ADJACENT TO EACH DOOR TO AN EGRESS STAIRWAY, AN EXIT PASSAGEWAY AND THE EXIT DISCHARGE. (TACTILE AND BRAILLE IS REQUIRED ON TACTILE SIGNAGE. ANSI A117.1-2003, 703.3 AND 703.4).


(G) CT 2022 AMENDMENT SECTION 1110.4: INTERIOR SIGNAGE. INTERIOR SIGNS DESIGNATE PERMANENT ROOMS AND SPACES SHALL BE RAISED TEXT CHARACTERS AND BRAILLE, DESIGNED AND LOCATED IN ACCORDANCE WITH ICC/ANSI A117.1-2003. MOUNTING LOCATION FOR SIGNAGE SHALL BE SUCH THAT ANY PERSON APPROACHING THE SIGNAGE WILL NOT ENCOUNTER PROTRUDING OBJECTS, OR STAND WITHIN THE SWING OF ANY DOOR. (STAIR INFORMATION SIGNAGE IS REQUIRED IN TACTILE AND BRAILLE. ANSI A117.1-2003, 703.3 AND 703.4).

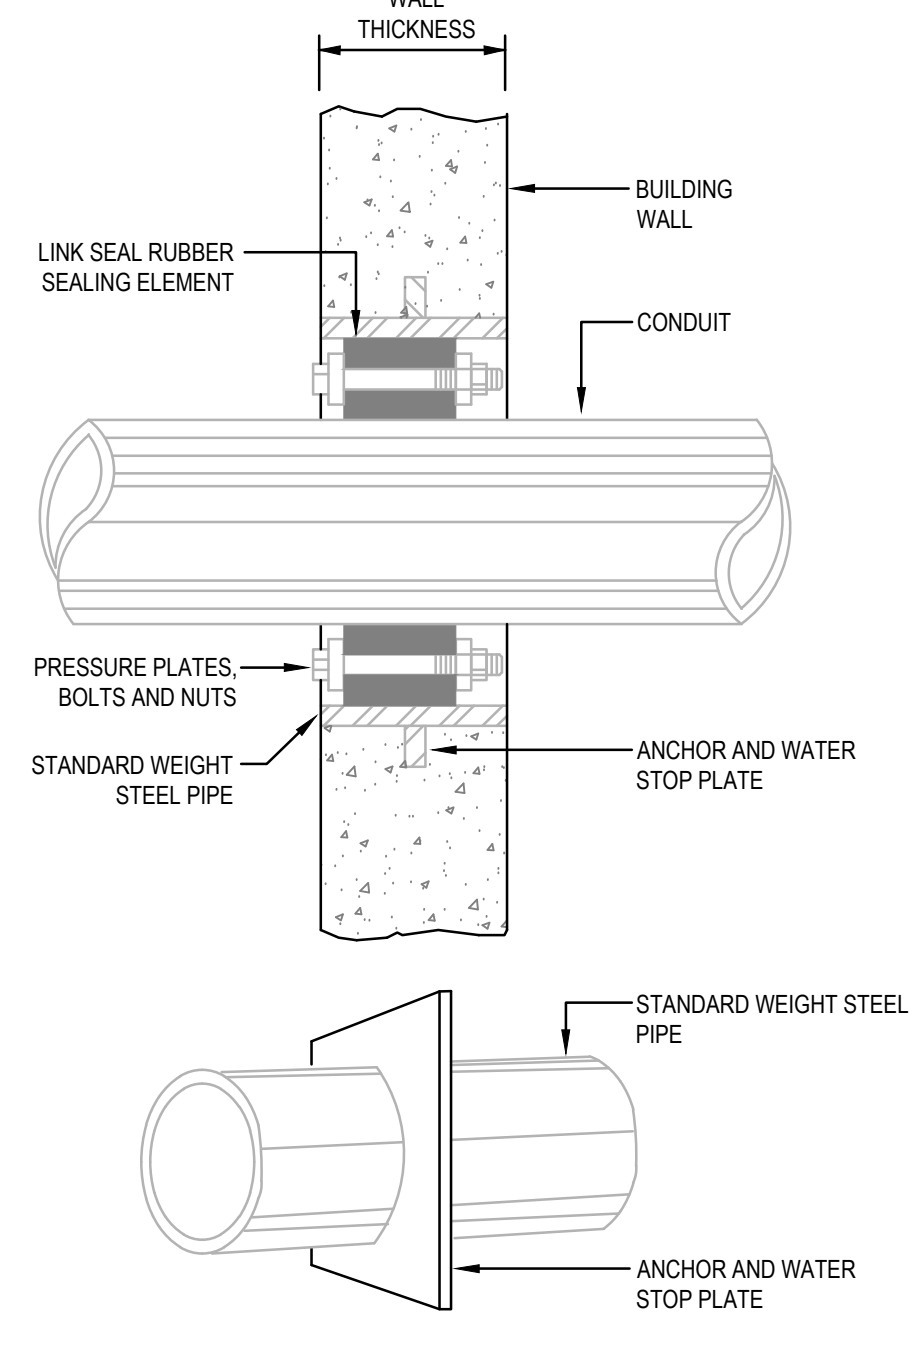


4 WATER-TIGHT WALL SLEEVE  
SCALE: NONE

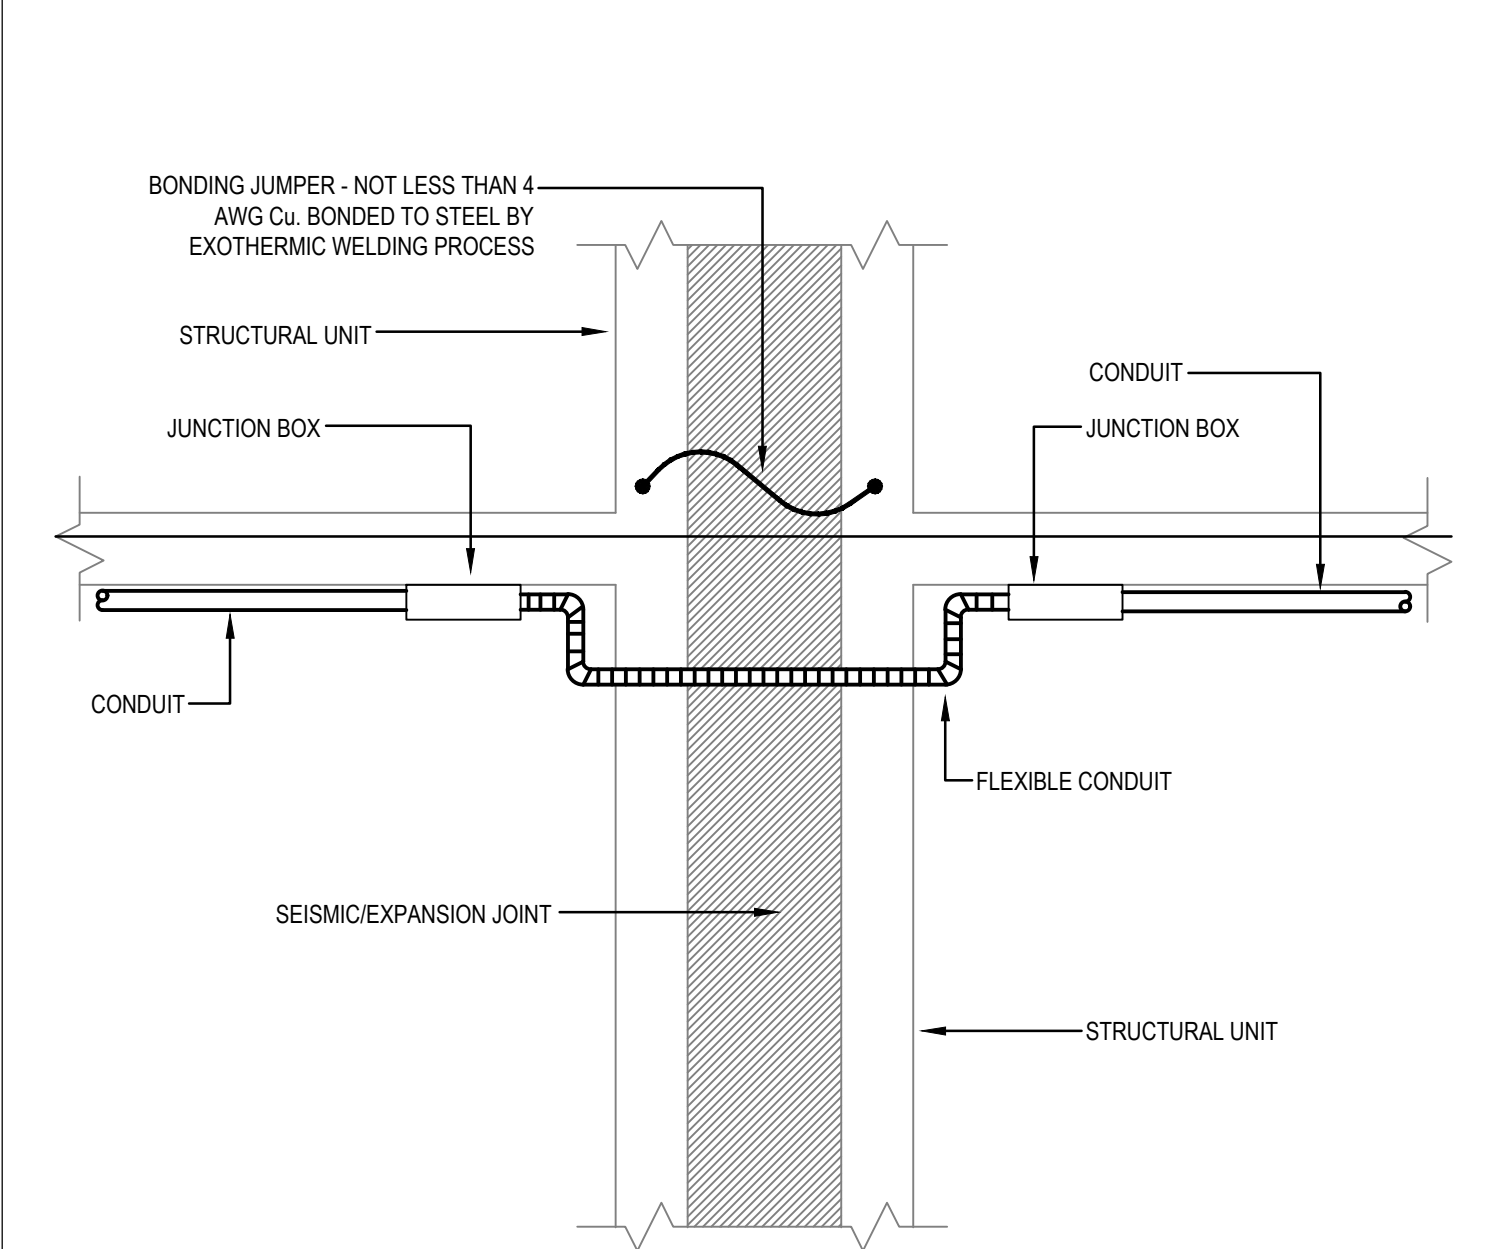


5 EXPANSION/SEISMIC JOINT FITTING DETAIL  
SCALE: NONE

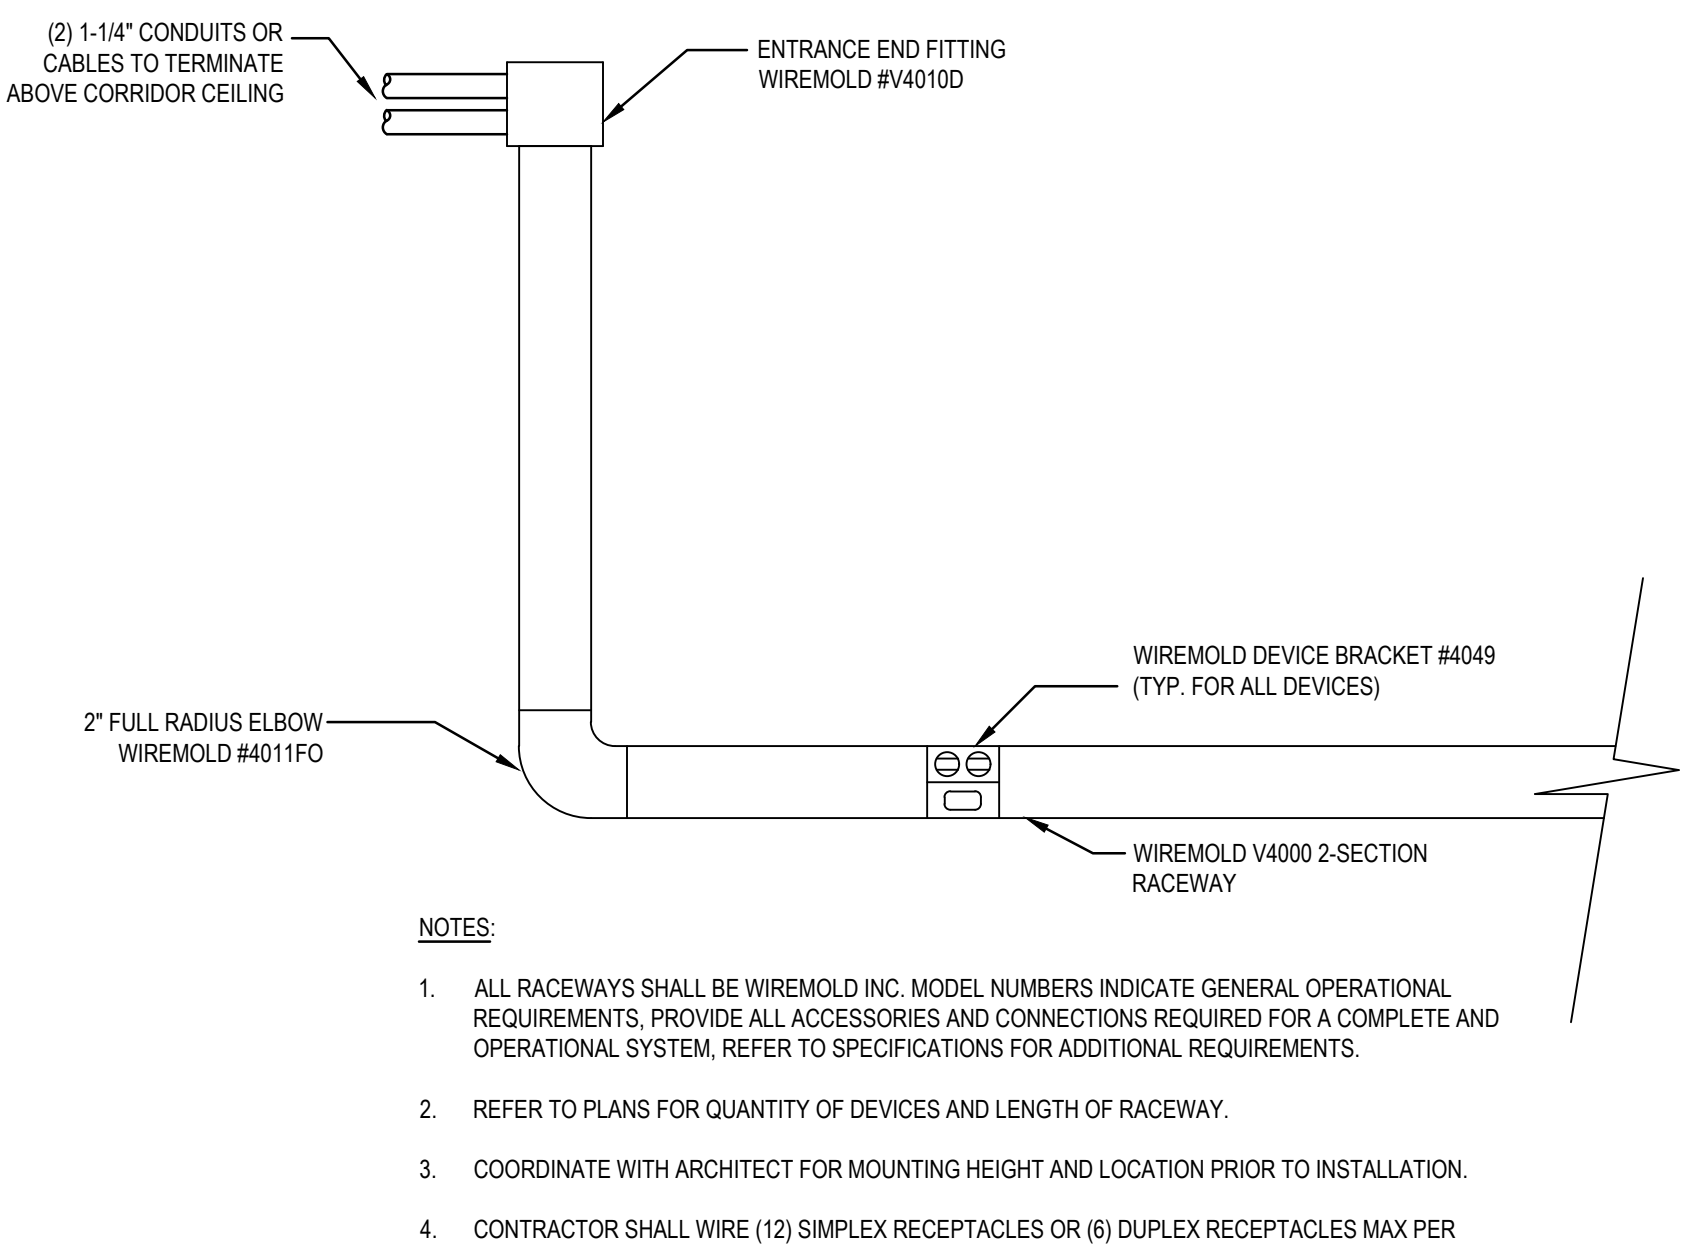



6 TYPICAL MULTI SERVICE RACEWAY DETAIL  
SCALE: NONE

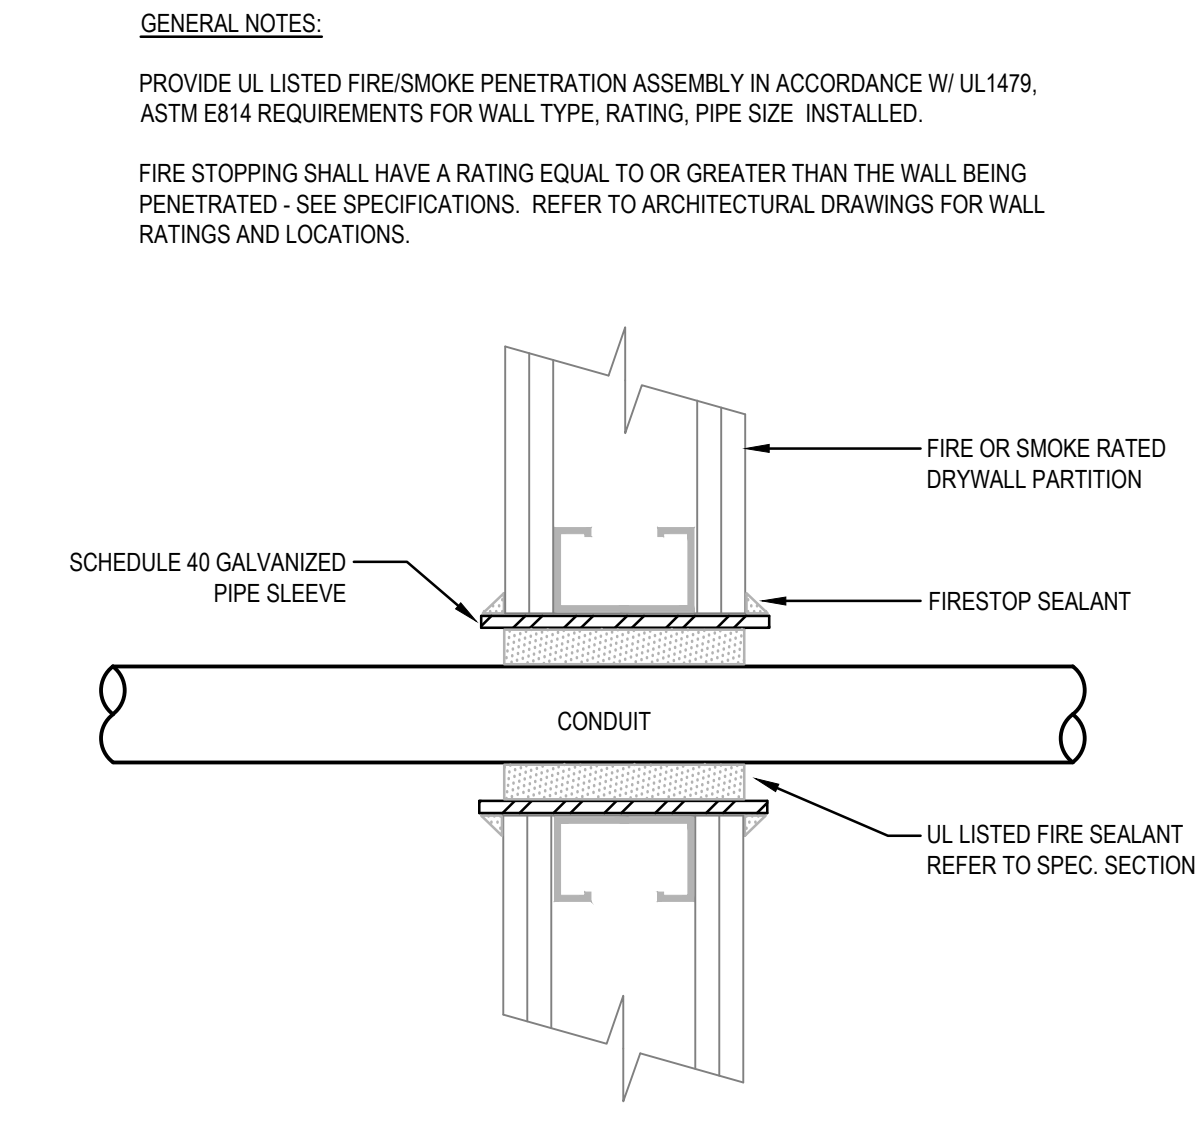


7 WALL PENETRATION W/FIRE-SMOKE SEAL DETAIL  
SCALE: NONE

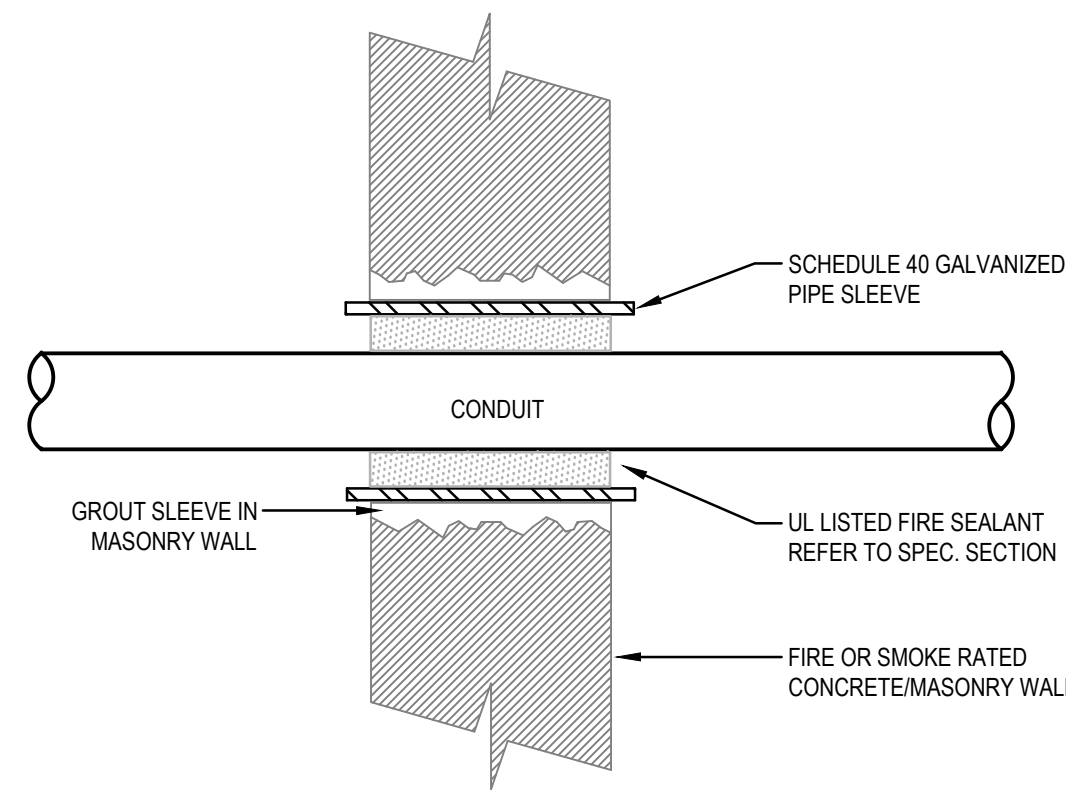


8 TYPICAL LAY-IN GRID LIGHTING FIXTURE SUPPORT/MOUNTING DETAIL  
SCALE: NONE

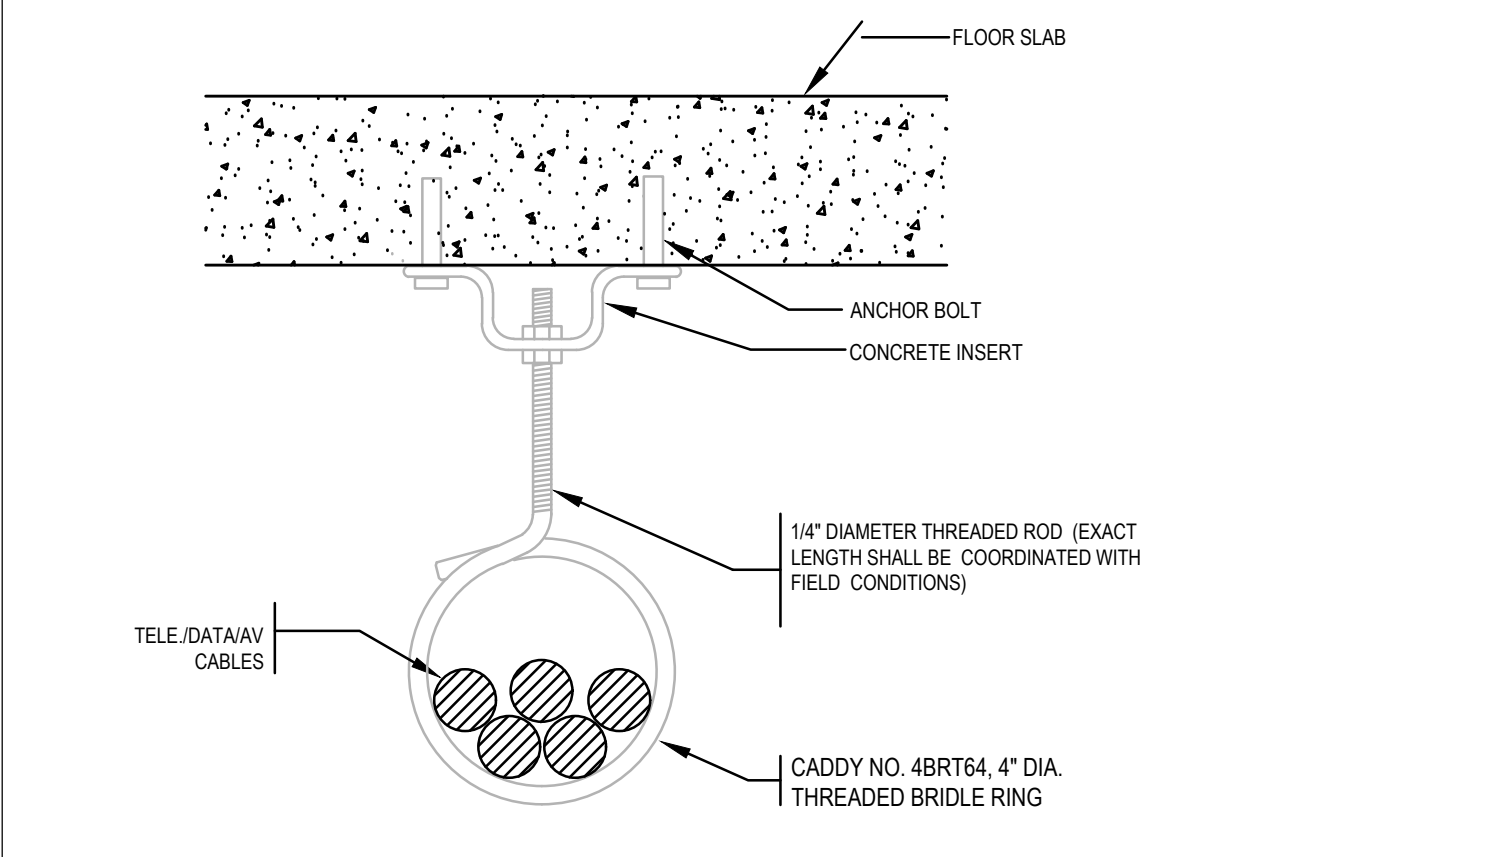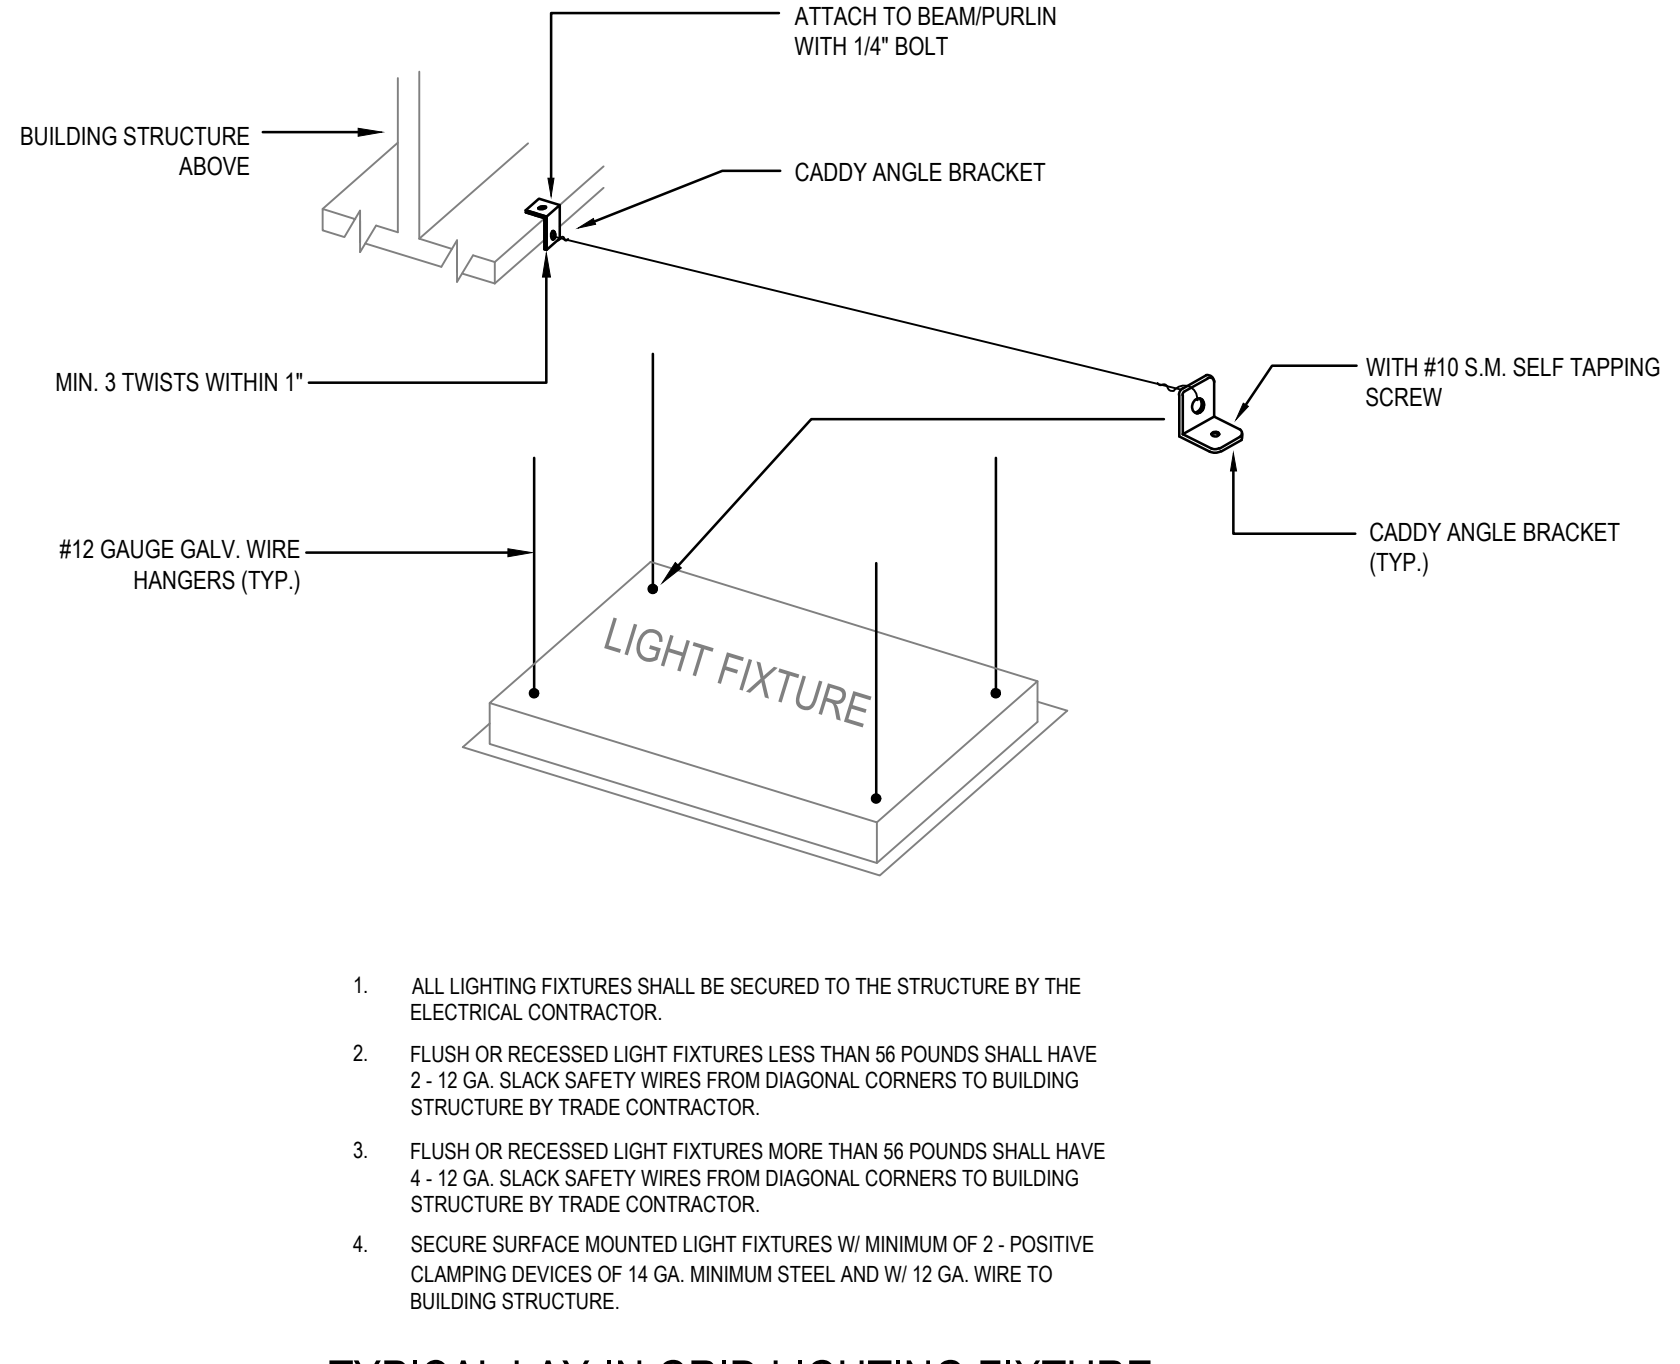


9 CABLE RING DETAIL  
SCALE: NONE

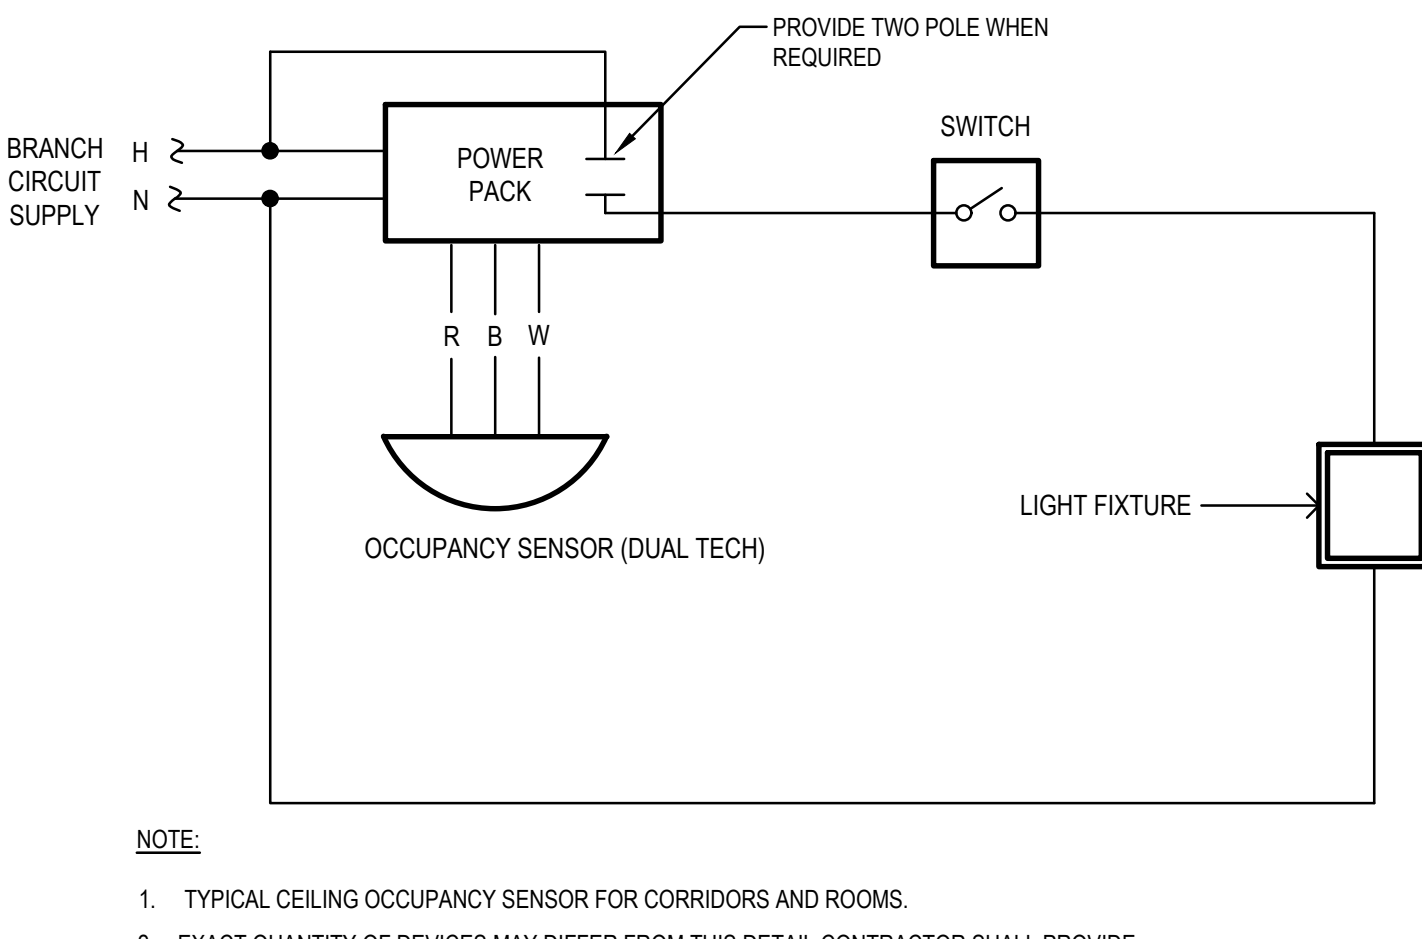

10 CEILING OCCUPANCY SENSOR DETAIL  
SCALE: NONE

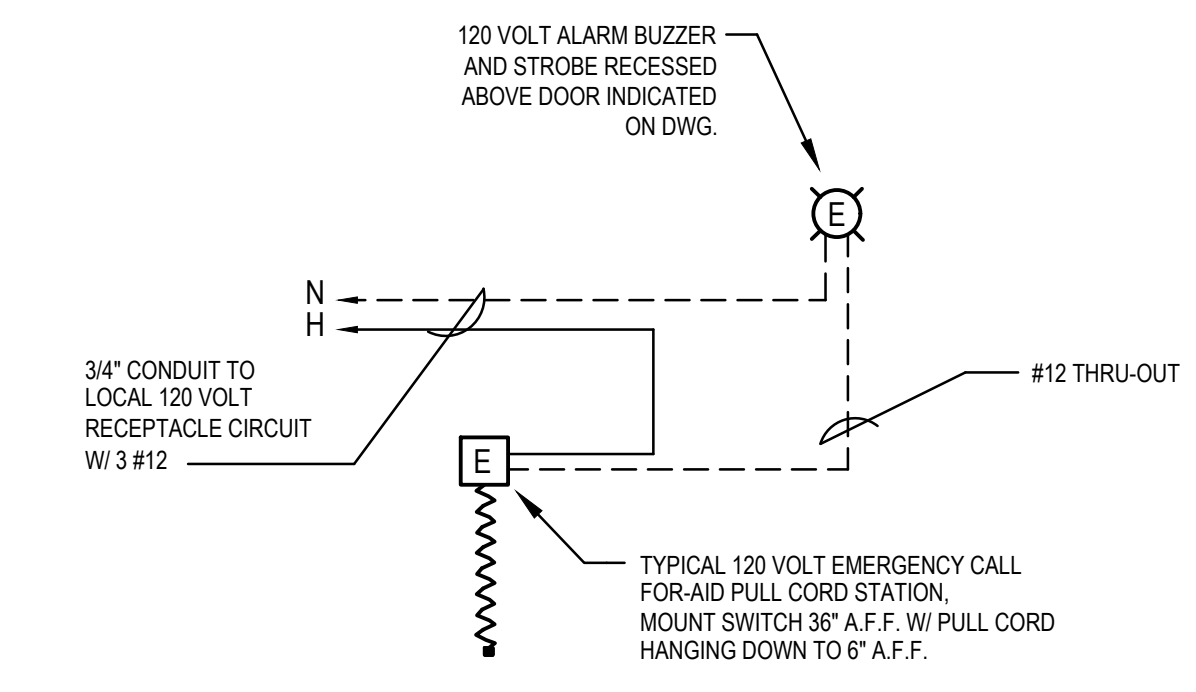

11 HANDICAPPED CALL-FOR-AID SYSTEM  
SCALE: NONE

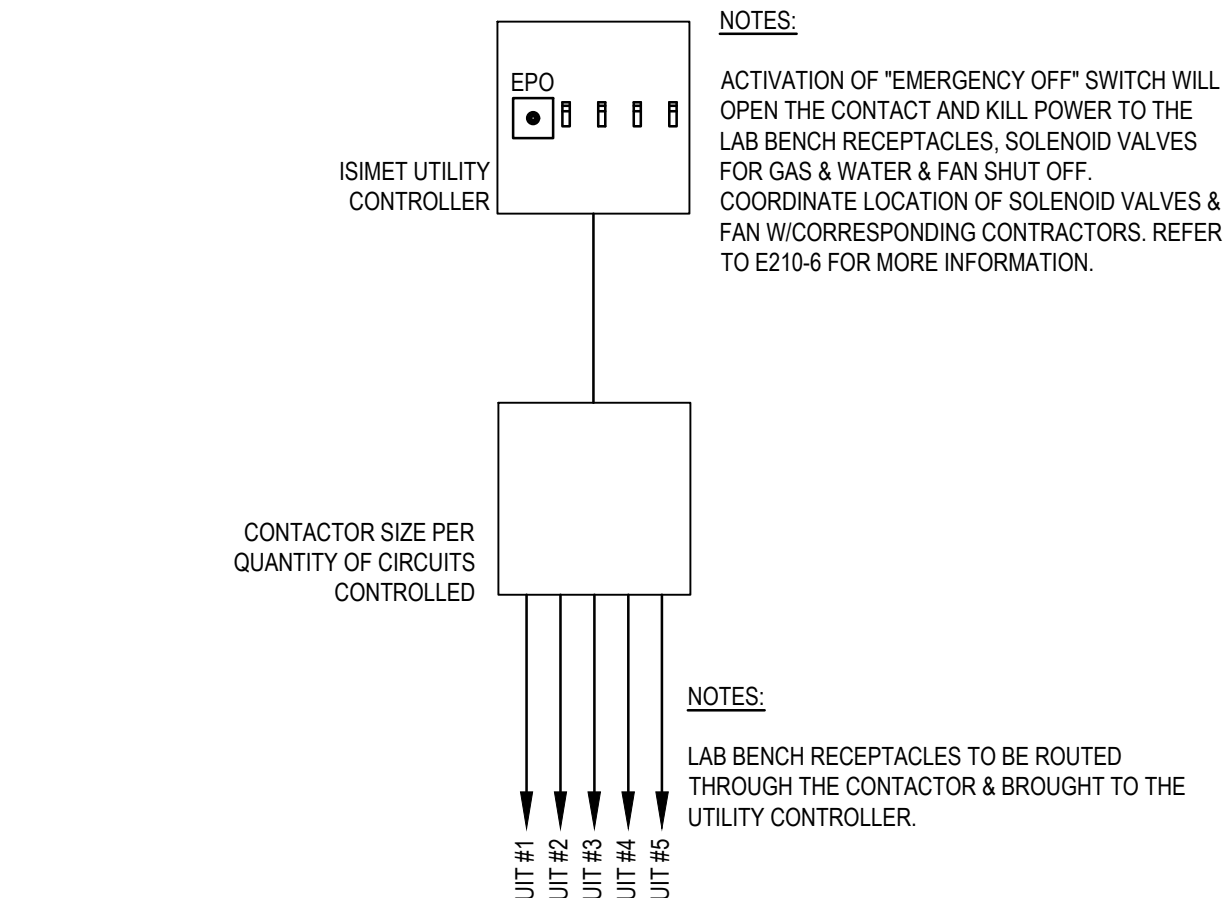

12 LAB UTC CLASSROOM E.P.O. WIRING DIAGRAM  
SCALE: NONE